


INDEX TO SURVEYS

NO.	DATE
1	APRIL 11, 1880
2	MAY 1, 1882
3	MAY 1, 1884
4	MAY 1, 1886

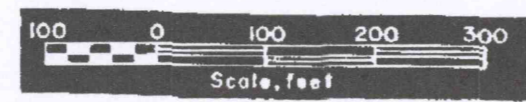

MAP SHOWING 'B' SEAM MINING OPERATIONS
OF THE
(FALLIER COAL MINING CO.)
IN THE J.C. STINEMAN EST. LEASE

SITUATE IN
CONEMAUGH TWP. CAMBRIA CO., PA.
SCALE: 1"=100' FEB. 29, 1928

A. CALVIN BALBRAITH
MINING ENGINEER
JOHNSTOWN, PA.

NOTE:
EFFECTIVE JAN. 1, 1923 - OPERATED AS NO. 9 MINE BY
TOTH AND KNECHT

342878