


1826.62

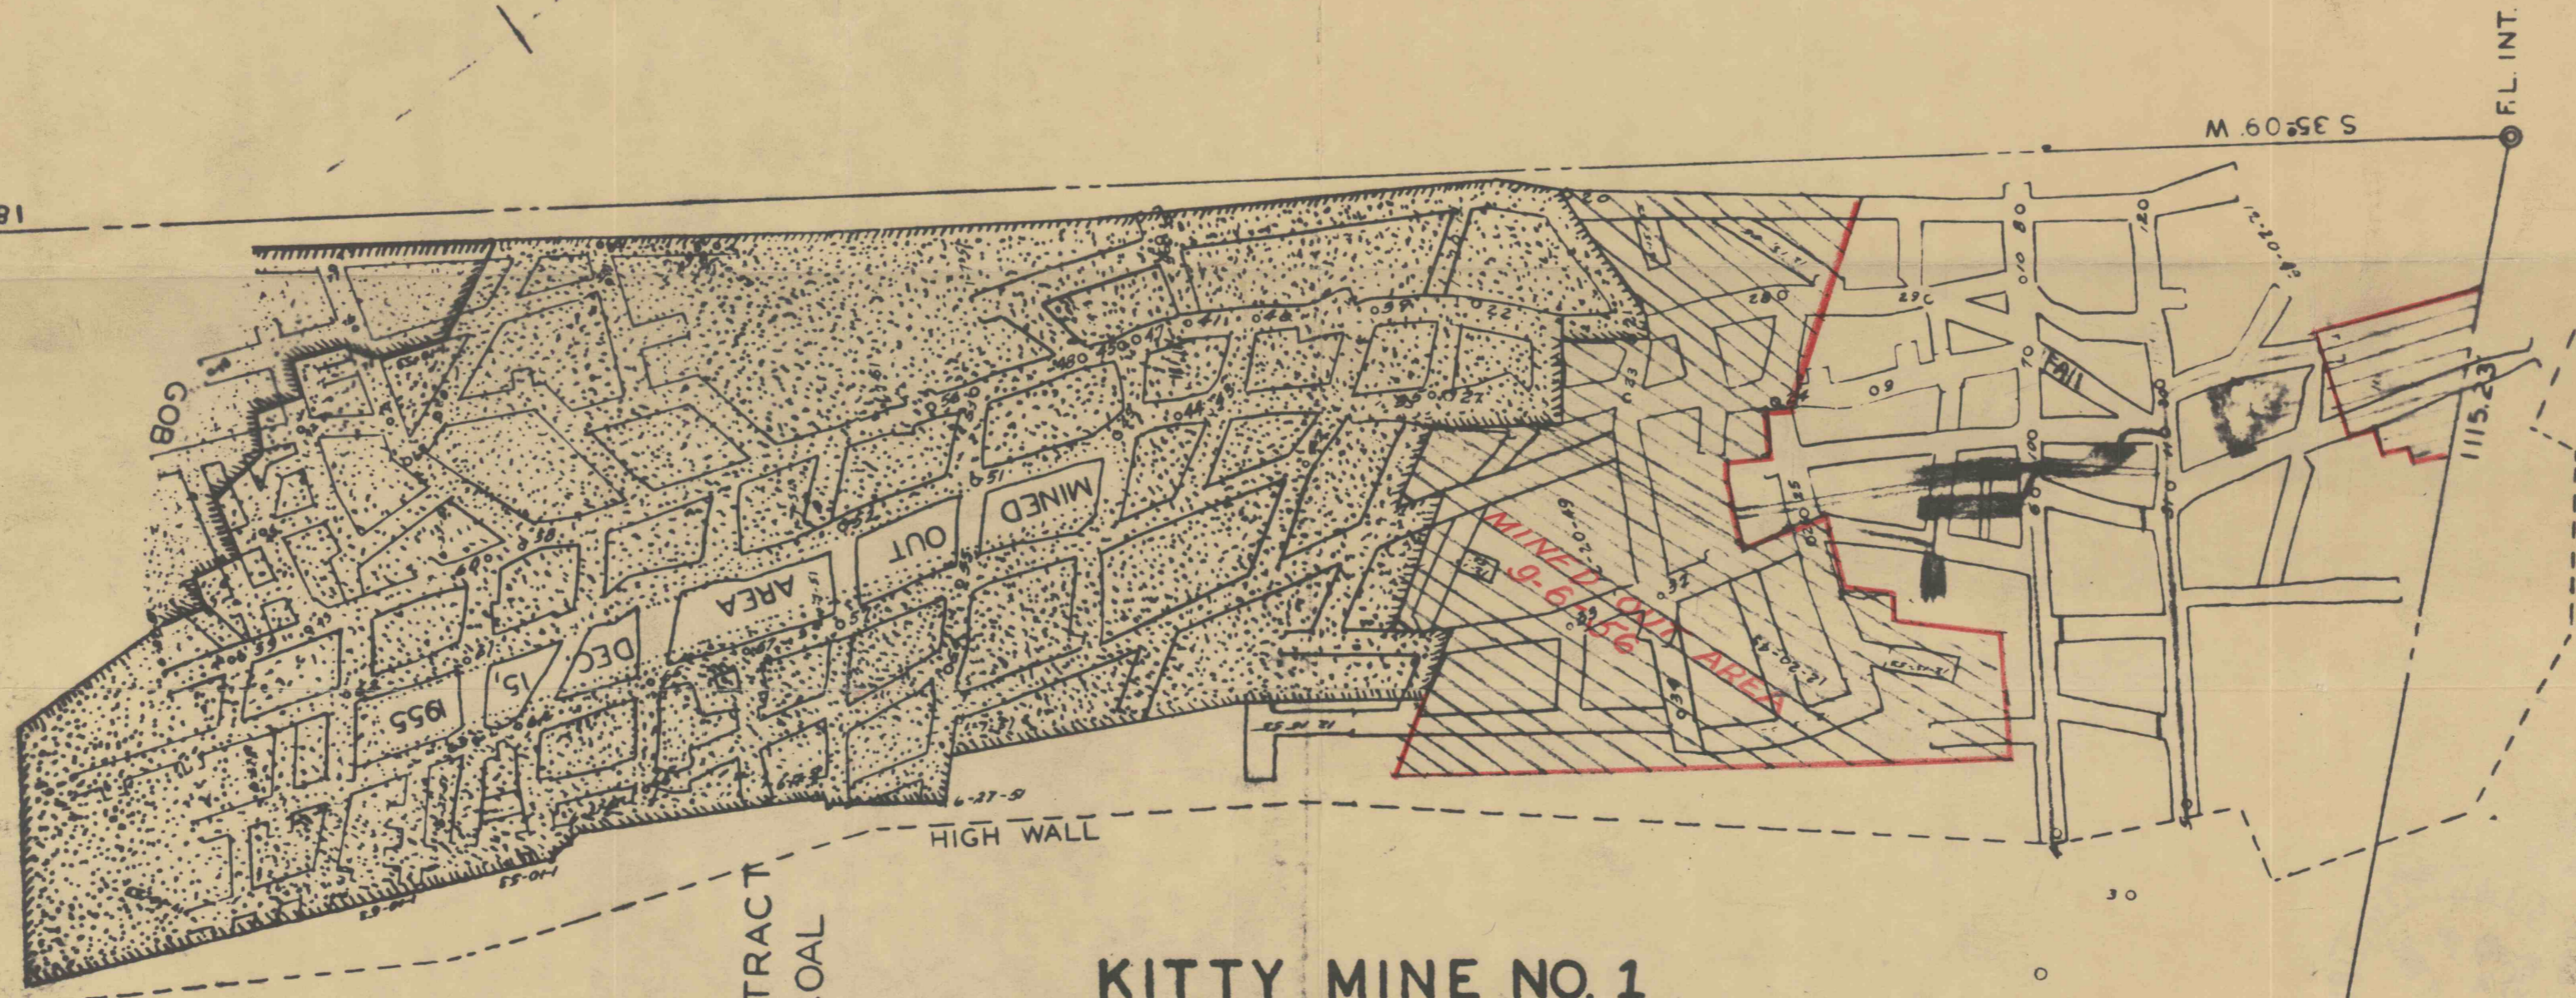

WARREN ROSS - TRAC

SURVEY DATE 9-6-56
 Albert R. Houd
 R 58572

IDA L. MILLER - TRACT
 27 ACRES COAL

**KITTY MINE NO. 1
 NICHOLSON-MARSHALL COAL CO.**

DUNKARD TOWNSHIP, GREENE CO., PA. **21-1956 ABANDONED**

SCALE 100' = 1" MARCH 6, 1956

Ernest J. Taylor Sr. #2314