

MATCH TO SHEET THREE

STRIKE N85°07'E
GENERAL DIP 2.9% GRADE
S55°07'W

RINGGOLD MINES INC.
Tract No. 1 - 167 ac.


RINGGOLD MINES INC.
Tract No. 2 - 70 ac.

Tract No. 166 ac.
RINGGOLD MINES INC.

RINGGOLD MINES INC.
Tract No. 2 - 70 ac.

Approved by Department of
Interior Mine Inspector
Director, Bureau of Mines
Mining Engineer, Bureau of Mines
Director, Bureau of Mines
Submitted by
Superintendent

John P. Babak
S. Kramer
William H. Schell
W. J. Vanally
10.22.14
W. J. Bullers

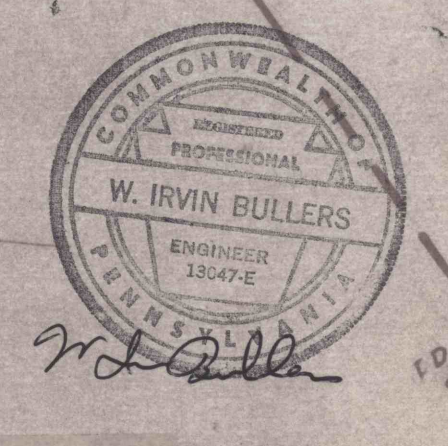

- CONTEMPLATED MINING 6-1-74 to 12-1-74
- SUPPORT AREA
- PROTECTED STRUCTURE
- MINING COMPLETED

SAFETY ZONE LIMITS


ENTRIES WITHIN SAFETY ZONE

INTAKE AIR

RETURN AIR

|| STOPPINGS

X OVERCAST

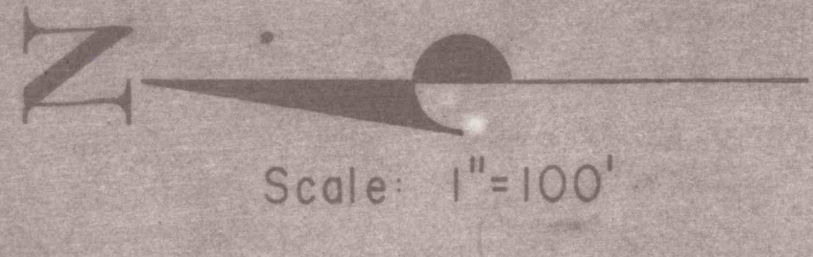

MAP of
'SUGARCAMP MINE' of DOVERSPIKE BROS.
 WEST MAHONING TWP. - INDIANA CO. - PENNA.

MATCH TO SHEET 5

SHEET 1