

COAL OWNED C&G COAL CO.

LAND C. D. BERKEBILE TRACT


CROP
LAND. BARNETT TRACT

JOSHUA BERKEBILE TRACT

LAND
VERSE TRACT

COAL
FREEMAN
BERKEBILE
TRACT

LAND AND
COAL
FREEMAN
BERKEBILE
TRACT

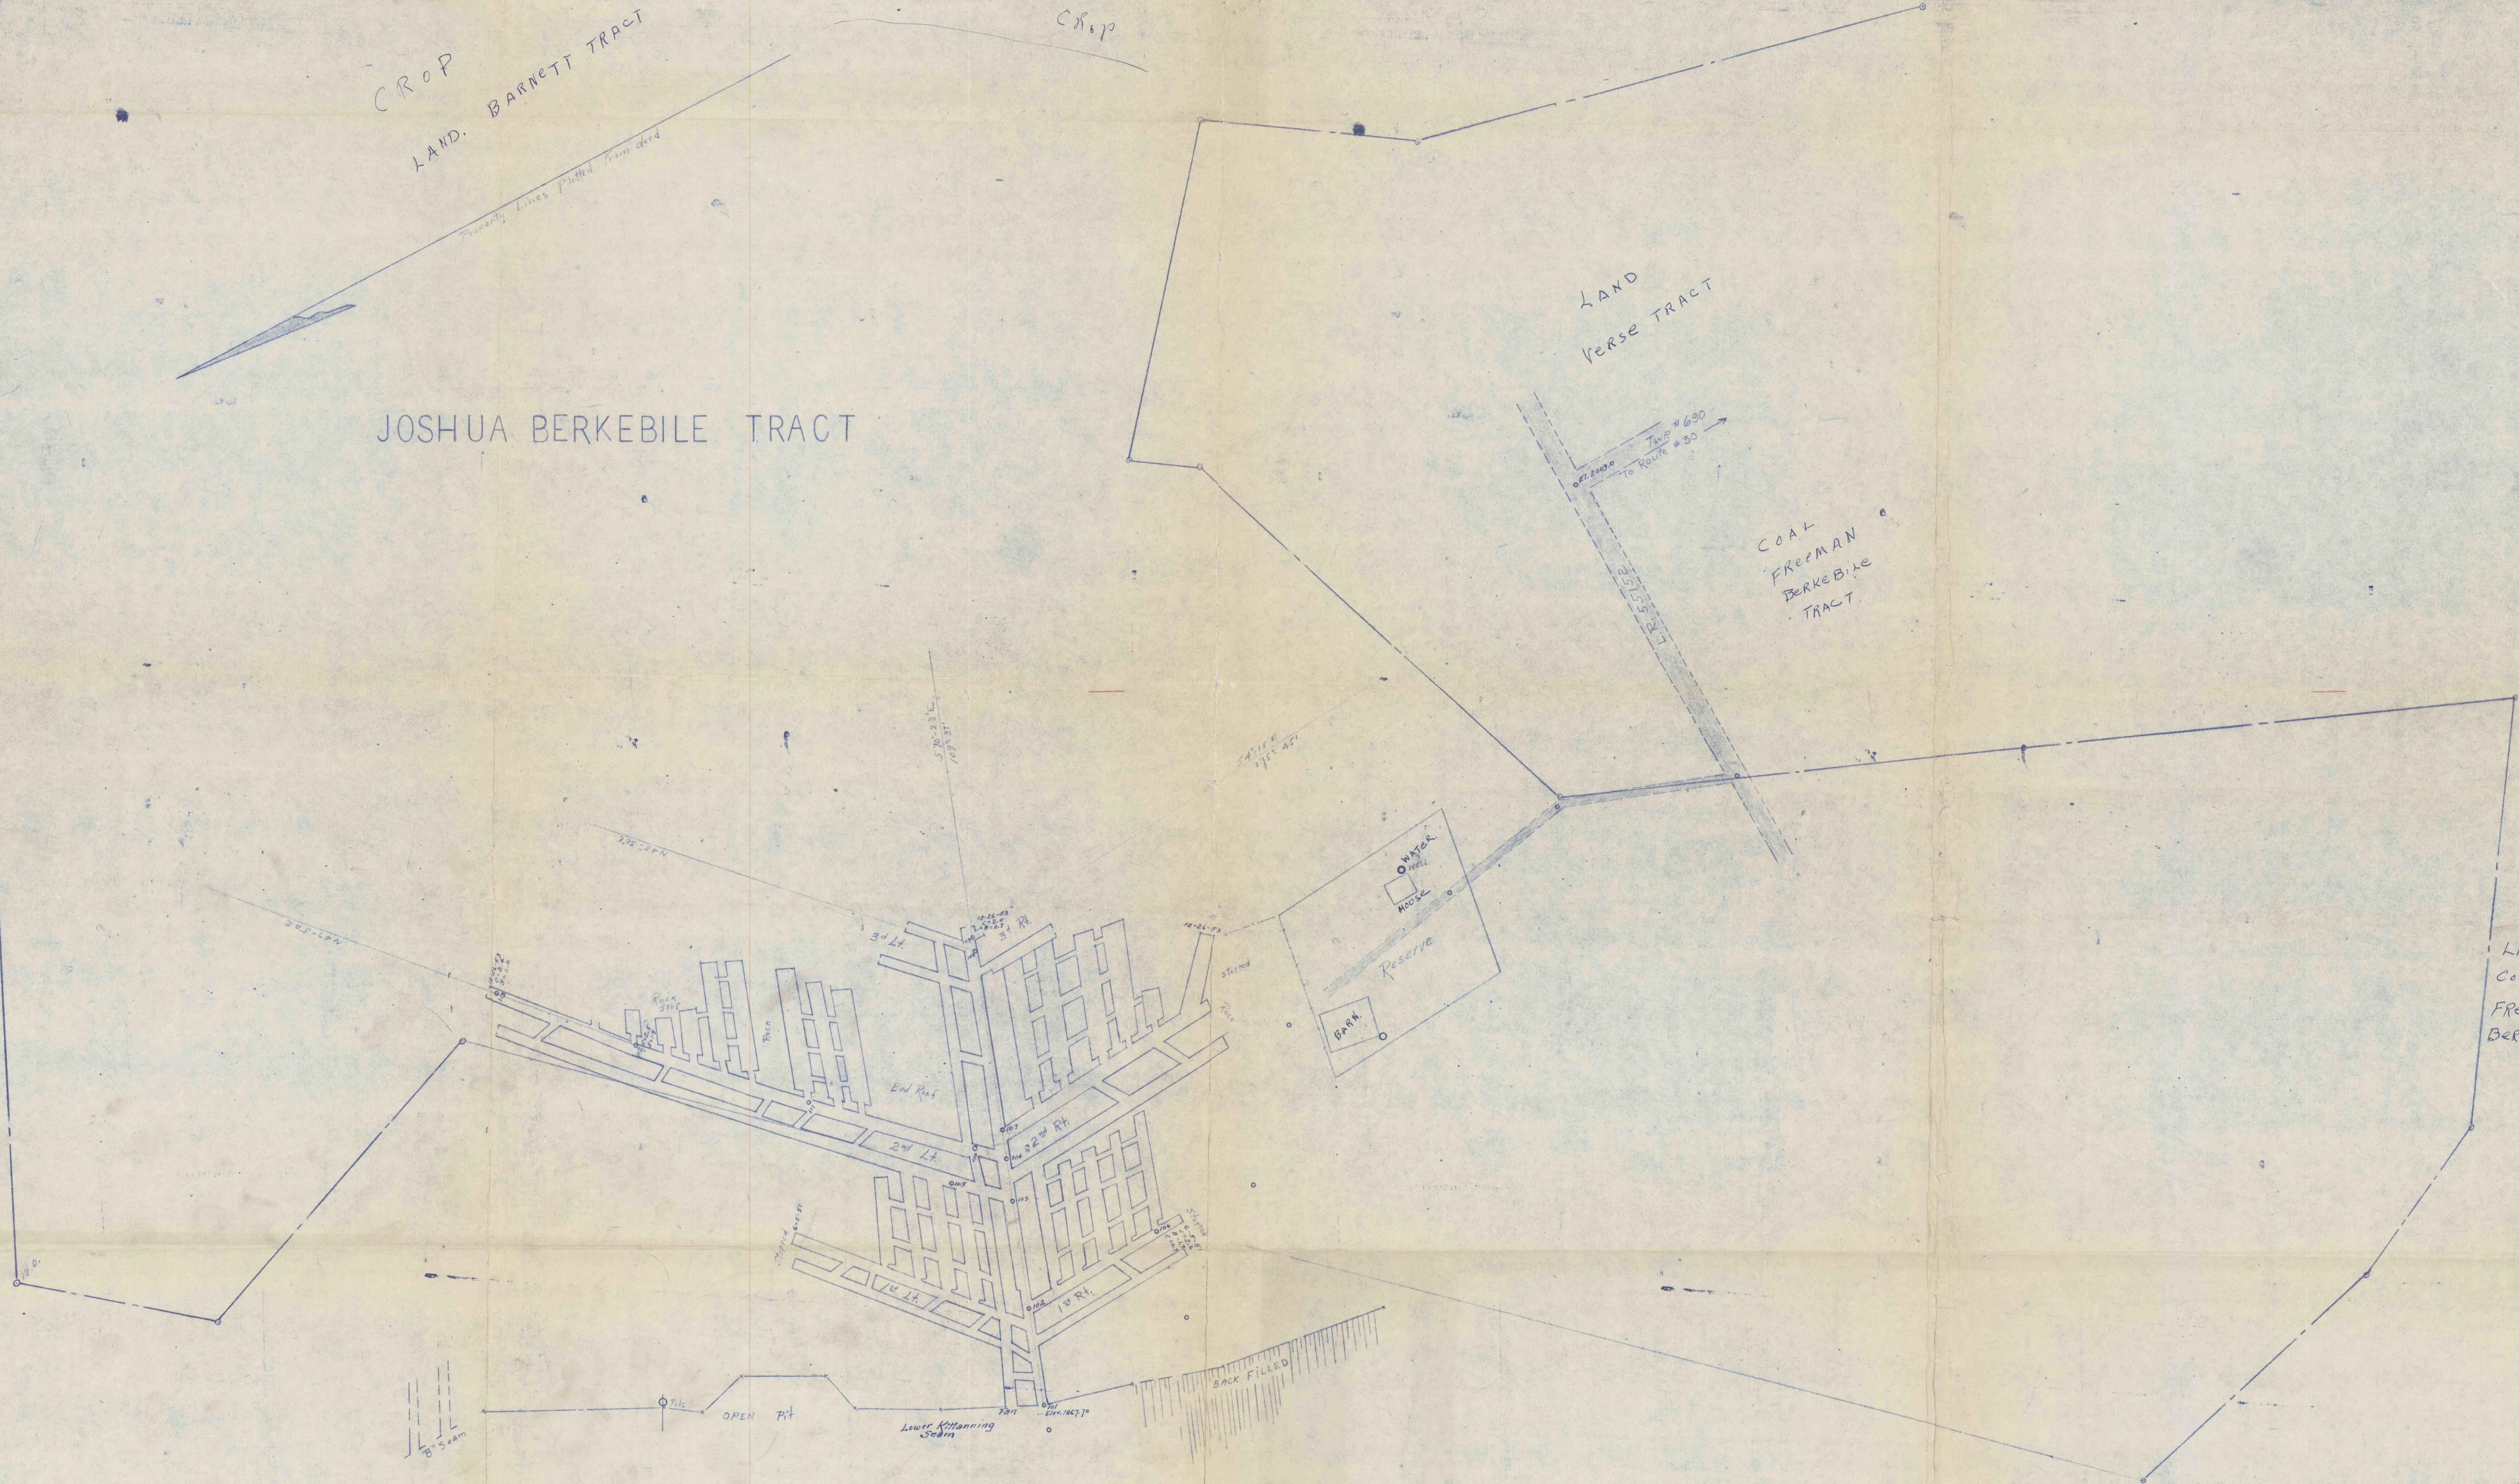

B. & B. COAL CO.	
KANTNER	PENNA.
SCALE 1" = 100'	
QUE MAHONING TWP. SOMERSET CO.	
DRAWN BY H.W. KIMMEL, R.S. DATE 1-5-55	