


CLIFFORD ISEMAN SURFACE

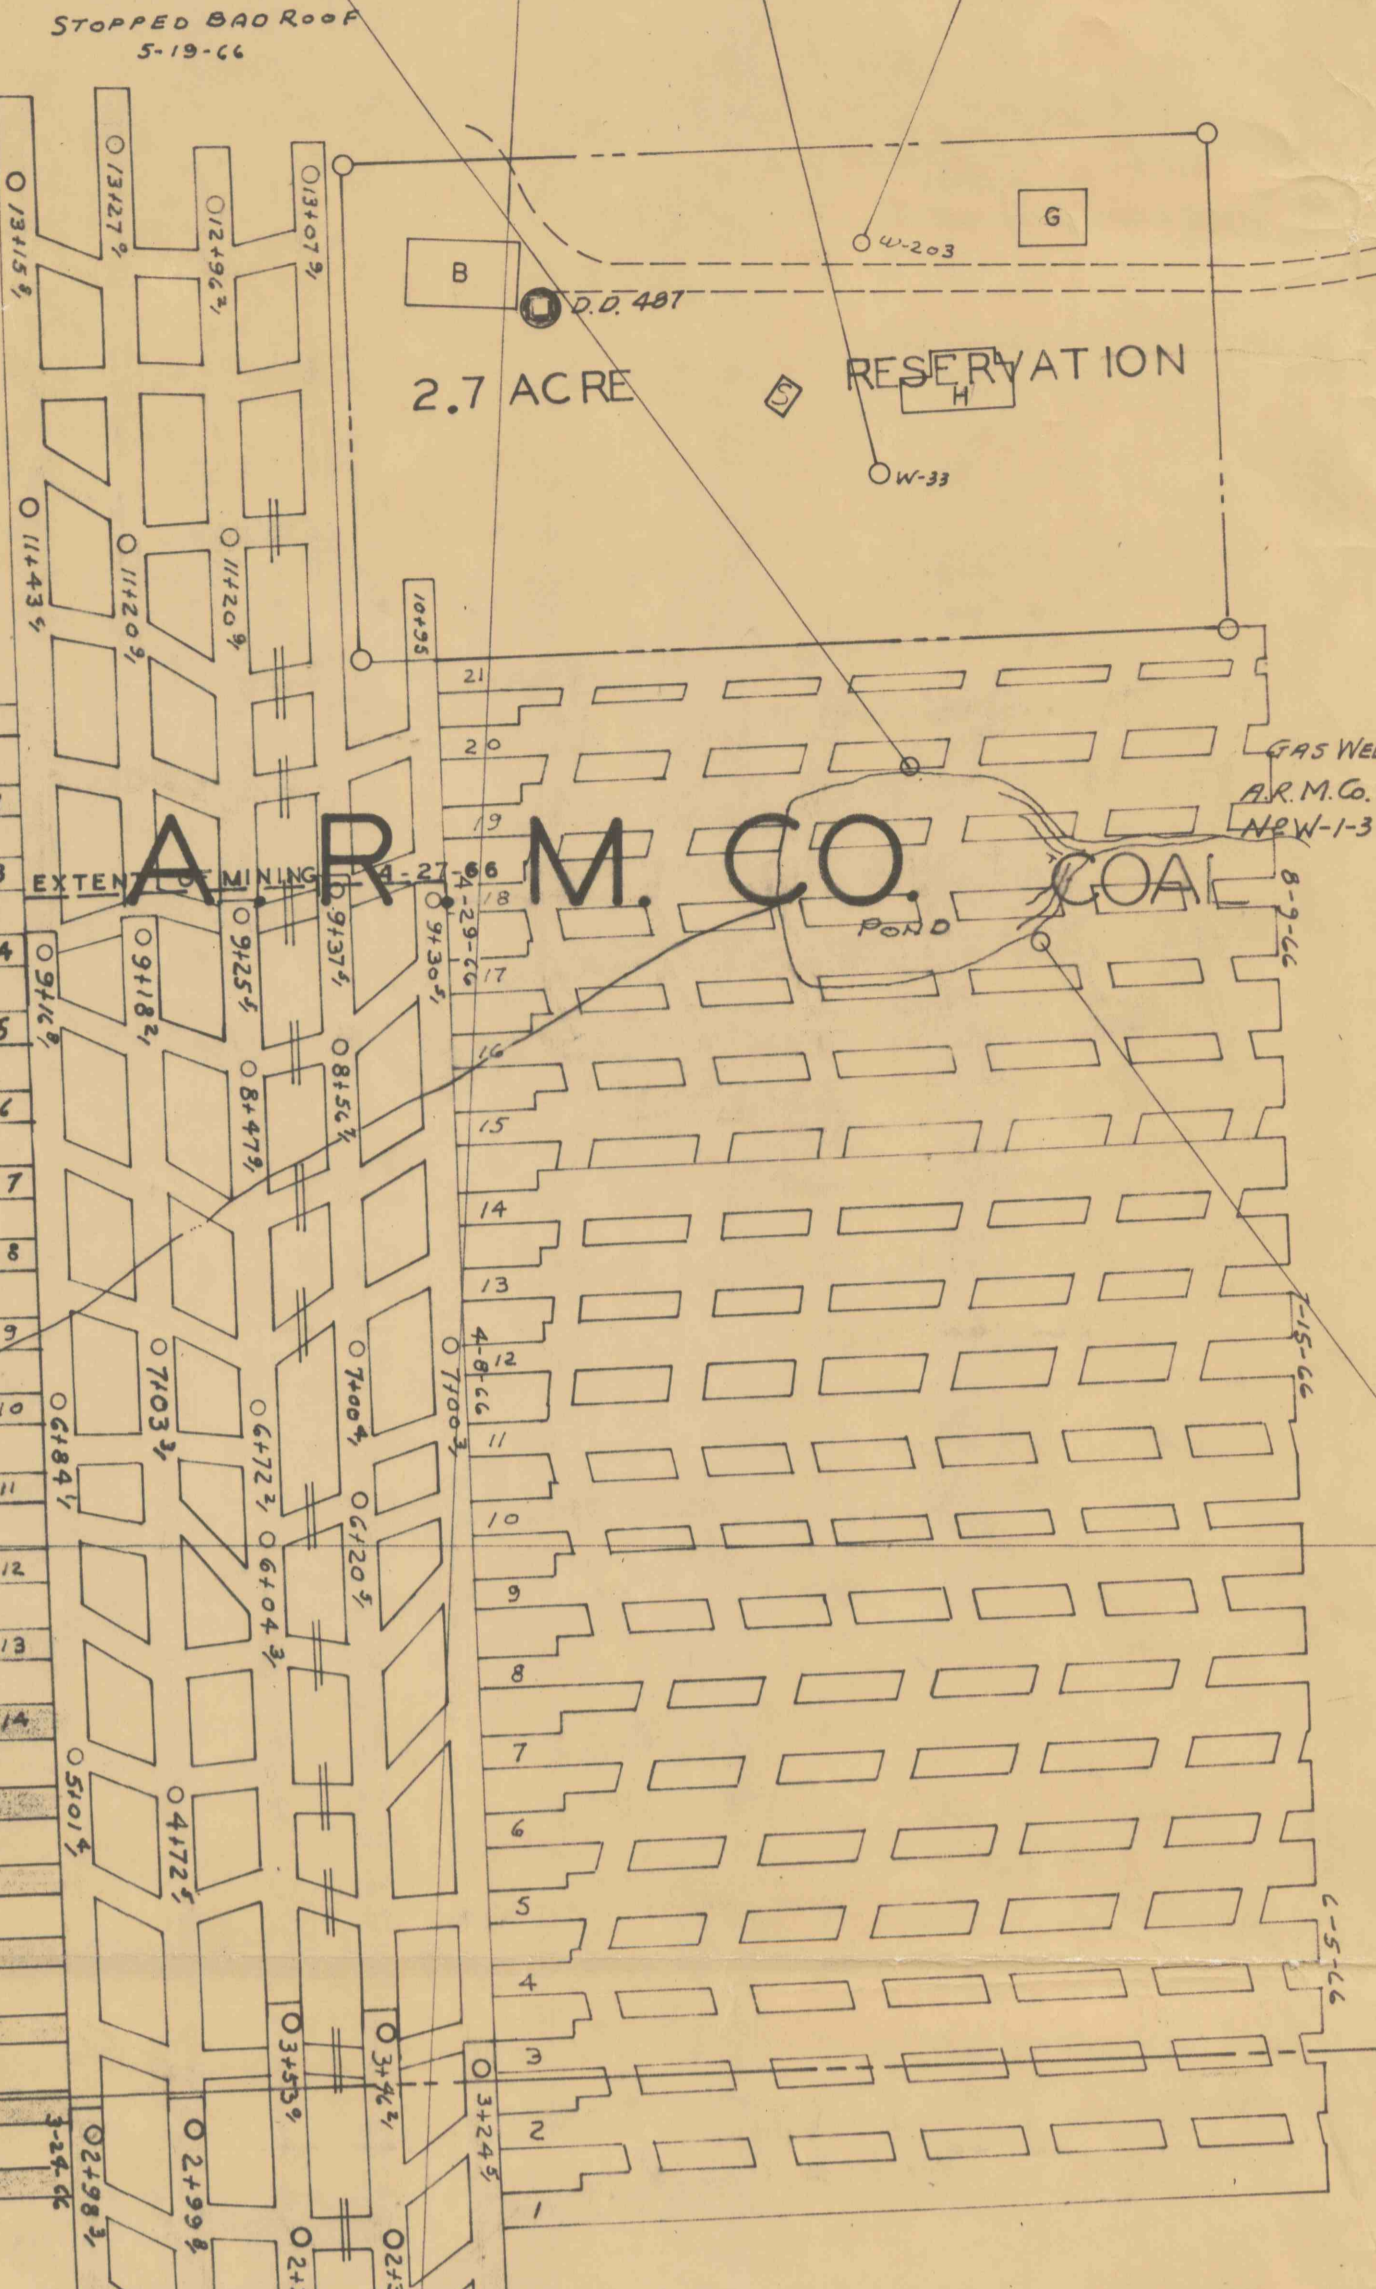

JAMES GREGORY SURFACE

A. R. M. CO. COAL

JOHN F. HECK SURFACE

A. R. M. CO. COAL

RENE NIGG SURFACE

A. R. M. CO. COAL

A. R. M. CO. FEE

SHAWMUT DEVELOPMENT CORP

FEE

ALLEGHENY RIVER MINING CO.

KITTANNING PA.

WALKER MINE PORTALS 1-2-3-4

ARMSTRONG CO. SCALE 1"=100'

AUGUST 1964.

ALLEGHENY RIVER

GAS WELL

GAS WELL

NO. 3 PORTAL

NO. 3 PORTAL

ALLEGHENY RIVER MINING CO.

SHAWMUT DEVELOPMENT CORP  
SOLID CONCRETE BLIND  
STANDARD GRADE PORTALS  
ARM. CO. WITH STRE. 287-8-44  
IN 4-10-64

VANDIVE 1/2"=1" 2-10-64

RESERVATION

A. R. M. CO. COAL

NO. 3 PORTAL HEADINGS

GAS WELL

GAS WELL

NO. 4 PORTAL

NO. 4 PORTAL

W.F. RENSLOW

ALLEGHENY RIVER MINING CO.