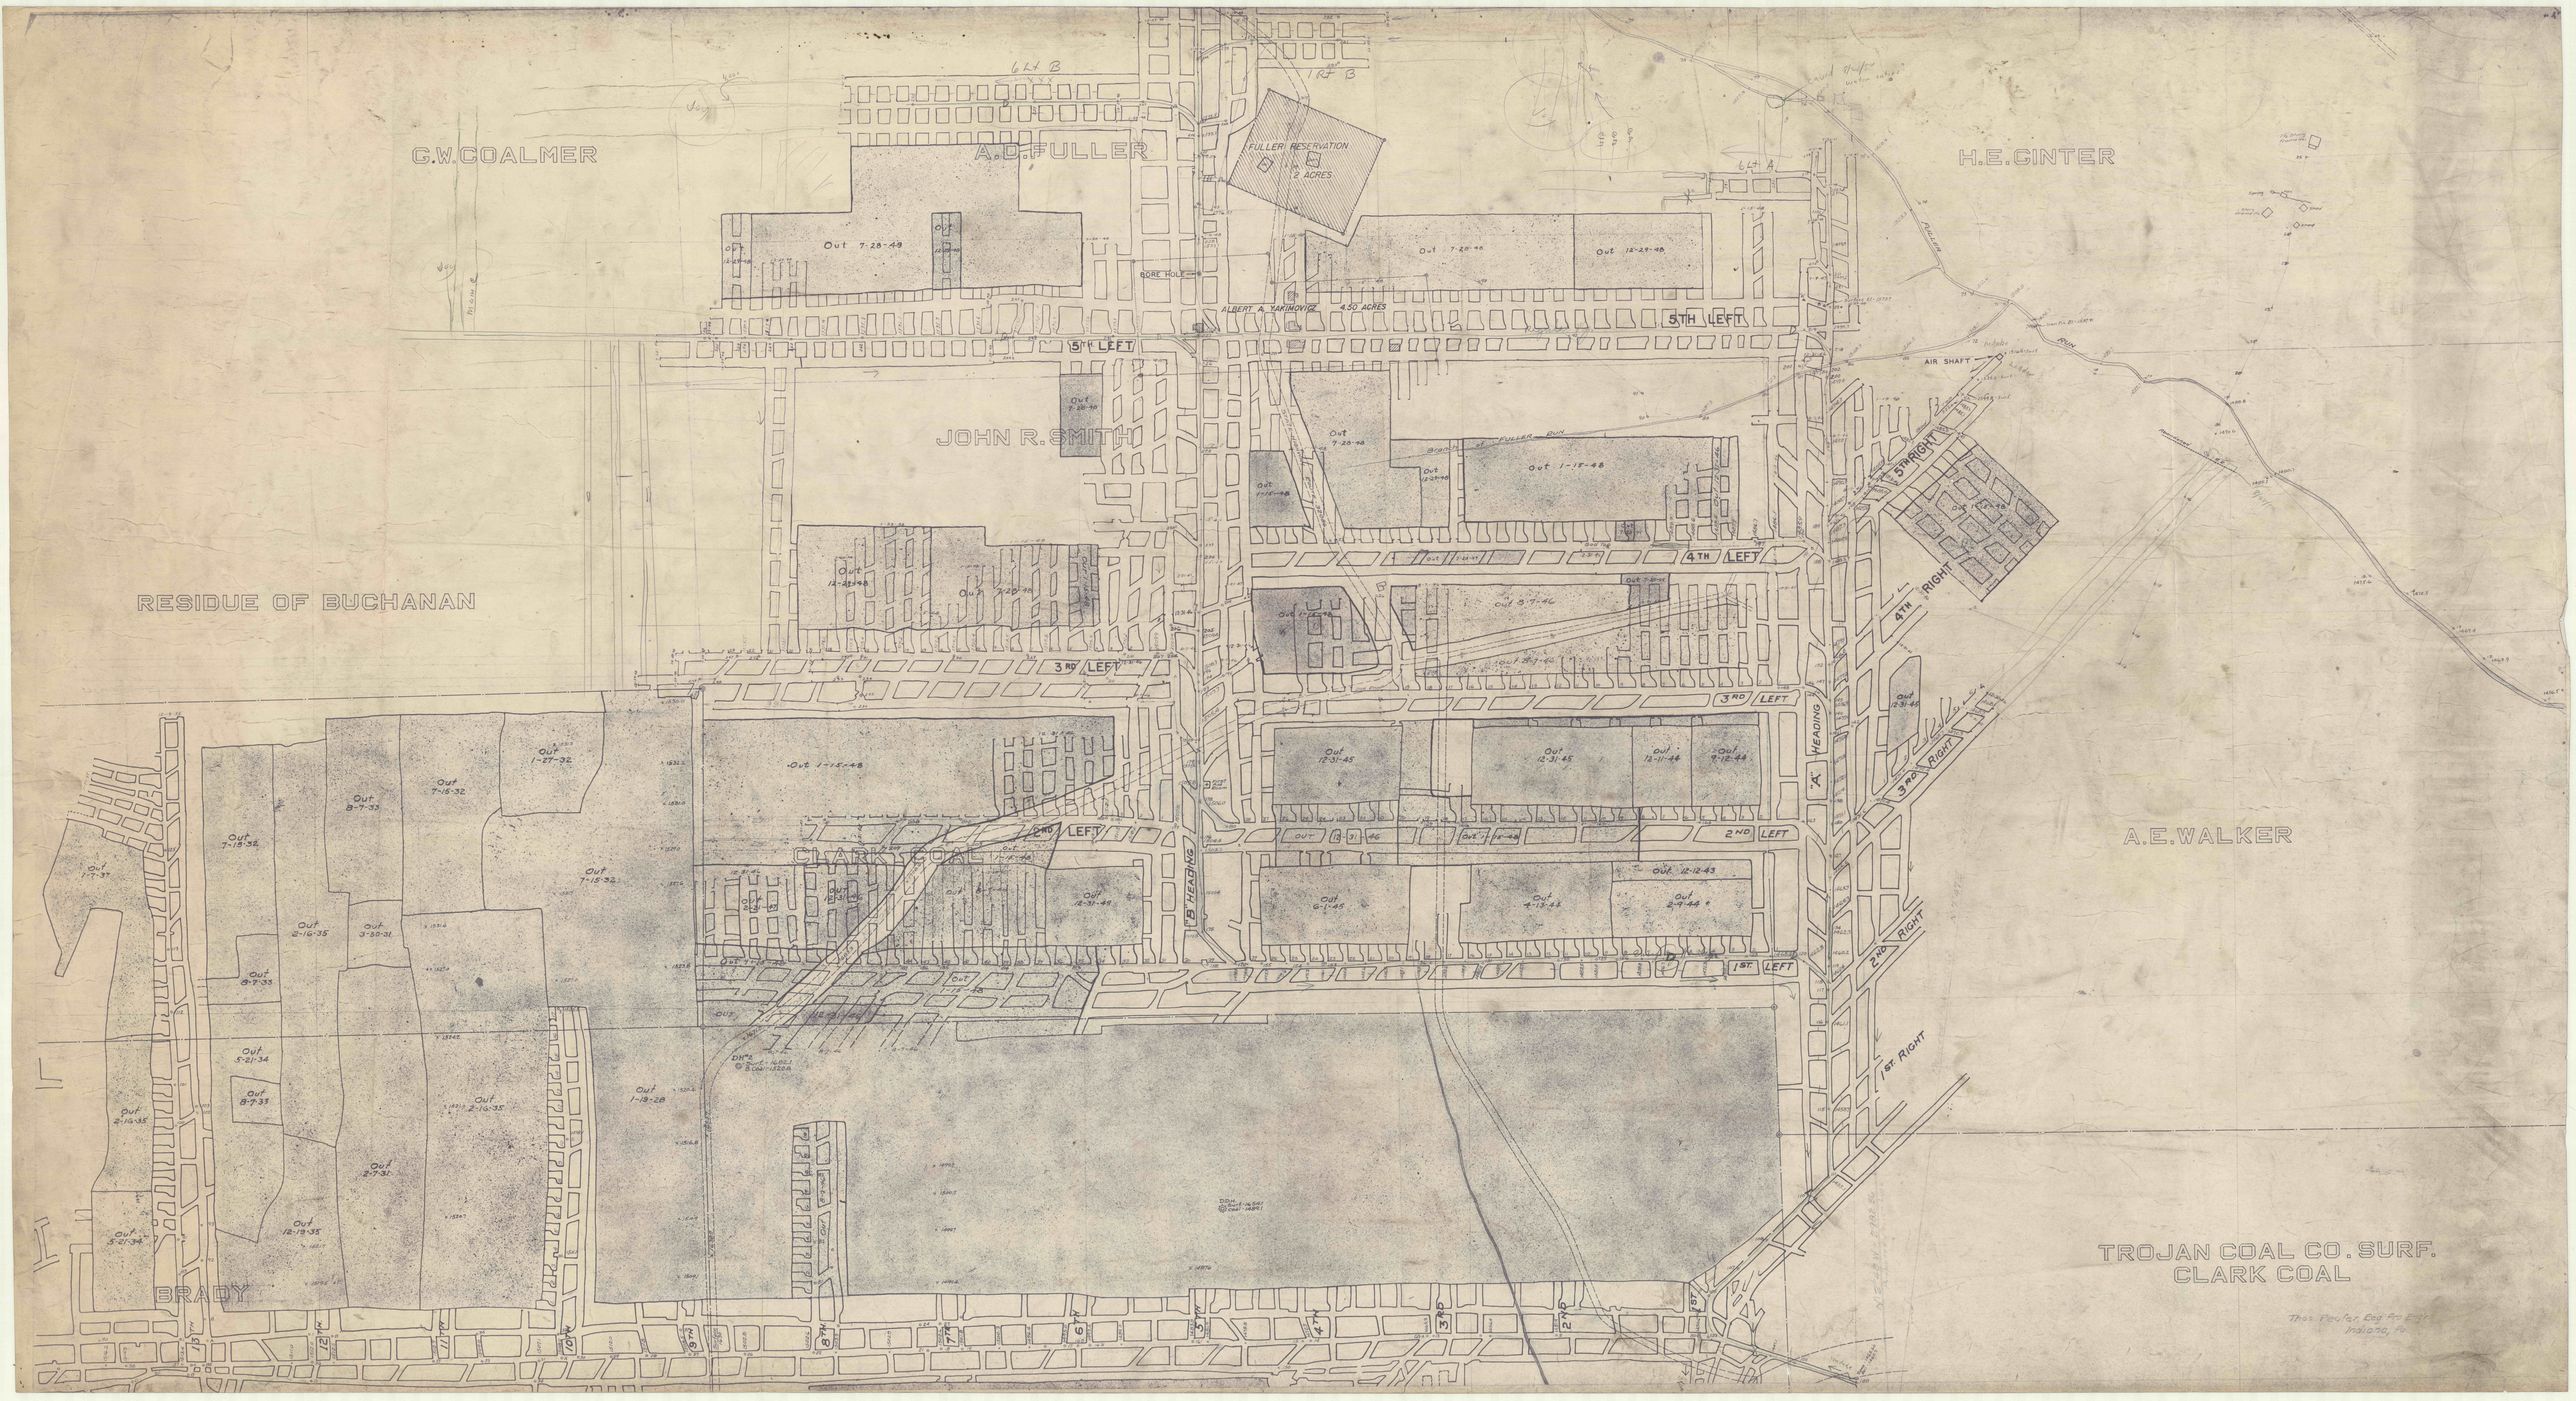
G.W. COALMER
A.D. FULLER
FULLER RESERVATION
2 ACRES
H.E. CINTER
BORE HOLE
ALBERT A. YAKIMOVICZ
4.50 ACRES
5TH LEFT
AIR SHAFT
FULLER RUN
JOHN R. SMITH
5TH RIGHT
4TH LEFT
4TH RIGHT
RESIDUE OF BUCHANAN
3RD LEFT
3RD RIGHT
"A" HEADING
"B" HEADING
2ND LEFT
2ND RIGHT
1ST LEFT
1ST RIGHT
CLARK COAL
A.E. WALKER
BRADY
TROJAN COAL CO. SURF.
CLARK COAL
Thos. Taylor Eng. & Surv.
Indiana, Pa.