


S 81° 30' E 2028.34

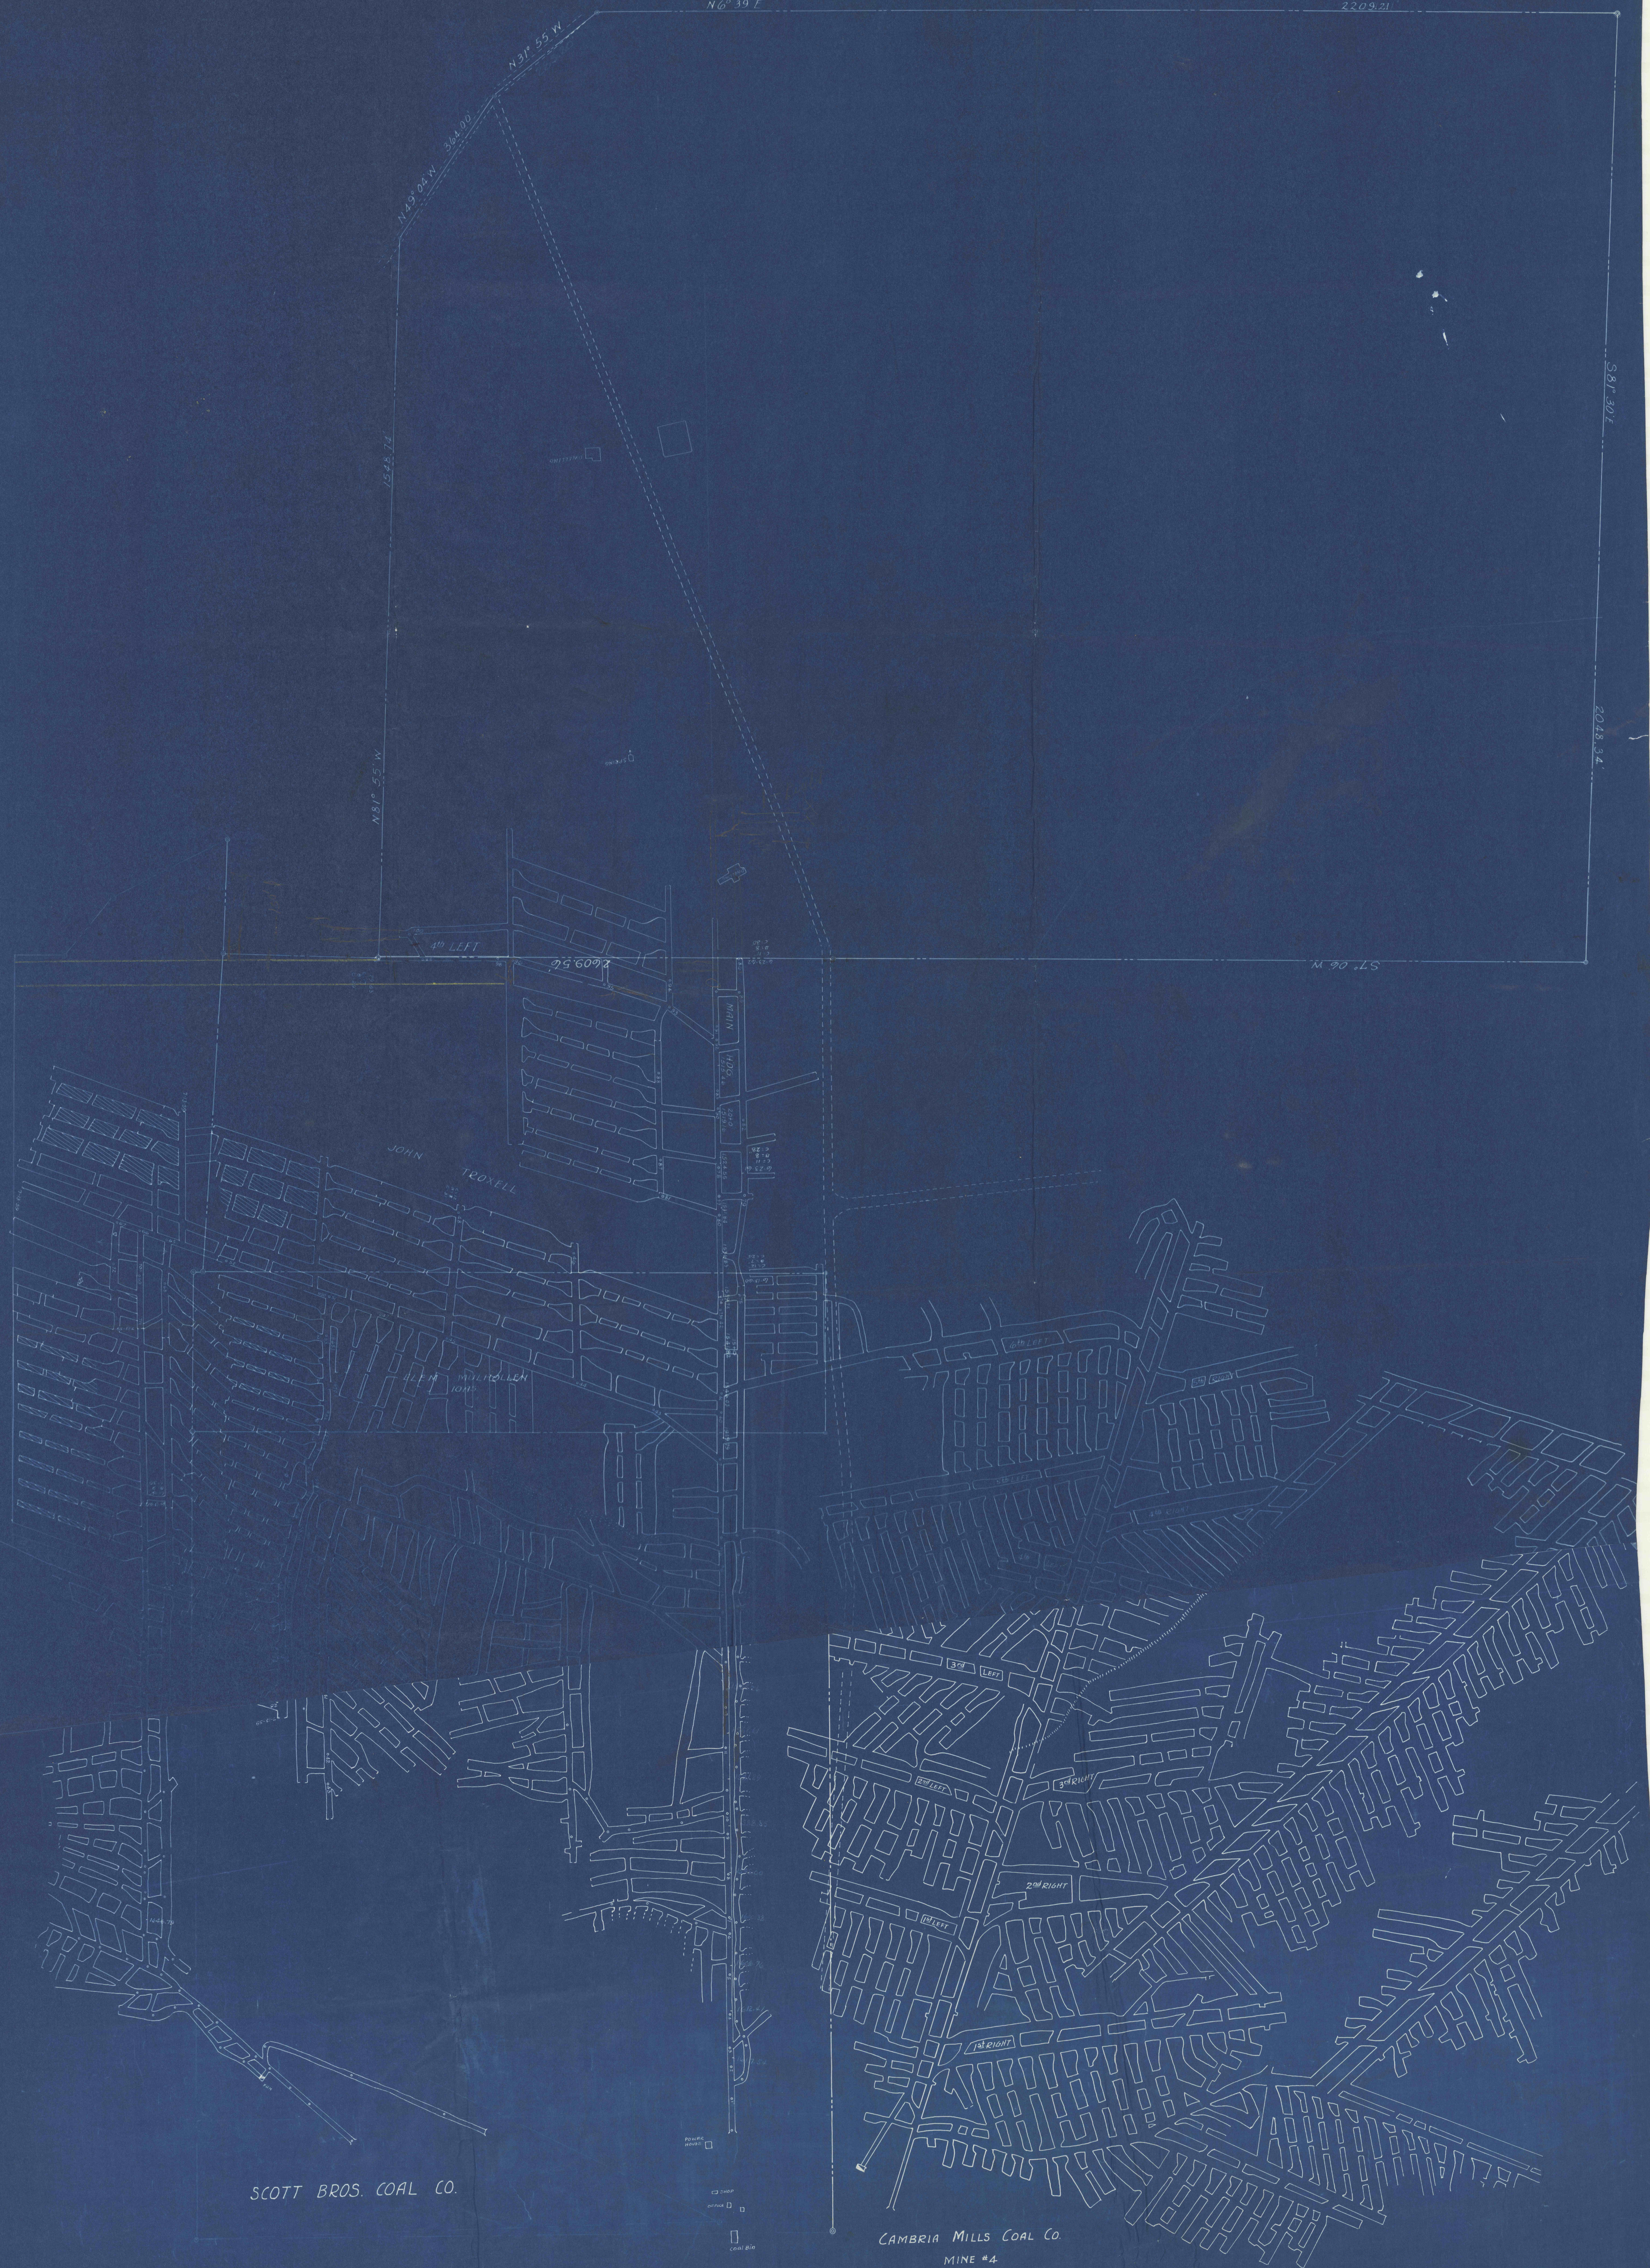

SCOTT BROS. COAL CO.

CAMBRIA MILLS COAL CO.
MINE #4

MAP
SHOWING
"B" SEAM WORKINGS
W. H. MILLER COAL CO.
READE TWP, CAMBRIA CO., PENNA.
SCALE - 1" = 100' J. L. BANFIELD REG. ENG.

MINE #4
CAMBRIA MILLS COAL CO.
SCOTT BROS. COAL CO.
9/64 W. H. MILLER COAL CO.