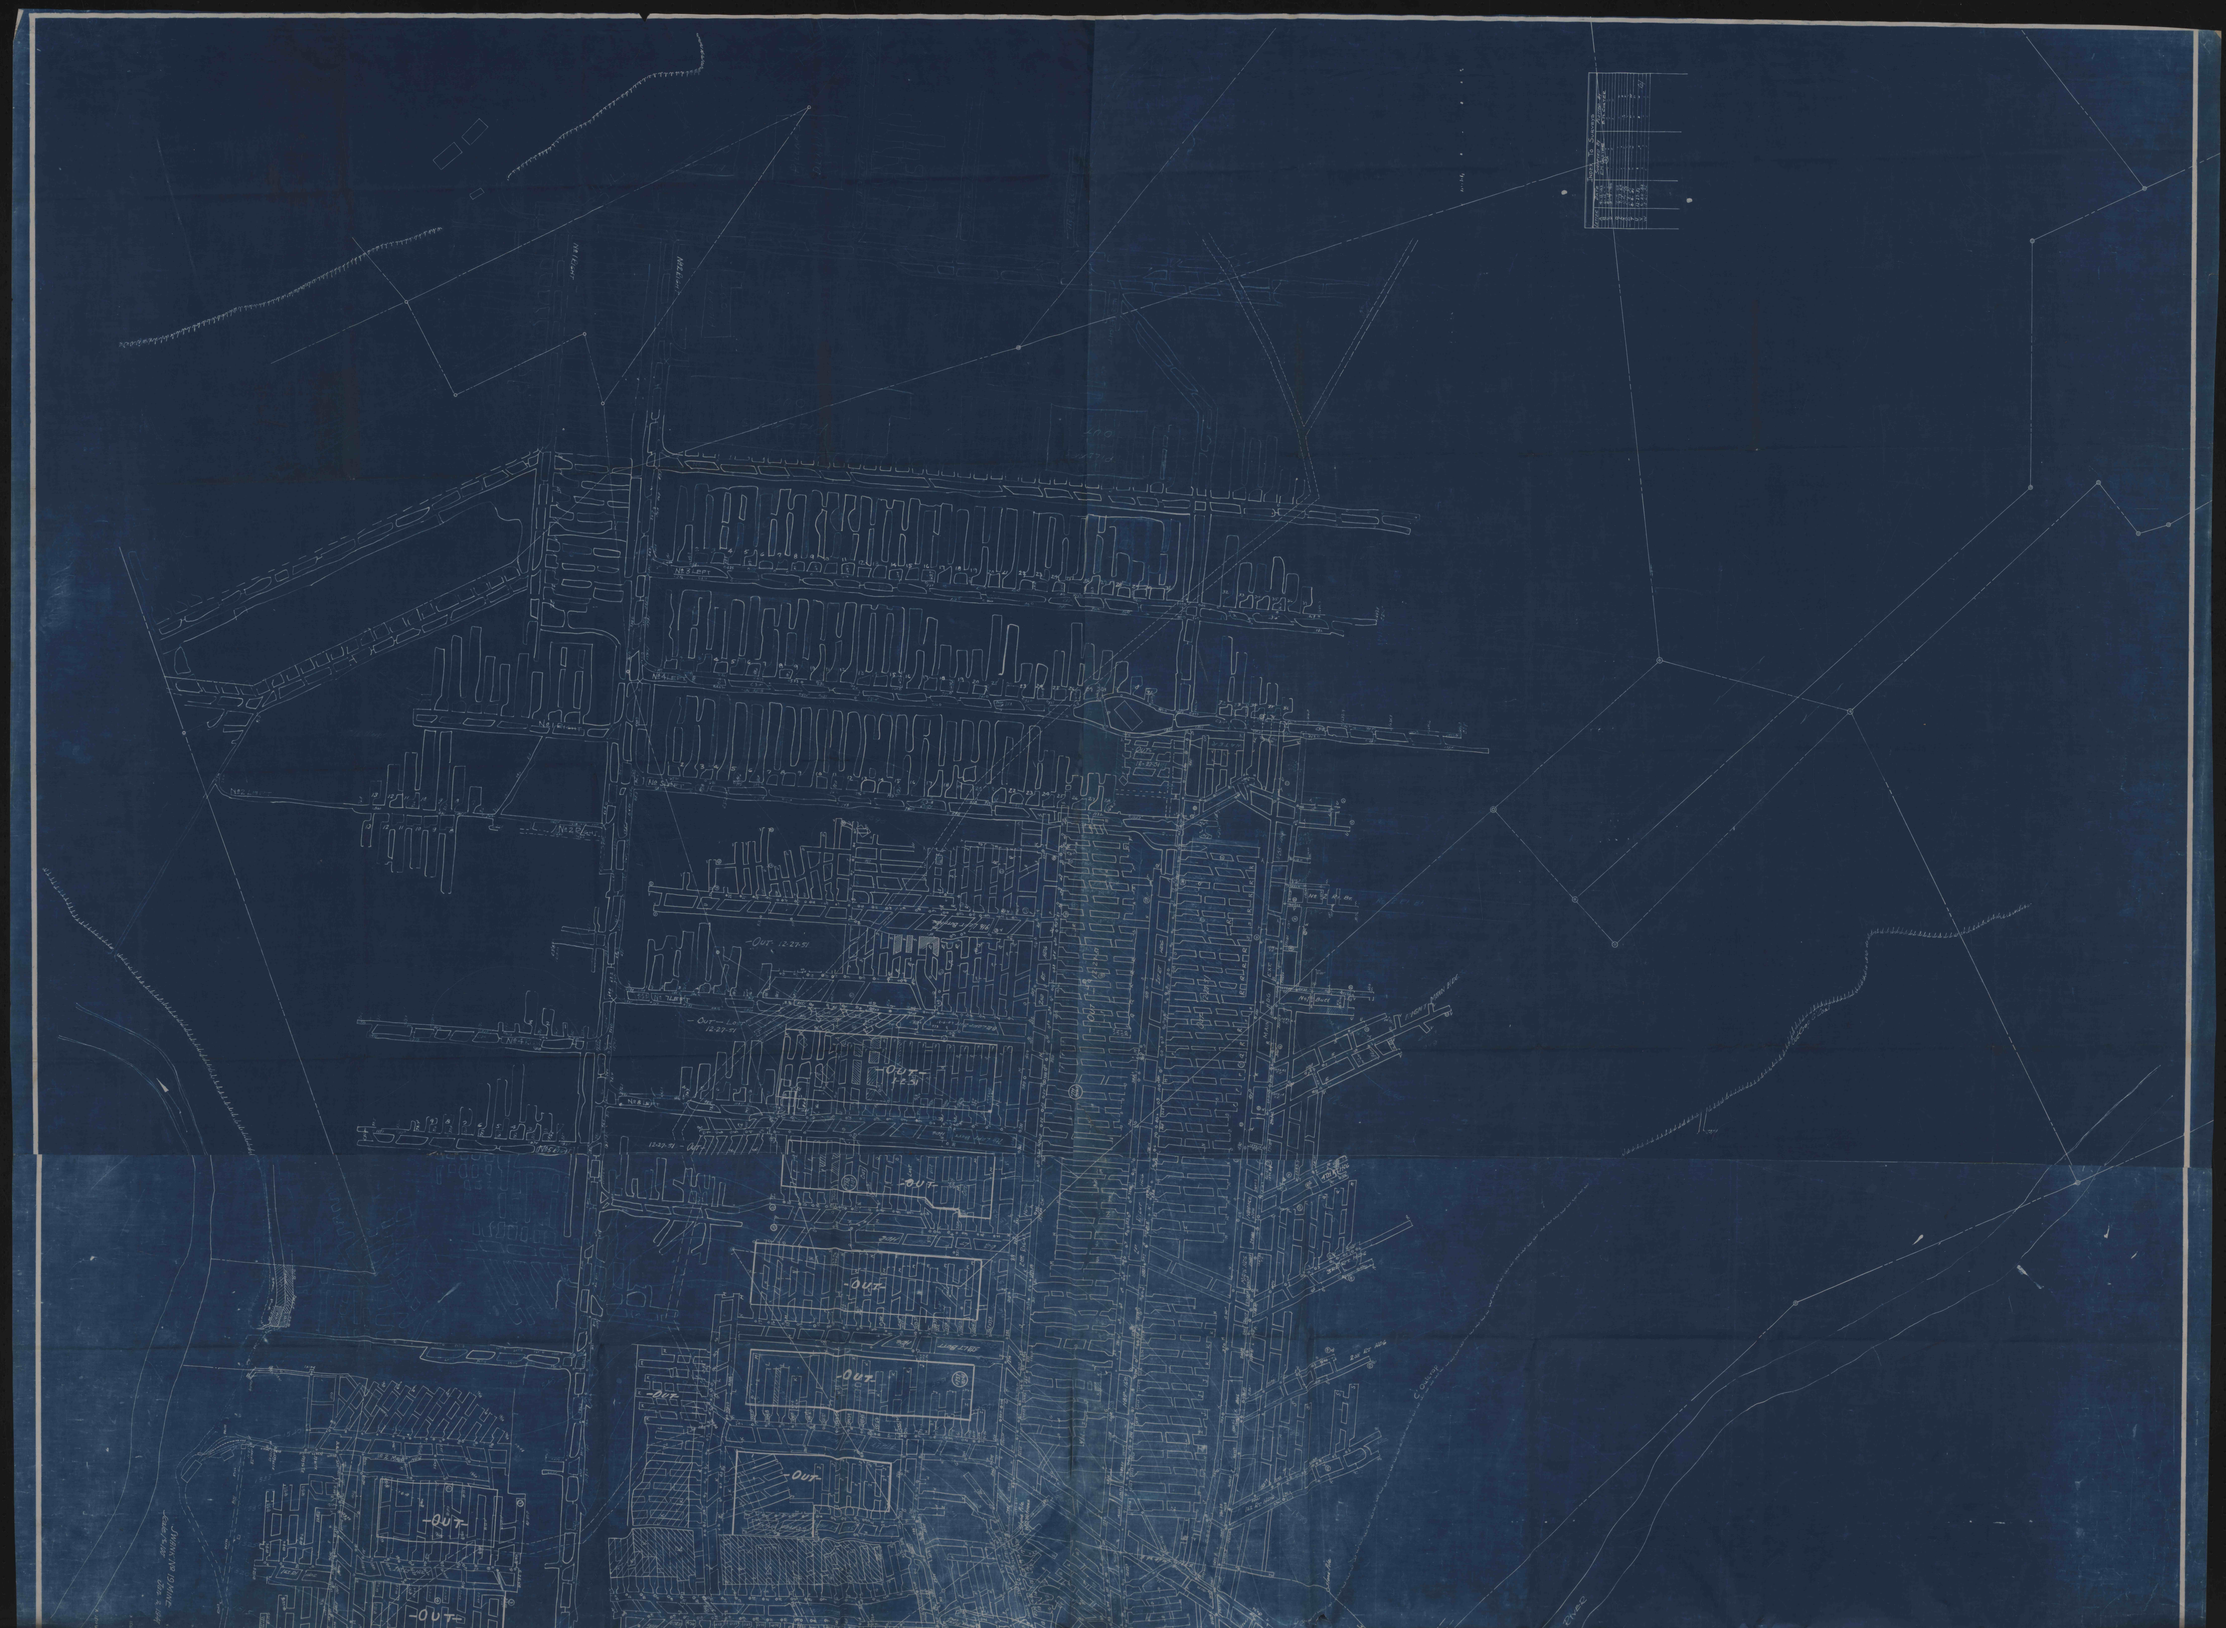
OUT
OUT
OUT
OUT
OUT
OUT
OUT
OUT