

SURFACE: BURKE, LILLEY  
SEW. COAL: LEE LAND MINERALS

MINING  
COMPLETED

MINING AREA

MINING COMPLETED

DUNKARD MINE 166

6-30-73

SURFACE: HAROLD HUNT ET UX  
SEW. COAL: HAROLD HUNT ET UX

D&M MINE  
(ABANDONED)

SURFACE AND SEWICKLEY COAL:  
IRA DONLEY


(MINED OUT)

SHEET NO. 1A

DUNKARD MINING COMPANY  
Dunkard Mine Permit No. 30841309  
Dunkard Twp.; Greene County, PA.  
Sewickley Coal Seam Scale: 1"=100'

RECEIVED  
DEC 23 1991

Dept. of Environmental Resources  
McKlure, District Office

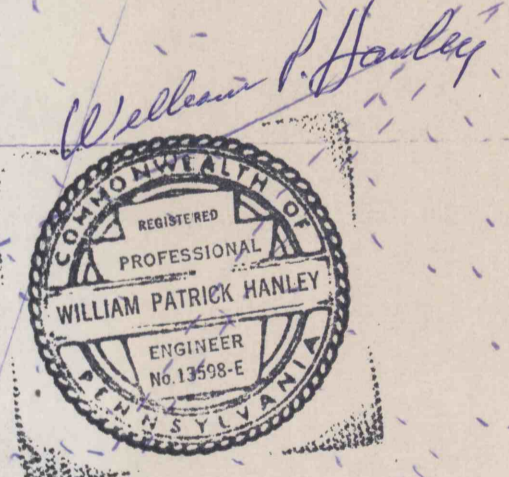

- Outline of mining property
- Outline of mining completed areas
- 1 ■ Protected surface structure (Pre-'66 house or other structure)
- 2 ■ Dwelling completed after '66 or commercial structure
- Shed, barn or abandoned house
- Protected surface structure 50% or less mining zone
- Outline of mining area for period 12-1-91 to 6-1-92
- Permanent air stoppings
- Mine air regulator
- Mine air overcast
- 123 Engineer surveying stations
- 920.0 Engineer elevation locations
- 920' Contours of bottom of coal seam
- Mining height of entry
- Air door or air lock
- Oil or gas well
- Proposed final mine seals
- Outline of No Mining area
- Outline of 5 Year Mining Plan

SHEET No. 1A

DUNKARD MINING CO.  
DUNKARD MINE NO 2-36 01301  
DUNKARD TWP. - GREENE CO - PA  
SCALE: 1"=100' SEWICKLEY SEAM

NOTE:

- 1) AREAS WITHIN 50' MINING ZONES
- 1) ENTRIES, CROSSCUTS OR PILLAR SPITS WILL BE 17.5 FEET MAXIMUM.
- 2) WHEN SPLITTING PILLAR BLOCKS, UNIFORM SUPPORT BLOCKS WILL BE LEFT.
- 3) IF THE 50% LINE TOUCHES A COAL BLOCK, THE ENTIRE BLOCK WILL BE LEFT FOR SUPPORT UPON RETREAT MINING.

NOTE:  
SUBTRACT 50 FEET FROM THE SEWICKLEY COAL ELEVATIONS SHOWN IN DUNKARD AND FRANCIS MINES TO GET SEWICKLEY COAL ELEVATIONS ABOVE SEA LEVEL.