


DUNKARD MINING COMPANY
Dunkard Mine Permit No. 30841309
Dunkard Twp.; Greene County, PA.
Sewickley Coal Seam Scale: 1"=100'

SHEET No 6
DUNKARD MINING Co
DUNKARD MINE No. 2-I.D. 36 01301
DUNKARD TOWNSHIP, GREENE COUNTY, PA
SCALE: 1"=100' SEWICKLEY SEAM

NOTE:
SUBTRACT 50 FEET FROM THE SEWICKLEY COAL ELEVATIONS
SHOWN IN DUNKARD AND FRANCIS MINES TO GET SEWICKLEY
COAL ELEVATIONS ABOVE SEA LEVEL.

- Outline of mining property
- Outline of mining completed areas
- 1 [Symbol] Protected surface structure (Pre-'66 house or other structure)
- 2 [Symbol] Dwelling completed after '66 or commercial structure
- 3 [Symbol] Shed, barn or abandoned house
- [Symbol] Protected surface structure 50% or less mining zone
- [Symbol] Outline of mining area for period 07-9-70 6-1-72
- [Symbol] Permanent air stoppings
- [Symbol] Mine air regulator
- [Symbol] Mine air overcast
- 133 [Symbol] Engineer surveying stations
- 920.0 [Symbol] Engineer elevation locations
- 920' [Symbol] Contours of bottom of coal seam
- [Symbol] Mining height of entry
- [Symbol] Air door or air lock
- [Symbol] Oil or gas well
- [Symbol] Proposed final mine seals
- [Symbol] Outline of No Mining area
- [Symbol] Outline of 5 Year Mining Plan

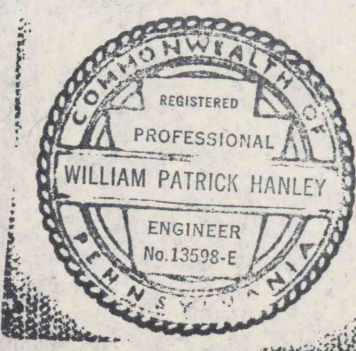

RECEIVED
DEC 23 1991

Dept. of Environmental Resources
McMurry District Office

Sewickley Coal: CONSOL COAL CO

WEST VIRGINIA
PENNSYLVANIA

50' PROPERTY BARRIER

SURFACE: CONSOL COAL CO
SEW. COAL: DUNKARD MNG CO

SURFACE: CONSOL COAL CO.
SEW. COAL: CONSOL COAL CO



SURFACE: J. DALE BRAND
SEW. COAL: CONSOL COAL CO

SURFACE: RAY F. LEE
SEW. COAL: DUNKARD MNG CO
4 WEST

SURFACE: D. E. MARTIN
SEW. COAL: RAY CHES

50' PROPERTY BARRIER

5 YEAR MINING PLAN OUTLINE

