

SURFACE: BURREY LILLY
SEW. COAL: LEE LAND MINERALS

SURFACE: HAROLD HUNT ET UX
SEW. COAL: HAROLD HUNT ET UX


D & M MINE
(ABANDONED)

SURFACE AND SEWICKLEY COAL:
IRA DONLEY

(MINED OUT)

- MINE MAP LEGEND:**
- Mine Property Outline
 - Conveyor Belt
 - Mine Track
 - Feeder Cable or Trolley Line
 - Intake Air Escapeway
 - Alternate Escapeway
 - Intake Air
 - Return Air
 - Permanent Air Stoppings
 - Permanent Air Stoppings With Door
 - Mine Air Regulator
 - Mine Air Overcast
 - Temporary Air Check
 - Fire Retardant Line Curtain
 - Engineer Surveying Stations
 - Bottom Sewickley Coal Elevation Contours
 - Mining Height
 - Door
 - Bleeder Evaluation Point
 - Belt Transfer Point
 - CO Monitoring Point

1. There are two production sections in the mine.
2. All permanent air stoppings, overcasts and man-doors made of non-combustible material.
3. All temporary air checks and line curtains are made of fire retardant materials.
4. The Pittsburgh Seam 120 feet below has been partially mined by the Shannopin Mine.

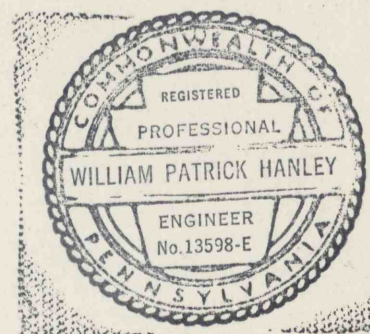

William R. Hanley

SHEET No. 1A

DUNKARD MINING CO.

DUNKARD MINE No 2-36 01301

DUNKARD TWP. - GREENE CO. - PA

SCALE: 1" = 100' SEWICKLEY SEAM

NOTE:

SUBTRACT 50 FEET FROM THE SEWICKLEY COAL ELEVATIONS SHOWN IN DUNKARD AND FRANCIS MINES TO GET SEWICKLEY COAL ELEVATIONS ABOVE SEA LEVEL.

NOTE:

AREAS WITHIN 50' MINING ZONE

- 1) ENTRIES, CROSSCUTS OR PILLAR SPTS WILL BE 7.5 FEET MAXIMUM.
- 2) WHEN SPLITTING PILLAR BACKS UNIFORM SUPPORT CYCLES WILL BE LEFT.
- 3) IF THE 50' LINE TOUCHES A LONG BLOCK THE ENTIRE BLOCK WILL BE LEFT FOR SUPPORT UPON RETREAT MINING.

