

E32 E37 E36 E35

MONONGAHEIA COUNTY - WEST VIRGINIA  
GREENE COUNTY - PENNSYLVANIA

**MINE MAP LEGEND:**

- Mine Property Outline
- Conveyor Belt
- Mine Track
- Feeder Cable or Trolley Line
- Intake Air Escapeway
- Alternate Escapeway
- Intake Air
- Return Air
- Permanent Air Stoppings
- Permanent Air Stoppings With Door
- Mine Air Regulator
- Mine Air Overcast
- Temporary Air Check
- Fire Retardant Line Curtain
- Engineer Surveying Stations
- Bottom Sewickley Coal Elevation Contours
- Mining Height
- Door
- Bleeder Evaluation Point
- Belt Transfer Point
- CO Monitoring Point

1. There are two production sections in the mine.
2. All permanent air stoppings, overcasts and man-doors made of non-combustible material.
3. All temporary air checks and line curtains are made of fire retardant materials.
4. The Pittsburgh Seam 120 feet below has been partially mined by the Shanopin Mine.



William P. Hanley

CROOKED RUN



SURFACE: HERSCHEL MATHews  
SEW. COAL: COLFARDE CORP

**NOTES: AREAS WITHIN 50' MINING ZONES**

- 1) ENTRIES, CROSSCUTS OR PILLAR SPLITS WILL BE 17.5 FEET WIDE MAXIMUM.
- 2) WHEN SPLITTING PILLAR BLOCKS, UNIFORM SUPPORT BLOCKS WILL BE LEFT.
- 3) IF THE 50' LINE TOUCHES A COAL BLOCK THE ENTIRE BLOCK WILL BE LEFT FOR SUPPORT UPON RETREAT MINING.


**NOTE WITHIN 100 FOOT COVER LINE**

1. BUTTRESS ENTRY CAN BE 21 FEET WIDE BUT ALL OTHER ENTRIES AND CROSSCUTS MUST BE 18 FEET OR LESS.
2. ONLY 1ST MINING IS ALLOWED! NO PILLAR BLOCK SPLITTING OR FULL PILLARING IS ALLOWED.
3. ADDITIONAL ROOF SUPPORT WILL BE ADDED UNDER THE STREAM BEDS, ROAD AND ALL INTERSECTIONS.
4. THE ONLY MINING DONE WILL BE ACCORDING TO THE MINING PRACTICES SHOWN ON THIS MAP.

SURFACE: BURREY LILEY  
SEW. COAL: LEE LAND MINERALS

SURFACE: N I S MATHews  
SEW. COAL: DUNKARD MINING CO

SURFACE: HERSCHEL MATHews  
SEW. COAL: DUNKARD MINING CO

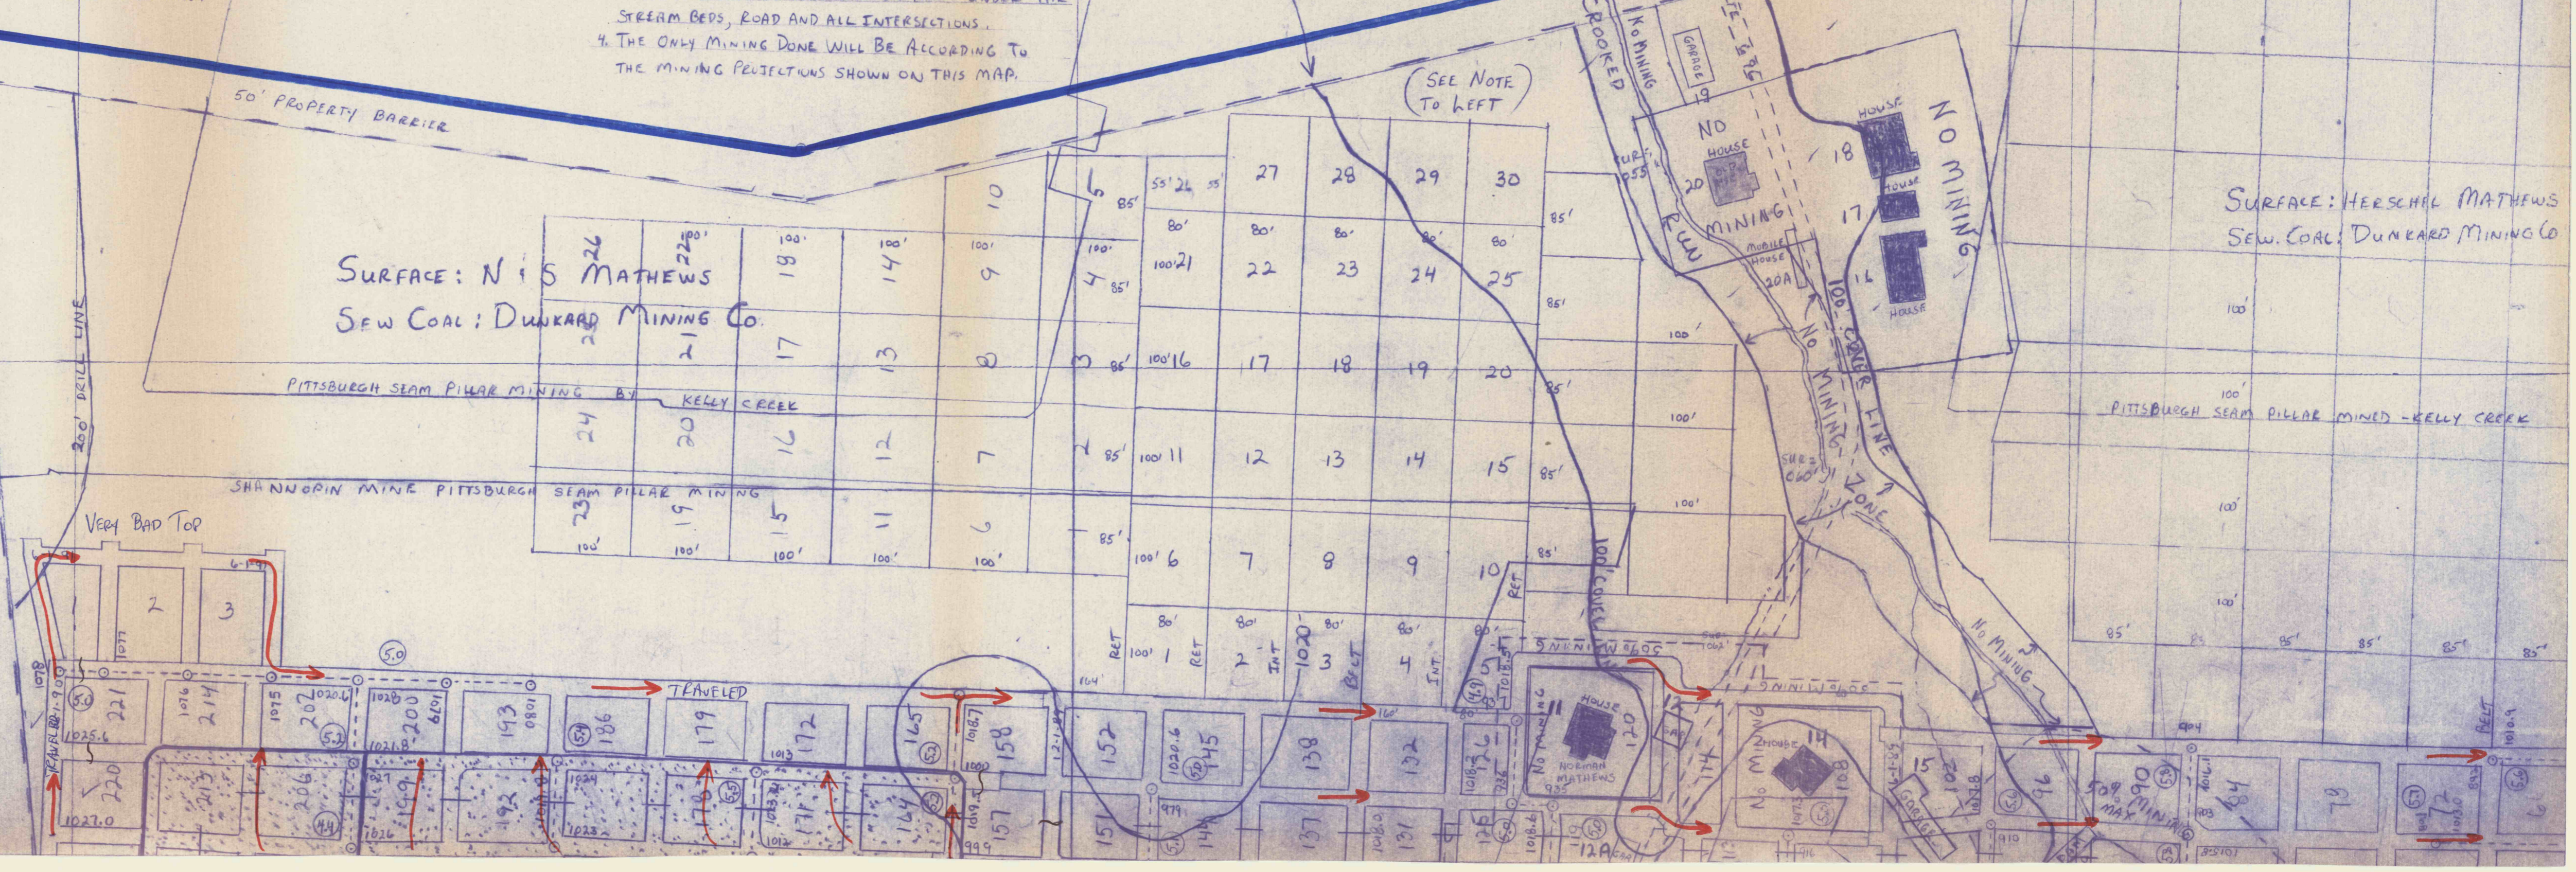

SHEET No. 2A

DUNKARD MINING CO  
DUNKARD MINE NO 2-36 01301  
DUNKARD TWP - GREENE CO - PA  
SCALE: 1" = 100' SEWICKLEY SEAM

NOTE: SUBTRACT 50 FEET FROM THE SEWICKLEY COAL ELEVATIONS SHOWN IN DUNKARD AND FRANCIS MINES TO GET SEWICKLEY COAL ELEVATIONS ABOVE SEA LEVEL.