


# FLOODED



SURFACE: ROBERT G. DONLEY  
SEW. COAL: WILLIS RADER

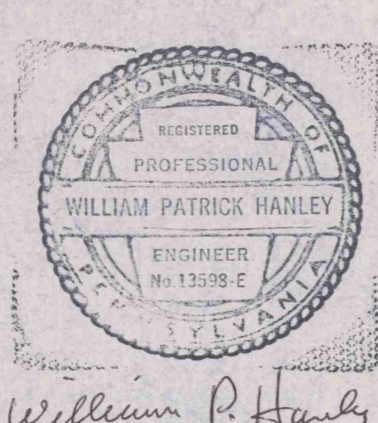

SHEET No 3

DUNKARD MINING CO. AND FRANCIS MINE - I.D. 36 04779  
DUNKARD TWP., GREENE CO., PA.  
SCALE: 1"=100' SEWICKLEY SEAM

DUNKARD MINING CO. DUNKARD MINE No 2 - I.D. 36 01301  
DUNKARD TWP., GREENE CO., PA.  
SCALE: 1"=100' SEWICKLEY SEAM

NOTE:  
SUBTRACT 50 FEET FROM THE SEWICKLEY COAL ELEVATIONS SHOWN IN DUNKARD AND FRANCIS MINES TO GET SEWICKLEY COAL ELEVATIONS ABOVE SEA LEVEL

**MINE MAP LEGEND:**

- Mine Property Outline
- Conveyor Belt
- Mine Track
- Feeder Cable or Trolley Line
- Intake Air Escapeway
- Alternate Escapeway
- Intake Air
- Return Air
- Permanent Air Stoppings
- Permanent Air Stoppings With Door
- Mine Air Regulator
- Mine Air Overcast
- Temporary Air Check
- Fire Retardent Line Curtain
- Engineer Surveying Stations
- 940.0 Bottom Sewickley Coal Elevation Contours
- Mining Height
- Door
- Bleeder Evaluation Point
- CO Monitoring Point
- Belt Transfer Point

1. There are two production sections in the mine.
2. All permanent air stoppings, overcasts and man-doors made of non-combustible material.
3. All temporary air checks and line curtains are made of fire retardant materials.
4. The Pittsburgh Seam 120 feet below has been partially mined by the Shannopin Mine.

32000

E 30000