


- MINE MAP LEGEND:**
- Mine Property Outline
 - Conveyor Belt
 - Mine Track
 - Feeder Cable or Trolley Line
 - Intake Air Escapeway
 - Alternate Escapeway
 - Intake Air
 - Return Air
 - Permanent Air Stoppings
 - Permanent Air Stoppings With Door
 - Mine Air Regulator
 - Mine Air Overcast
 - Temporary Air Check
 - Fire Retardant Line Curtain
 - Engineer Surveying Stations
 - 940.0 Bottom Sewickley Coal Elevation Contours
 - Mining Height
 - Door
 - Bleeder Evaluation Point
 - CO Monitoring Point
 - Belt transfer Point

1. There are two production sections in the mine.
2. All permanent air stoppings, overcasts and man-doors made of non-combustible material.
3. All temporary air checks and line curtains are made of fire retardant materials.
4. The Pittsburgh Seam 120 feet below has been partially mined by the Shannopin Mine.

SHEET No. 4
 DUNKARD MINING COMPANY
 DUNKARD MINE No. 2 ID 36 01301
 DUNKARD TWP., GREENE CO., PA.
 SCALE: 1"=100' SEWICKLEY SEAM

NOTE:
 SUBTRACT 50 FEET FROM THE SEWICKLEY COAL ELEVATIONS SHOWN IN DUNKARD AND FRANKLIN MINES TO GET SEWICKLEY COAL ELEVATIONS ABOVE SEA LEVEL.

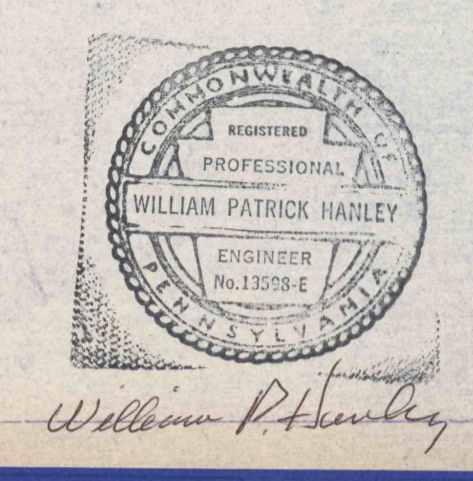

SURFACE SEWICKLEY COAL SEAM:
 DICK SANDERS

ROSEDALE No 8 MINE
 ABANDONED

SURFACE: W.VA TRACTS
 SEWICKLEY COAL: T. J. JOHNSON
 LAURENCE COAL CO

WEST VIRGINIA
 PENNSYLVANIA

NOTE: THERE IS NO EVIDENCE THAT THIS IS THE LAST MINE MAP. ALL AREAS WITHIN 500' OF SHOWN WORKINGS MUST BE DEEMED IN ADVANCE OF UNDERGROUND MINING. NO MINING WILL BE DONE ON LEFT SIDE OF 4 WEST UNTIL PROTECTIONS ARE DELETED AND AN APPROVAL IS GRANTED.

SURFACE: GEORGE WEAVER
 SEWICKLEY COAL: DUNKARD MNG. CO

SURFACE: FRANKIE KAY CLINE
 SEWICKLEY COAL: DUNKARD MNG. CO

D. & S.
 ABANDONED
 GAS WELL
 NO MINING
 TOP

