



SUR: GARRETT PHILLIPS  
SEW. COAL: CONSOL COAL CO

SUR: GEORGE JONES  
SEW. COAL: CONSOL COAL CO.

SUR: GOLDIE PHILLIPS  
SEW. COAL: CONSOL. COAL CO

SUR: EARL FULTON  
SEW. COAL: CONSOL COAL CO

SUR: CLYDE COOPER  
SEW. COAL: TARGET IND INC

SUR: WELLS SPONAGLE  
SEW. COAL: TARGET IND INC


SUR: CONCORDE COOP  
SEW. COAL: TARGET IND INC

SUR: ROBERT DOWLEY  
SEW. COAL: TARGET IND INC

**MINE MAP LEGEND:**

- Mine Property Outline
- Conveyor Belt
- Mine Track
- Feeder Cable or Trolley Line
- Intake Air Escapeway
- Alternate Escapeway
- Intake Air
- Return Air
- | Permanent Air Stoppings
- | Permanent Air Stoppings With Door
- | Mine Air Regulator
- | Mine Air Overcast
- | Temporary Air Check
- Fire Retardant Line Curtain
- o 123 Engineer Surveying Stations
- o Bottom Sewickley Coal Elevation Contours
- o Mining Height
- o Door
- o Bleeder Evaluation Point
- o Belt Transfer Point
- o CO Monitoring Point

1. There are two production sections in the mine.
2. All permanent air stoppings, overcasts and man-doors made of non-combustible material.
3. All temporary air checks and line curtains are made of fire retardant materials.
4. The Pittsburgh Seam 120 feet below has been partially mined by the Shannopin Mine.

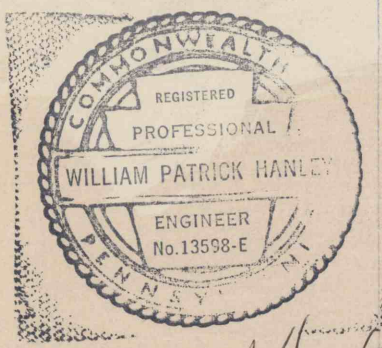

**SHEET No. 7**  
DUNKARD MINING CO.  
DUNKARD MINE No 2-ID.36 01301  
DUNKARD TWP, GREENE CO., PA  
SCALE: 1"=100' SEWICKLEY SEAM

**NOTE:** SUBTRACT 50 FEET FROM THE SEWICKLEY COAL ELEVATIONS SHOWN IN DUNKARD AND FRANCIS MINES TO GET SEWICKLEY COAL ELEVATIONS ABOVE SEA LEVEL.

N 29,000

N 30,000

N 32,000