


DUNKARD MINE NO. 2 - 36 01301
DUNKARD TWP - GREENE CO - PA
SHEET No. 1A

SCALE: 1" = 100' SEMICKLEY SEAM

NOTE:
 1) SUBTRACT 50 FEET FROM THE SEMICKLEY COAL ELEVATIONS SHOWN IN DUNKARD AND FRANKS MINES TO GET SEMICKLEY COAL ELEVATIONS ABOVE SEA LEVEL.
 2) IF THE 50' LINE TURNS A CORNER THE CORNER SHALL BE SHOWN AS A POINT ON THE 50' LINE.
 3) WHEN SETTING PILING BEARS, UNIFORM SUPPORT SHALL BE MAINTAINED.
 4) ENTRIES, CROSSINGS OR PILING BEARS WILL BE FIRST CLASS MINING.

Notes Written by: *William H. Hinkle*

- 1 - Outline of mining property
- 2 - Projected surface structure (17'-66" high or other structure)
- 3 - Building completed after 1906 or commercial structure
- 4 - Shed, barn or abandoned house
- 5 - Projected surface structure
- 6 - 50% of lease mining zone
- 7 - Outline of mining area for period 6-94 to 12-11-94
- 8 - Permanent air stoppings
- 9 - Mine air regulator
- 10 - Mine air overlying locations
- 11 - Engineer elevating stations
- 12 - Contours of bottom of coal seam
- 13 - Mining height of entry
- 14 - Oil or gas well
- 15 - Air door or air lock
- 16 - Proposed land area
- 17 - Outline of 5 Year Mining Plan

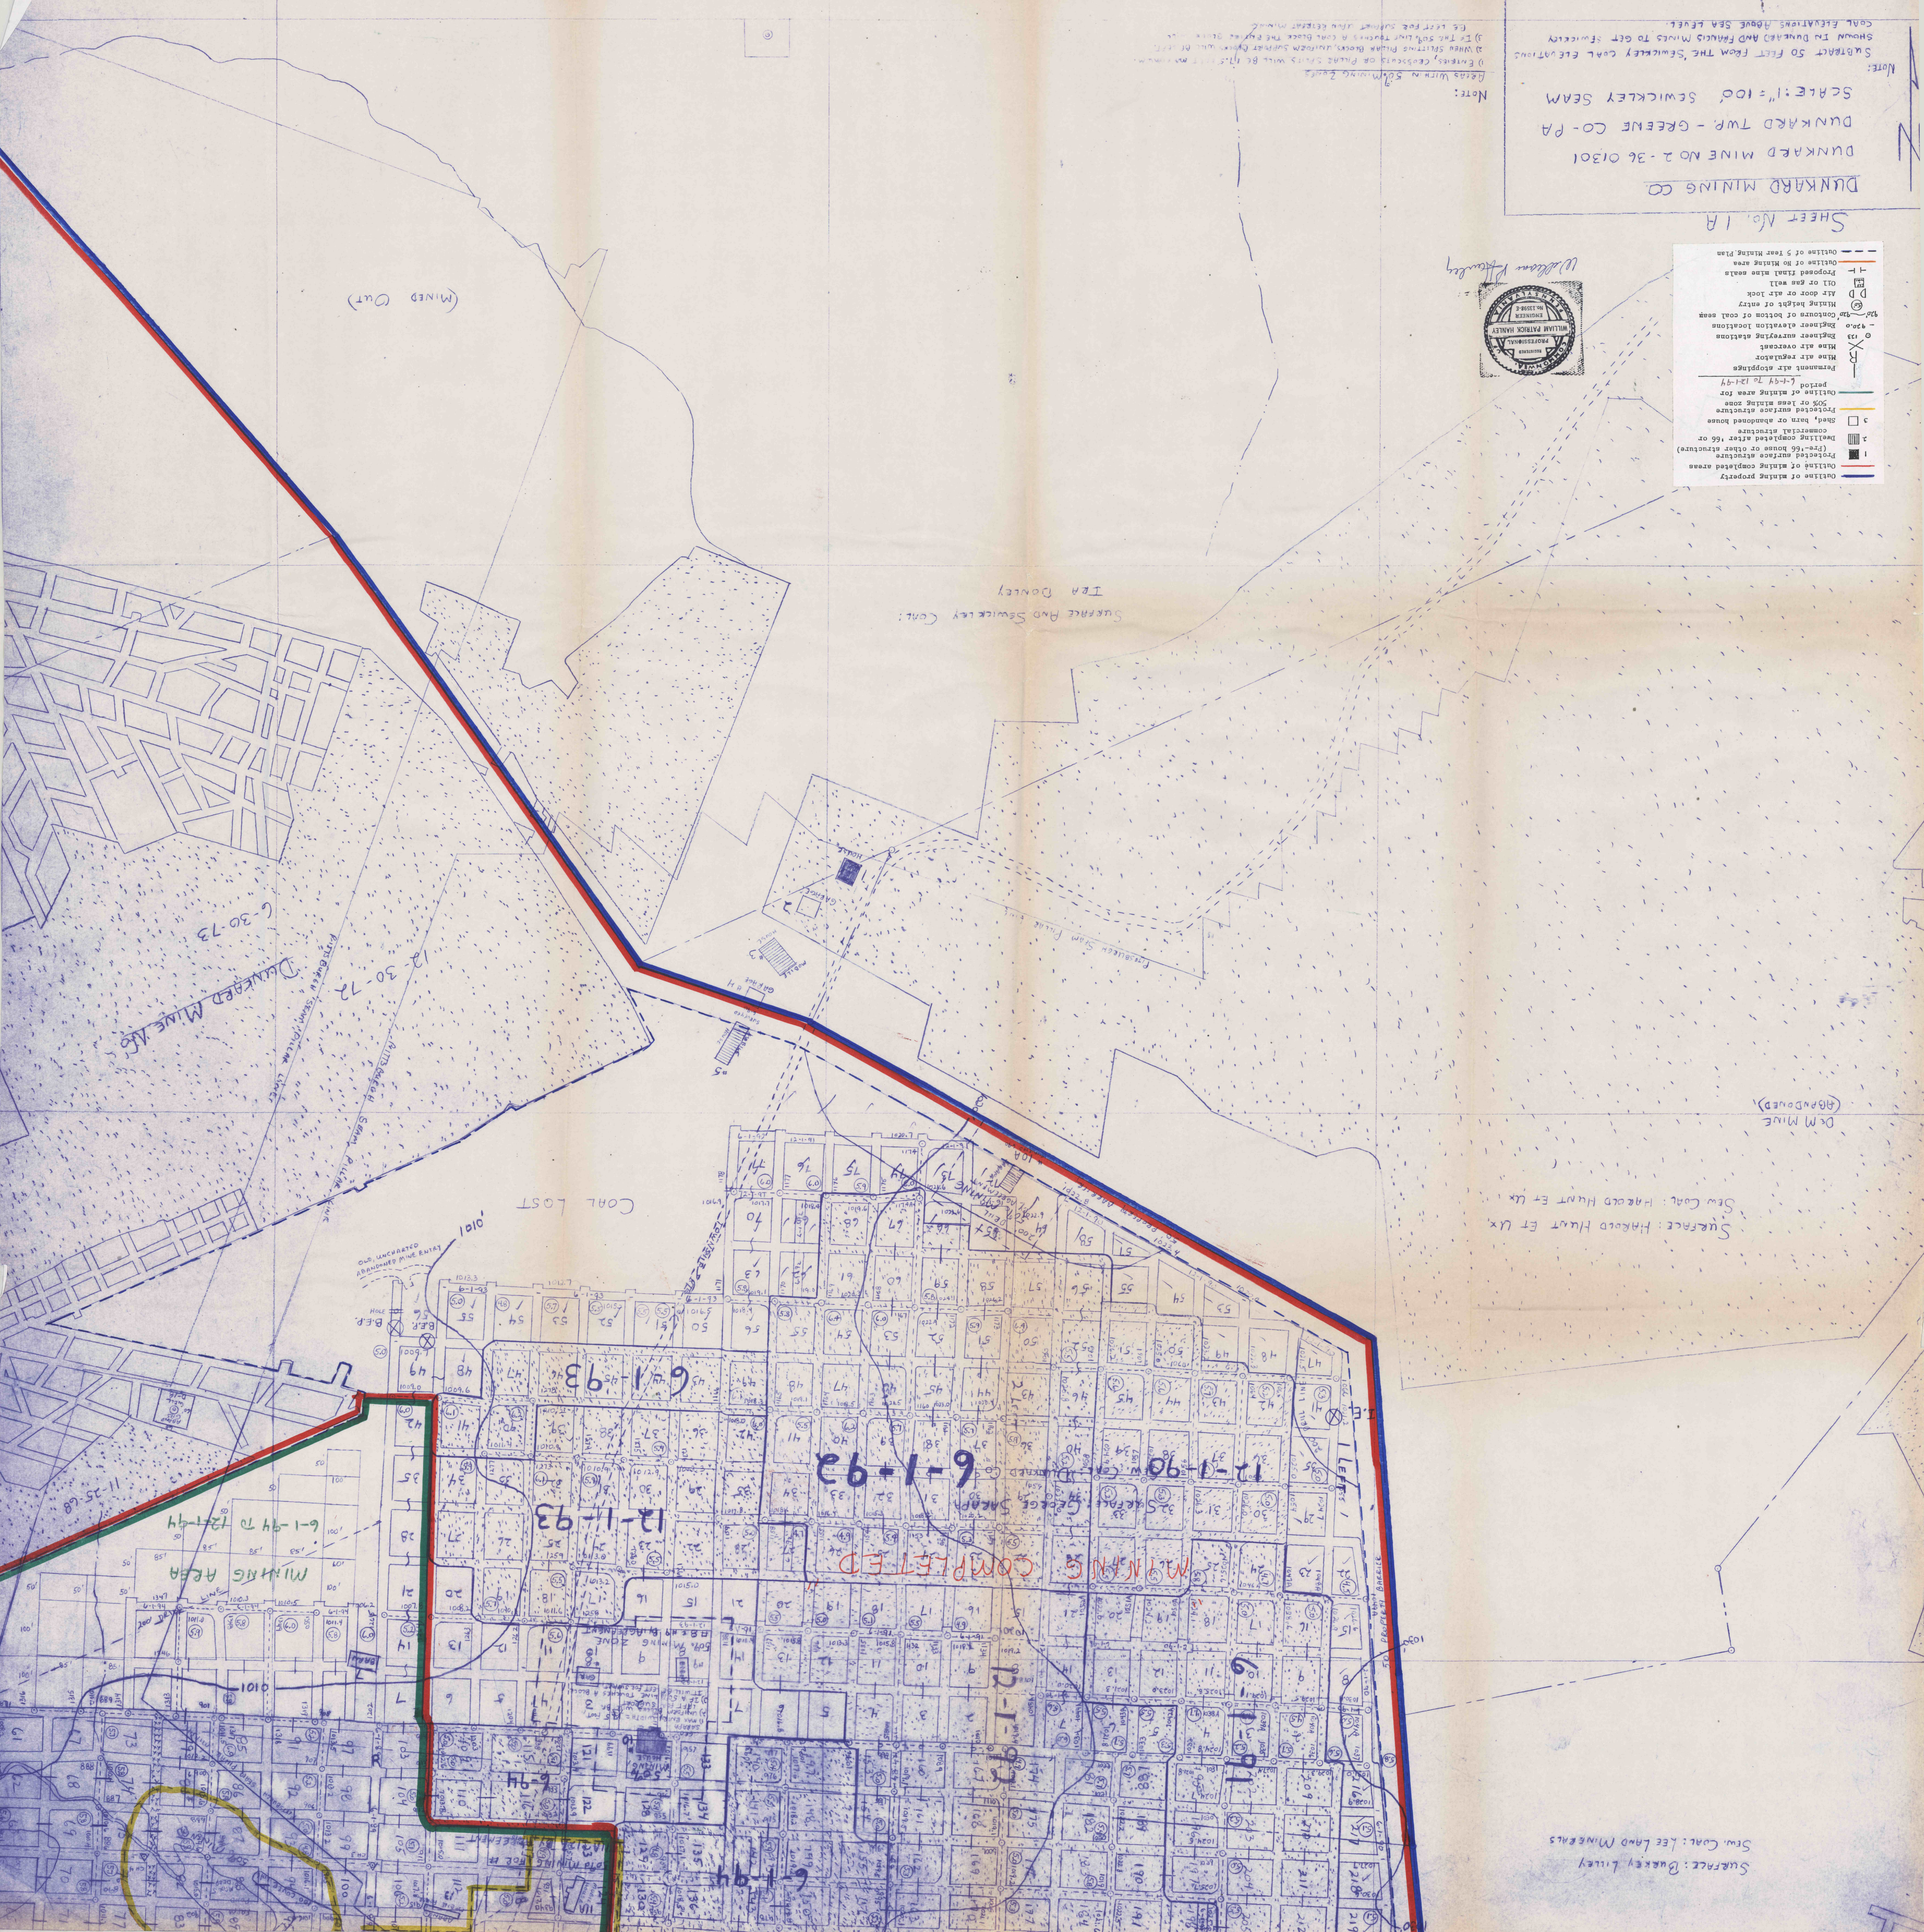

(MINED OUT)

SURFACE AND SEMICKLEY CENT.
 TEN DONKEY

SURFACE: HAROLD HUNT ET UX
 SEM COAL: HAROLD HUNT ET UX

(ABANDONED)
 DE MINE

SURFACE: BUCKLEY LILLEY
 SEM COAL: LEE LAND MINERALS

DUNKARD MINE NO. 1
 6-30-73

12-30-72

COAL LOST

6-1-92

COMPLETED

12-11-93

6-1-94

MINE NO. 1
 6-1-94 TO 12-11-94

11-25-68

101

102

