




- Outline of mining property
- Outline of mining completed areas
- Protected surface structure (Pre-1860 house or other structure)
- Dwelling completed after 1860 or commercial structure
- Shed, barn or abandoned house
- Protected surface structure 500' or less mining zone
- Outline of mining area for period 6-1-94 to 12-1-94
- Permanent air stoppings
- Mine air regulator
- Mine air overcast
- Engineer surveying stations
- Engineer elevation locations
- Contours of bottom of coal seam
- Mining height of entry
- Air door or air lock
- Oil or gas well
- Proposed final mine seals
- Outline of No Mining area
- Outline of 5 Year Mining Plan

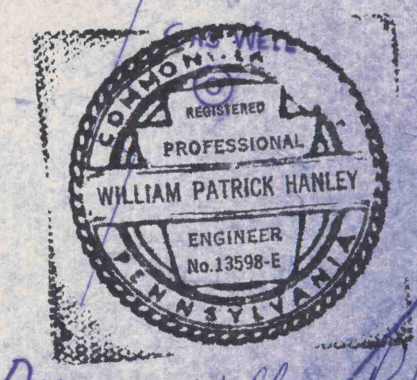

SHEET No. 1 "SUBSIDENCE MAP"

DUNKARD MINING CO. AND DUNKARD MINING CO.
 FRANCIS MINE - 36 04779 DUNKARD MINE NO 2 - 36 01301
 (MINED OUT AND SEALED) DUNKARD TWP - GREENE CO - PA.
 SCALE: 1" = 100' SEWICKLEY SEAM SCALE: 1" = 100' SEWICKLEY SEAM

MAPS UPDATED:

6-30-74	12-15-81	6-1-89
12-31-74	6-15-82	12-1-89
6-30-75	12-15-82	6-1-90
12-31-75	6-15-83	12-1-90
6-30-76	12-15-83	6-1-91

NOTE: SUBTRACT 50 FEET FROM SEWICKLEY COAL ELEVATIONS SHOWN IN DUNKARD & FRANCIS MINES TO GET SEWICKLEY ELEVATIONS ABOVE SEA LEVEL.