



SUR: GARRETT PHILLIPS
SEW. COAL: CONSOL COAL CO

SUR: GEORGE JONES
SEW. COAL: CONSOL COAL CO.

SUR: GOLDIE PHILLIPS
SEW. COAL: CONSOL COAL CO

SUR: EARL FULTON
SEW. COAL: CONSOL COAL CO


SUR: CLYDE COOPER
SEW. COAL: TARGET IND INC

SUR: WILLIS SPONAGLE
SEW. COAL: TARGET IND INC

SUR: CONCORDE CORP
SEW. COAL: TARGET IND INC

SUR: ROBERT DOWLEY
SEW. COAL: TARGET IND INC

- Outline of mining property
- Outline of mining completed areas
- Protected surface structure (175-166 houses or other structure)
- Dwelling completed after '66 or commercial structure
- Shed, barn or abandoned house
- Protected surface structure 50% or less mining zone
- Outline of mining area for period 6-1-94 to 12-1-94
- Permanent air stoppings
- Mine air regulator
- Mine air overcast
- (12) Engineer surveying stations
- (420.0) Engineer elevation locations
- Contours of bottom of coal seam
- Mining height of entry
- Air door or air lock
- Oil or gas well
- Proposed final mine seals
- Outline of No Mining area
- Outline of 5 Year Mining Plan

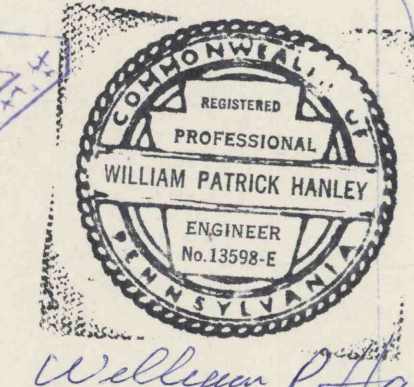

SHEET No. 7
DUNKARD MINING CO.
DUNKARD MINE No. 2 - ID. 36 01301
DUNKARD TWP., GREENE CO., PA
SCALE: 1"=100' SEWICKLEY SEAM

NOTE: SUBTRACT 50 FEET FROM THE SEWICKLEY COAL ELEVATIONS SHOWN IN DUNKARD AND FRANCIS MINES TO GET SEWICKLEY COAL ELEVATIONS ABOVE SEA LEVEL.



N 29,000

N 30,000

N 31,000

N 32,000

E 21,000