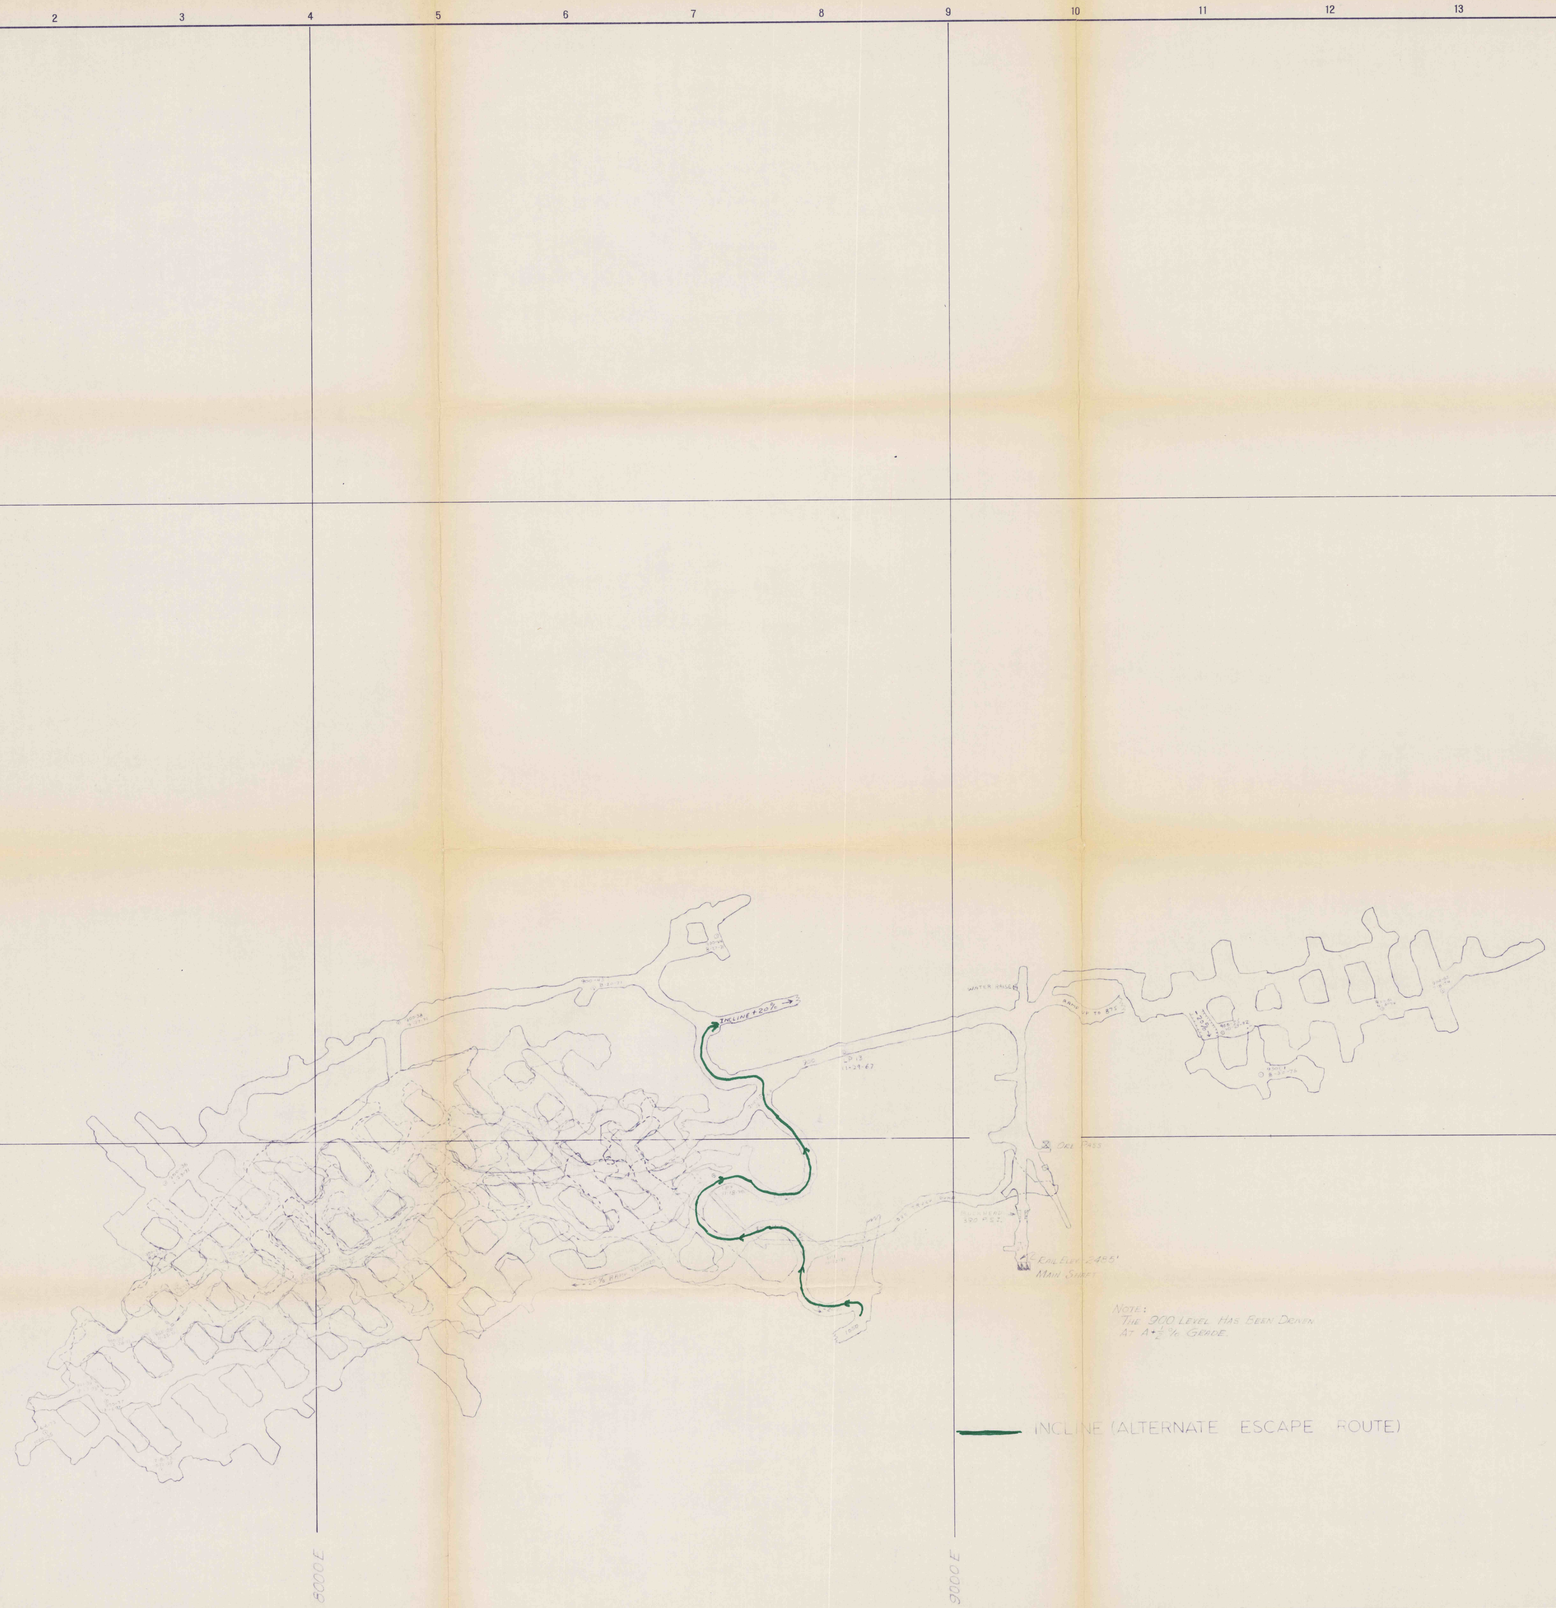

NOTE:
ALL ELEVATIONS SHOWN ON MAP
ARE SEA LEVEL PLUS 5000 FT.

20 m Sm 8-1/11/50

SERIAL NUMBER		DATE ISSUED	

THIS DRAWING IN DESIGN AND DETAIL IS OUR PROPERTY AND MUST NOT BE USED EXCEPT IN CONNECTION WITH OUR WORK. ALL RIGHTS OF DESIGN AND INVENTION ARE RESERVED. THIS DRAWING MUST BE RETURNED TO THE NEW JERSEY ZINC COMPANY.

REFERENCE DRAWINGS

GEOLOGIC MAP - 900 LEVEL

REVISIONS

[illegible]	1-31-46 HWL	1-12-76 JRM	1-19-76 JRM	2-13-76 JRM
EST'L WTR	1-12-67 JRM	8-7-75 JRM	2-11-75 JRM	11-7-75 JRM
#28 LG AUD	2-5-68 JRM	11-6-72 JRM	1-16-76 JRM	11-7-75 JRM
2-3-65 MHL	1-2-69 JRM	11-3-73 JRM	1-21-75 JRM	

THE NEW JERSEY ZINC COMPANY
FRIEDENSVILLE, PENNSYLVANIA
R. F. COX - MANAGER

DRAWN	STAFF
TRACED	J.E.C.
CHECKED	
APPROVED	

900 LEVEL, INCLINE AND STOPES
FRIEDENSVILLE ZINC MINE

DATE	SEPTEMBER 18, 1937
SCALE	1" = 100'
	7-BD-941