



4500 N

NOTE:
ALL MINE LEVELS HAVE BEEN
DRIVEN AT + 1/2% GRADE
ALL ELEVATIONS SHOWN ON MAP
ARE SEA LEVEL PLUS 3000 FT.

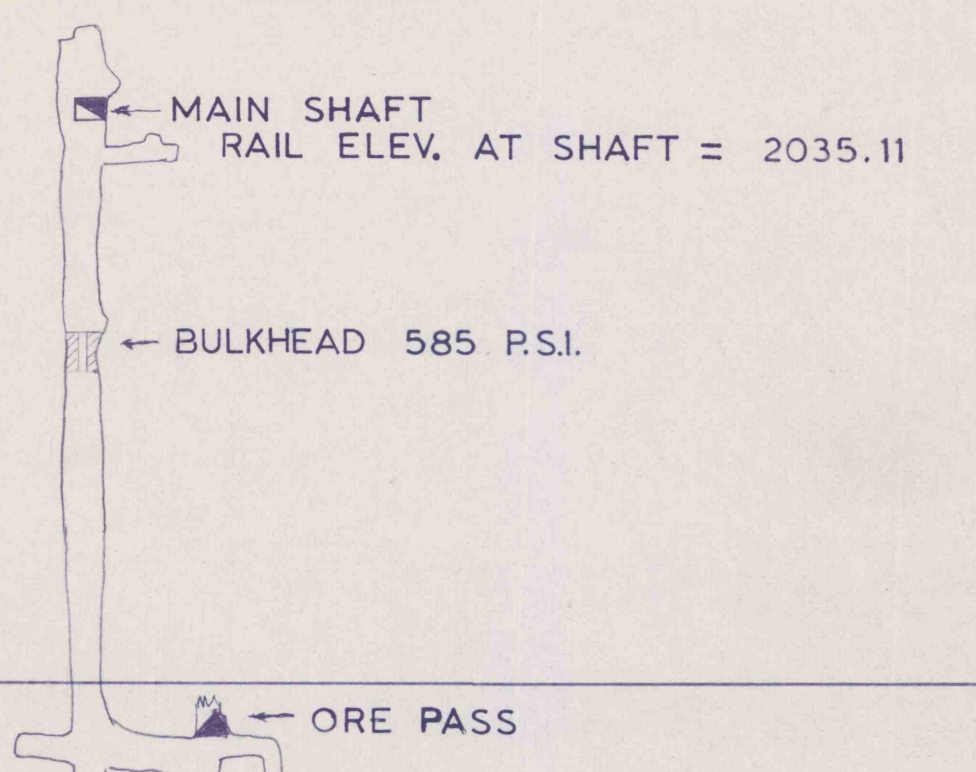

3500 N

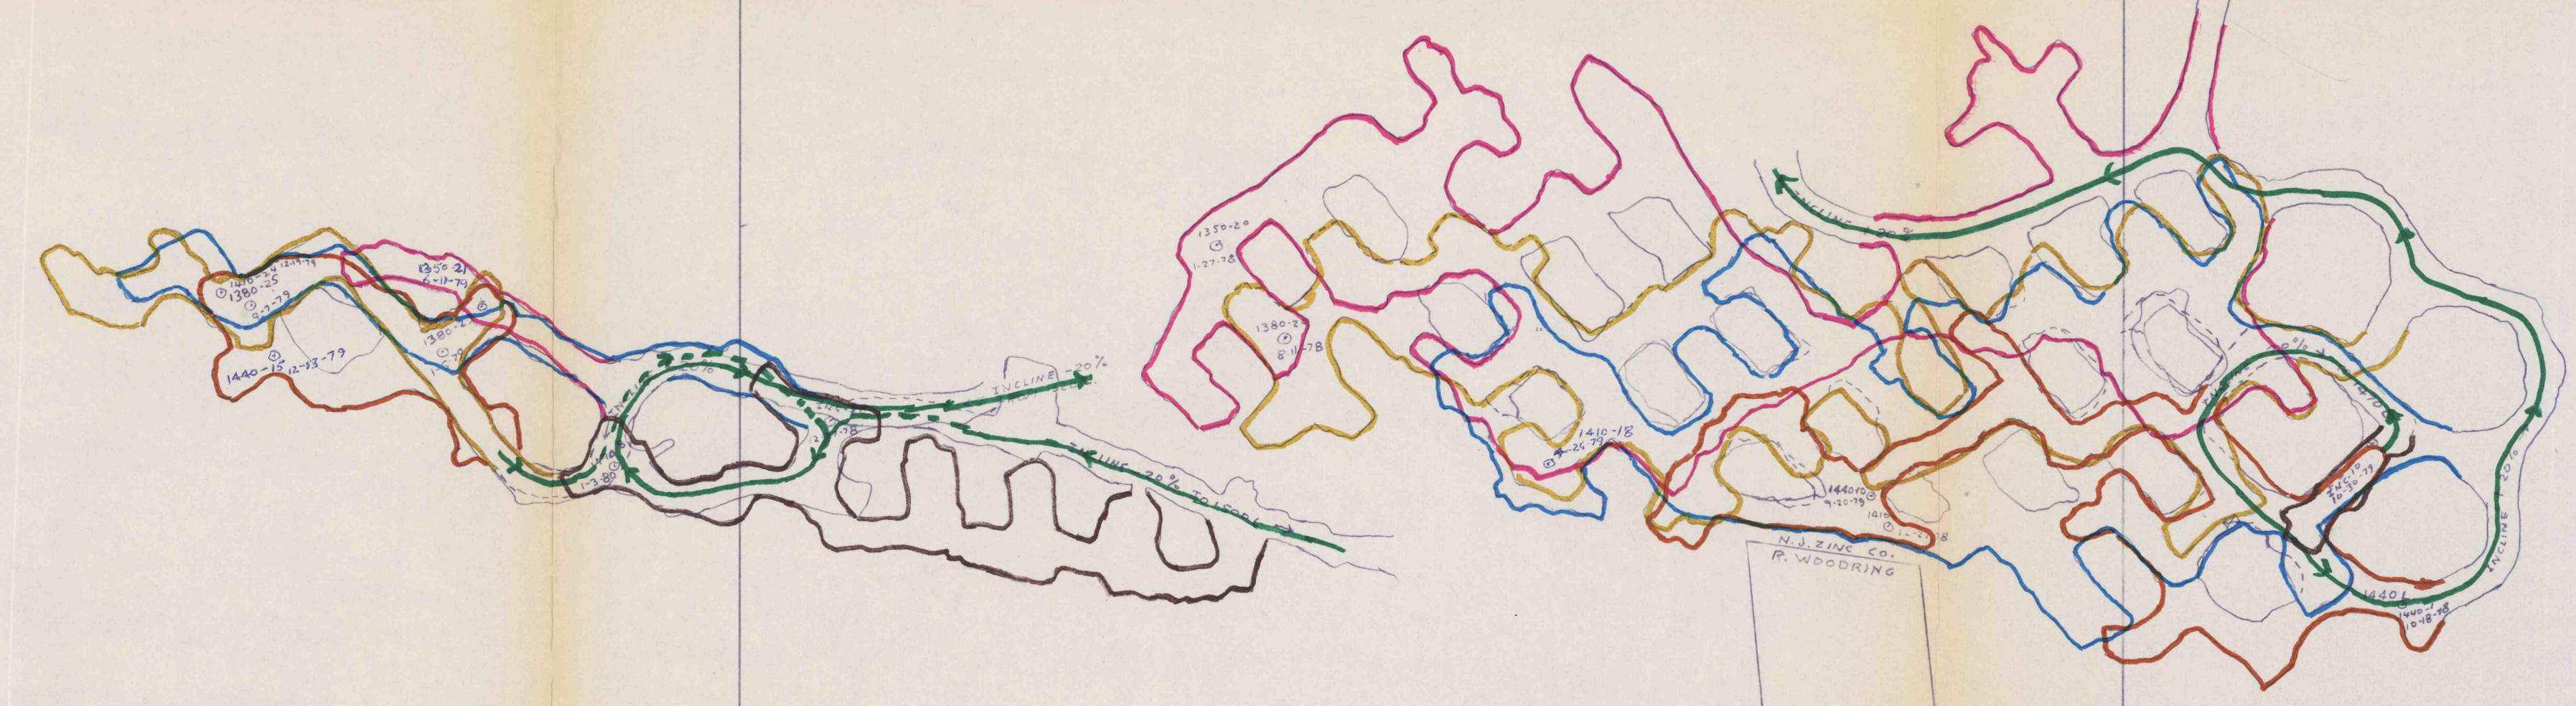

2500 N

- INCLINE (ALTERNATE ESCAPE ROUTE)
- 1350 L
- 1380 L
- 1410 L
- 1440 L
- 1470 L

SERIAL NUMBER: _____ DATE ISSUED: _____
 THIS DRAWING IN DESIGN AND DETAIL IS OUR PROPERTY AND MUST NOT BE USED EXCEPT IN CONNECTION WITH OUR WORK. ALL RIGHTS OF DESIGN AND INVENTION ARE RESERVED. THIS DRAWING MUST BE RETURNED TO THE NEW JERSEY ZINC COMPANY.

REFERENCE DRAWINGS	REVISIONS
1-4-80 JRM	

THE NEW JERSEY ZINC COMPANY
 FRIEDENSVILLE, PA.
 K. R. COX — MANAGER

DRAWN: JRM
 TRACED: _____
 CHECKED: _____
 APPROVED: _____

1350 LEVEL, INCLINE AND STOPES
 FRIEDENSVILLE ZINC MINE

DATE: JAN. 8, 1979
 SCALE: 1" = 100'

6000 E

7000 E

8000 E

9000 E