

4000 N


3000 N

7000 E

8000 E

9000 E

10000 E

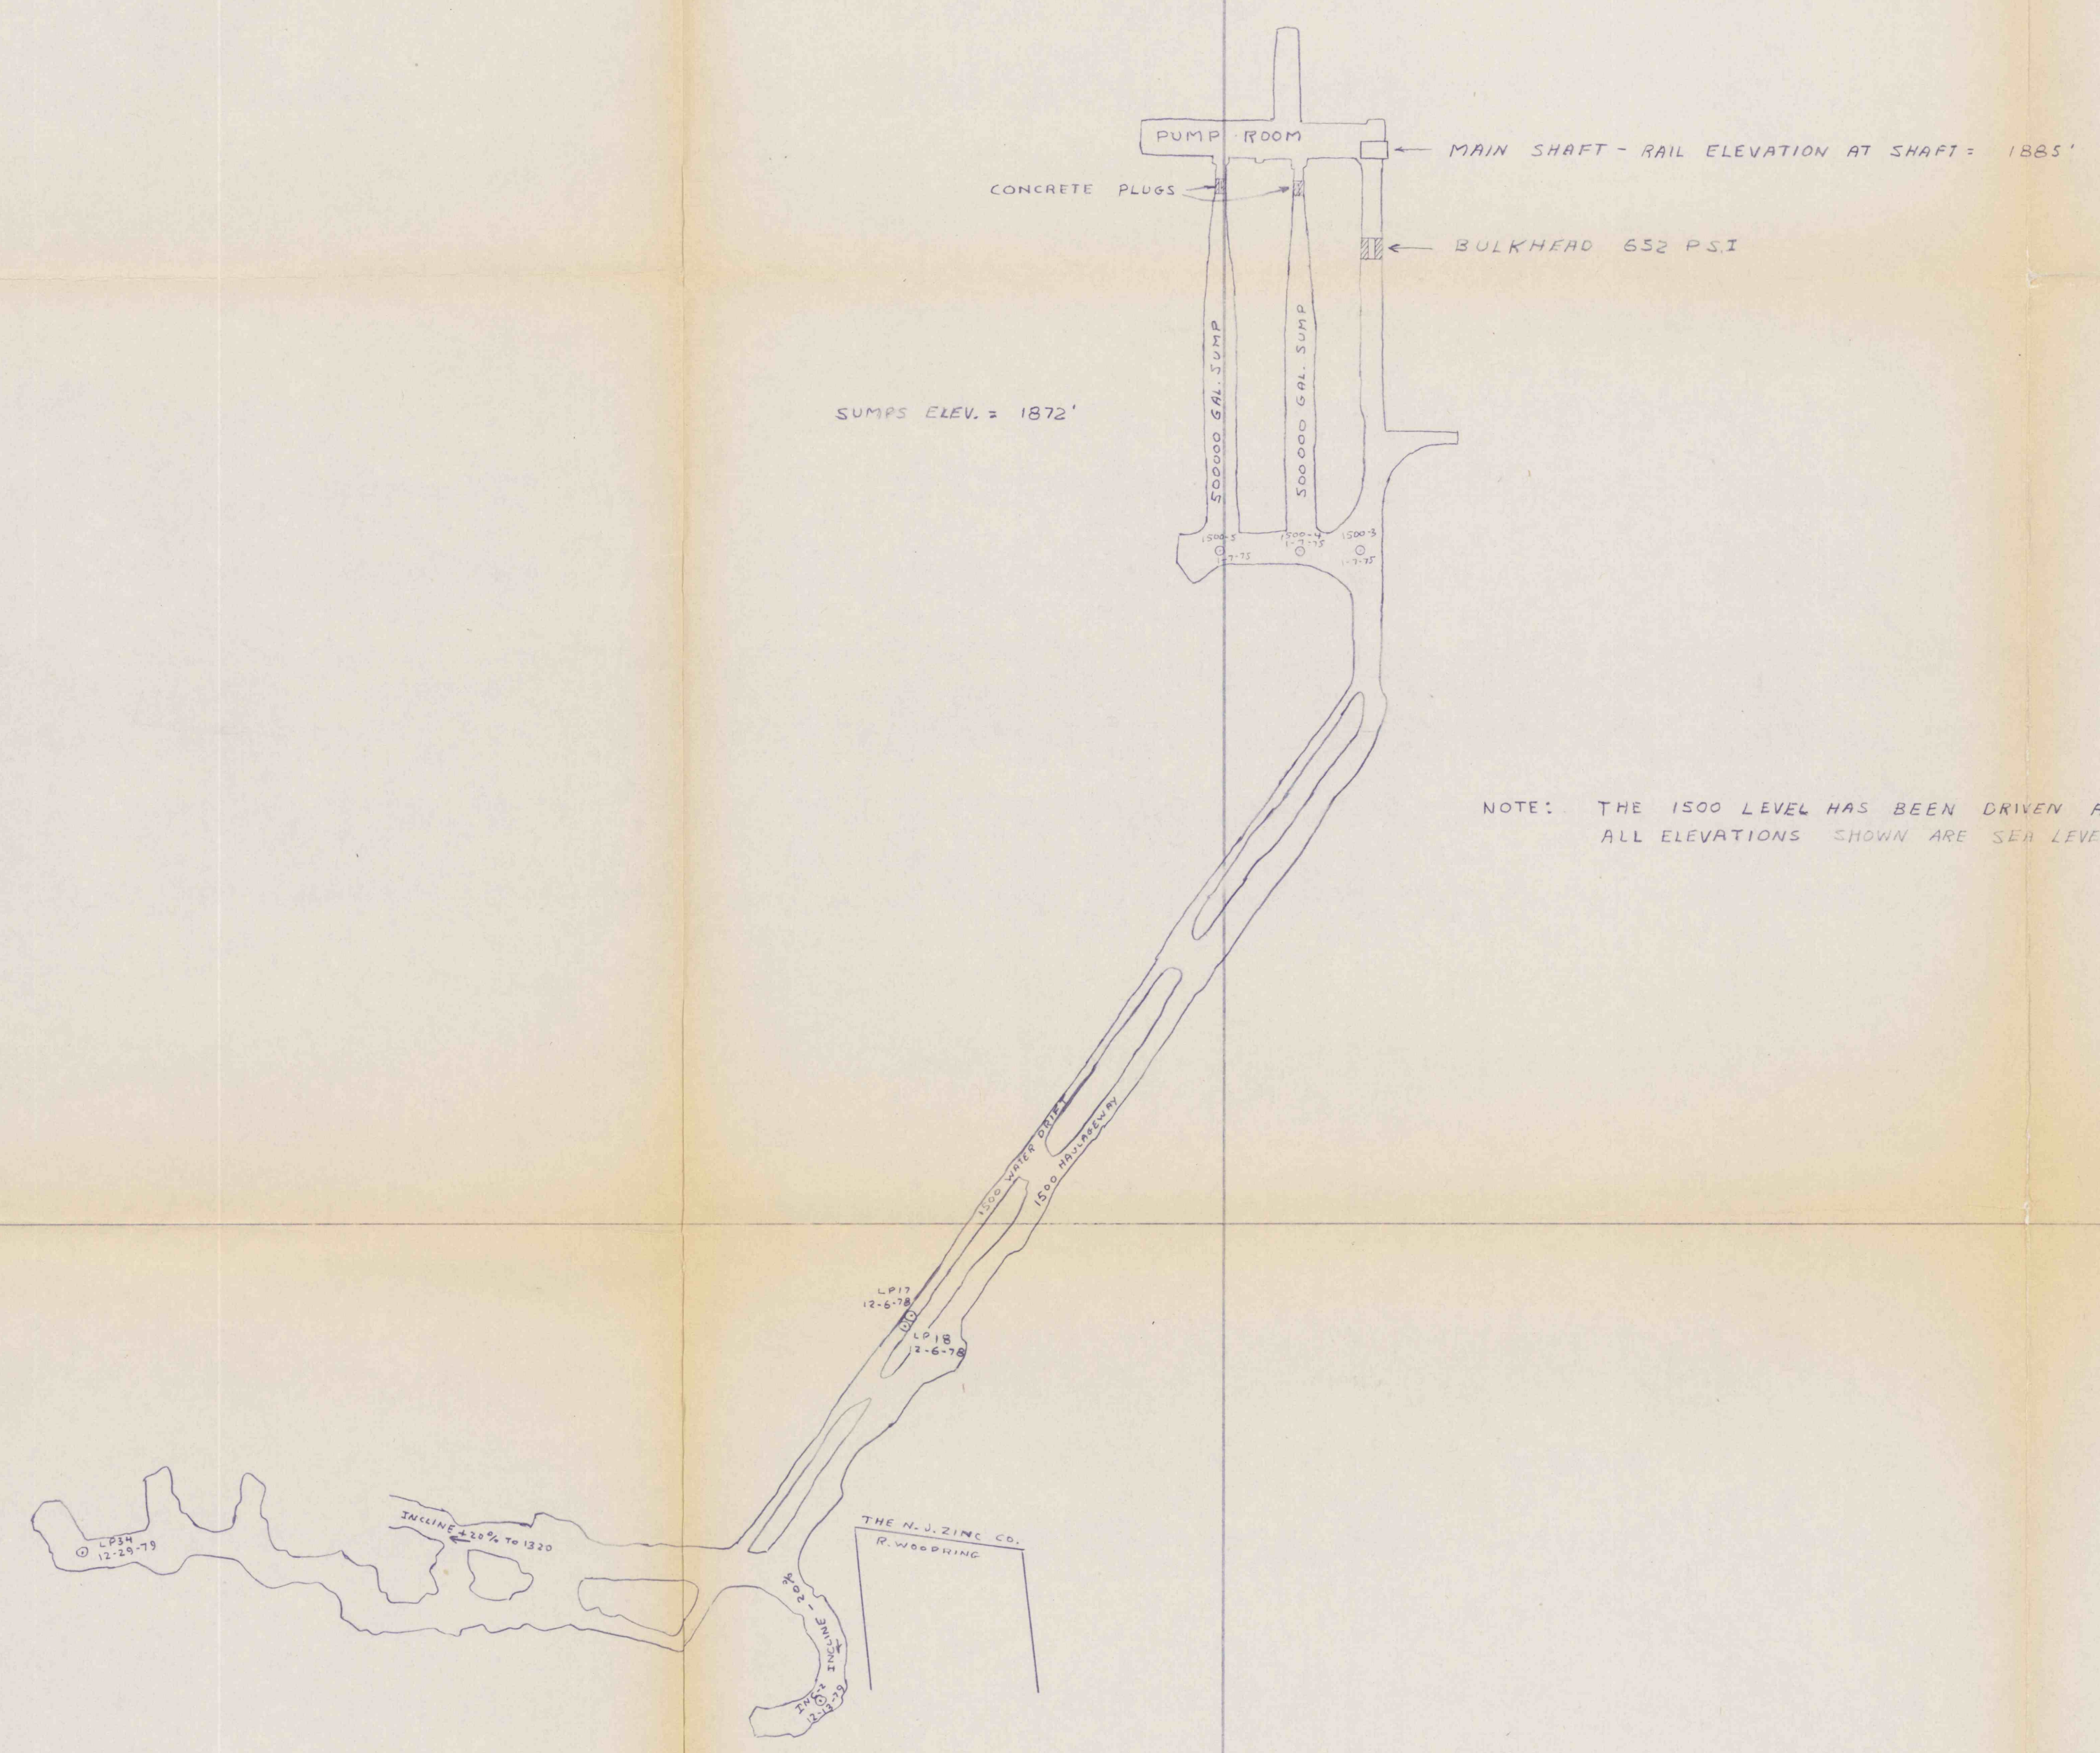

NOTE: THE 1500 LEVEL HAS BEEN DRIVEN AT + 1/2 % GRADE
 ALL ELEVATIONS SHOWN ARE SEA LEVEL + 3000'

SERIAL NUMBER: _____ DATE ISSUED: _____
 REFERENCE DRAWINGS: _____
 THIS DRAWING IN DESIGN AND DETAIL IS OUR PROPERTY AND MUST NOT BE USED EXCEPT IN CONNECTION WITH OUR WORK. ALL RIGHTS OF DESIGN AND INVENTION ARE RESERVED. THIS DRAWING MUST BE RETURNED TO THE NEW JERSEY ZINC COMPANY.

NO CHANGE 1/17/77
 1-2-79 JRM
 1-7-80 JRM

NO.	DATE	BY	REVISIONS

THE NEW JERSEY ZINC COMPANY
 FRIEDENSVILLE, PA.
 K. R. COX - MANAGER

DRAWN JRM
 TRACED _____
 CHECKED _____
 APPROVED _____

1500 LEVEL
 FRIEDENSVILLE ZINC MINE

DATE JAN. 12, 1977
 SCALE 1" = 100'
 1007-C-11