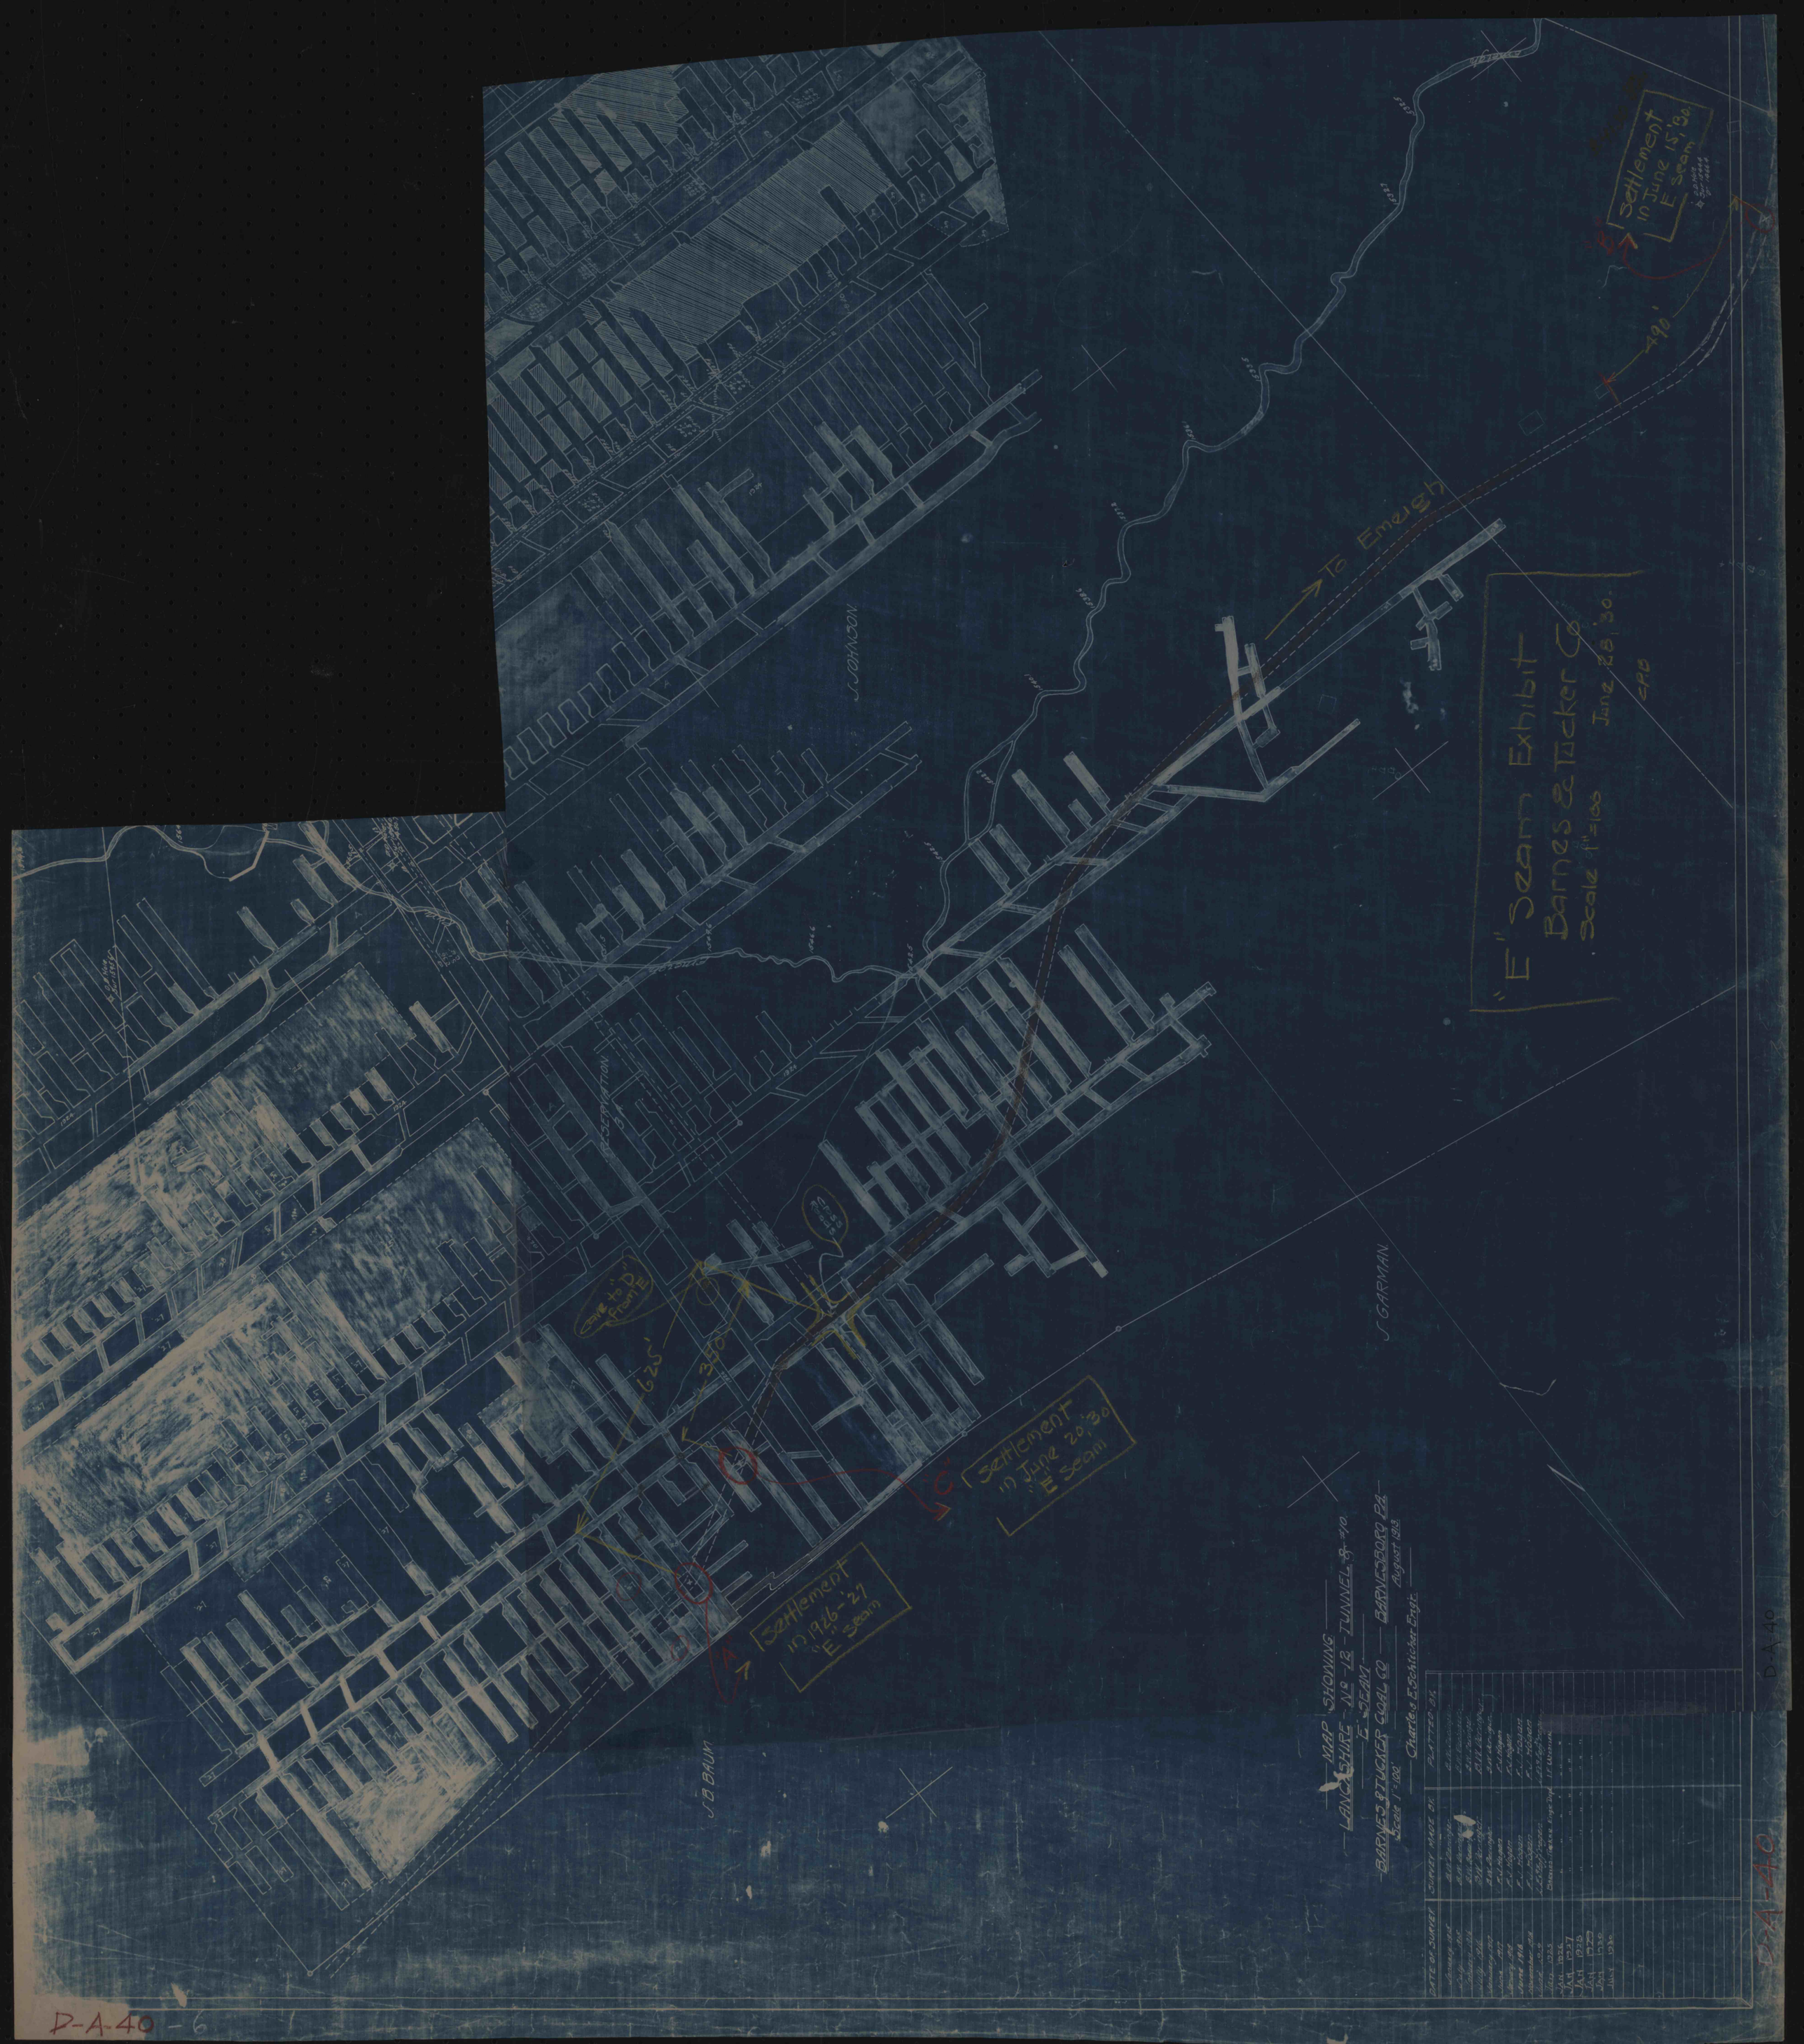
Settlement in June 15, '30 "E" Seam
To Emeigh
S JOHNSON
RESERVATION
Cave to D Frame E
625'
360'
Settlement in June 20, '30 "E" Seam
Settlement in 1926-'27 "E" Seam
J B BAUM
S GARMAN
"E" Seam Exhibit
Barnes & Tucker Co.
Scale 1"=100'
Jan. 28, 1930
MAP SHOWING LANCASHIRE No. 12 - TUNNEL & #10 "E" SEAM
BARNES & TUCKER COAL CO. — BARNESBORO PA.
Scale 1"=100'
August 1929
Charles E. Schleicher Engr.
DATE OF SURVEY
SURVEY MADE BY
PLOTTED BY
D-A-40
D-A-40 - 6