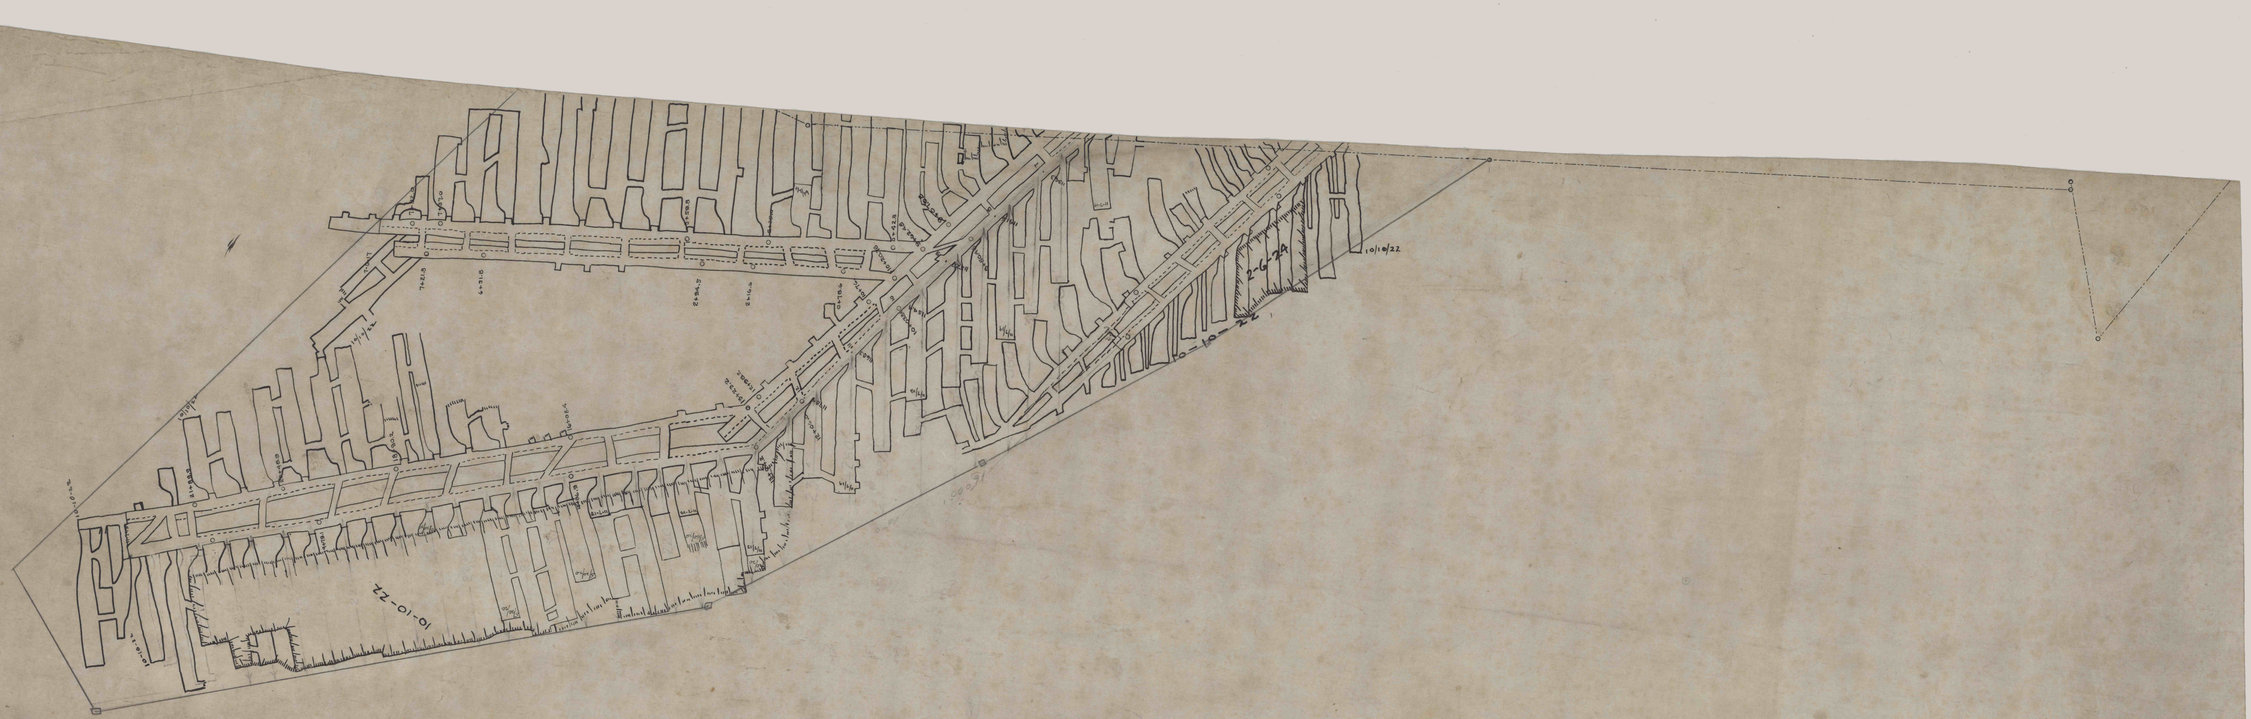

4133

Sfra 3001