


# STERLING MINES

Nos. 3<sup>RD</sup> & 6.


Property of

STERLING COAL CO.

Hastings,  
Cambria Co., Pa.

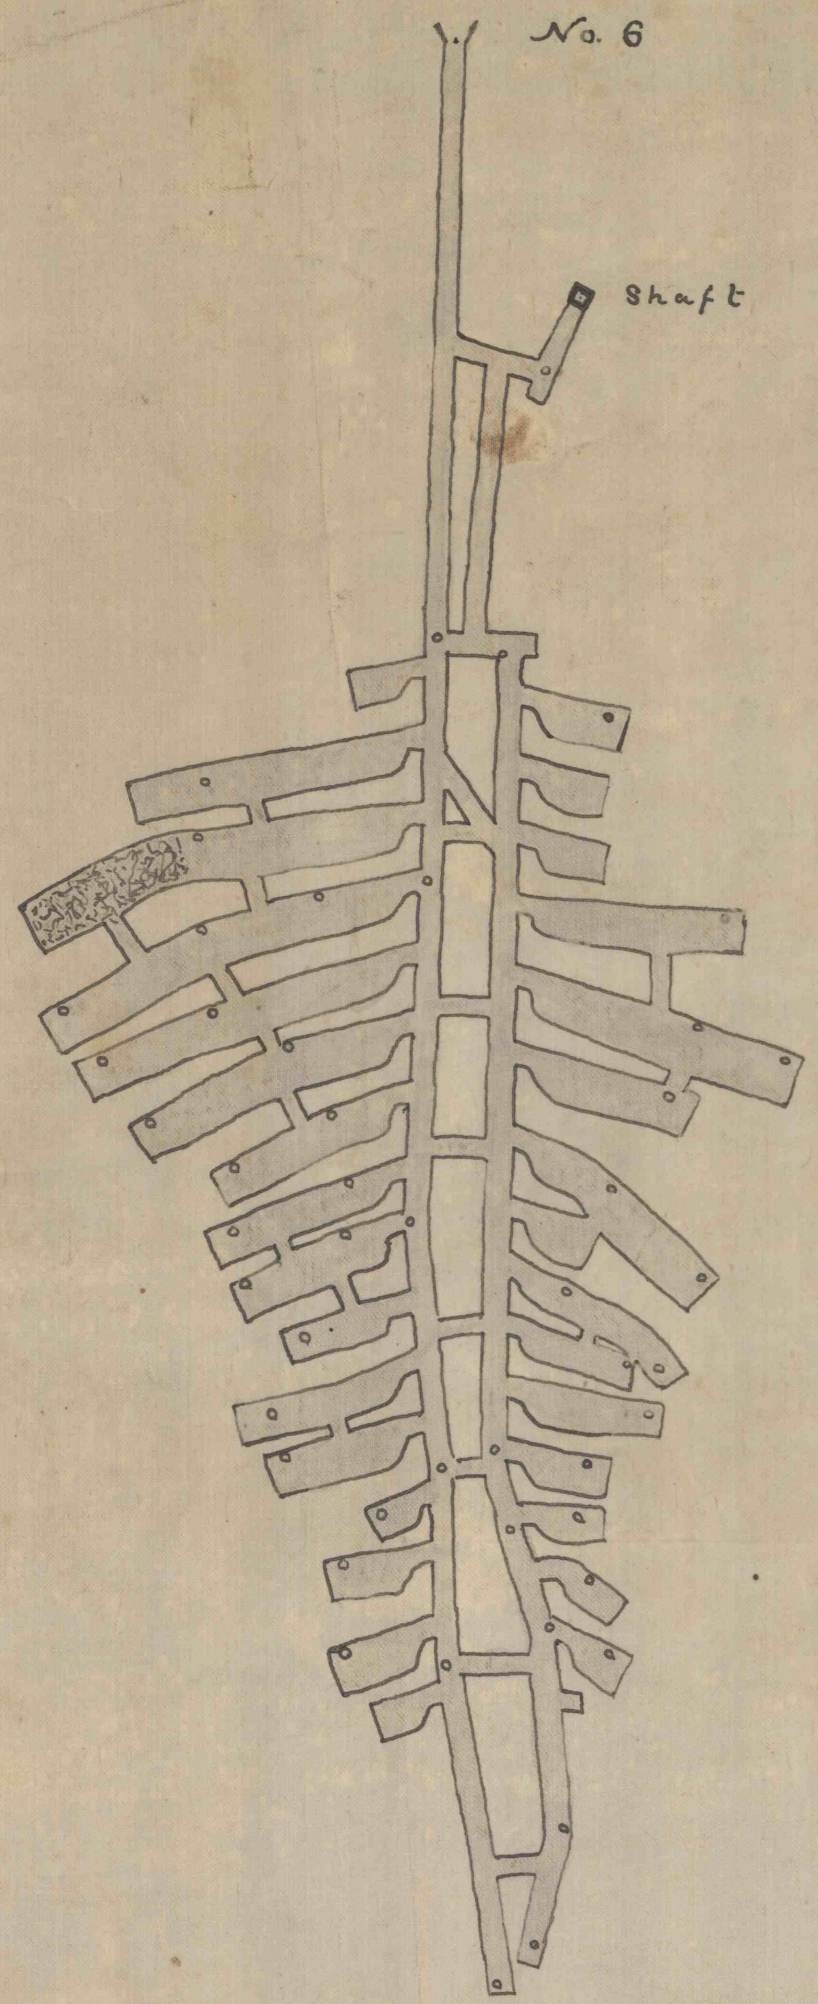

SCALE 1"=100'

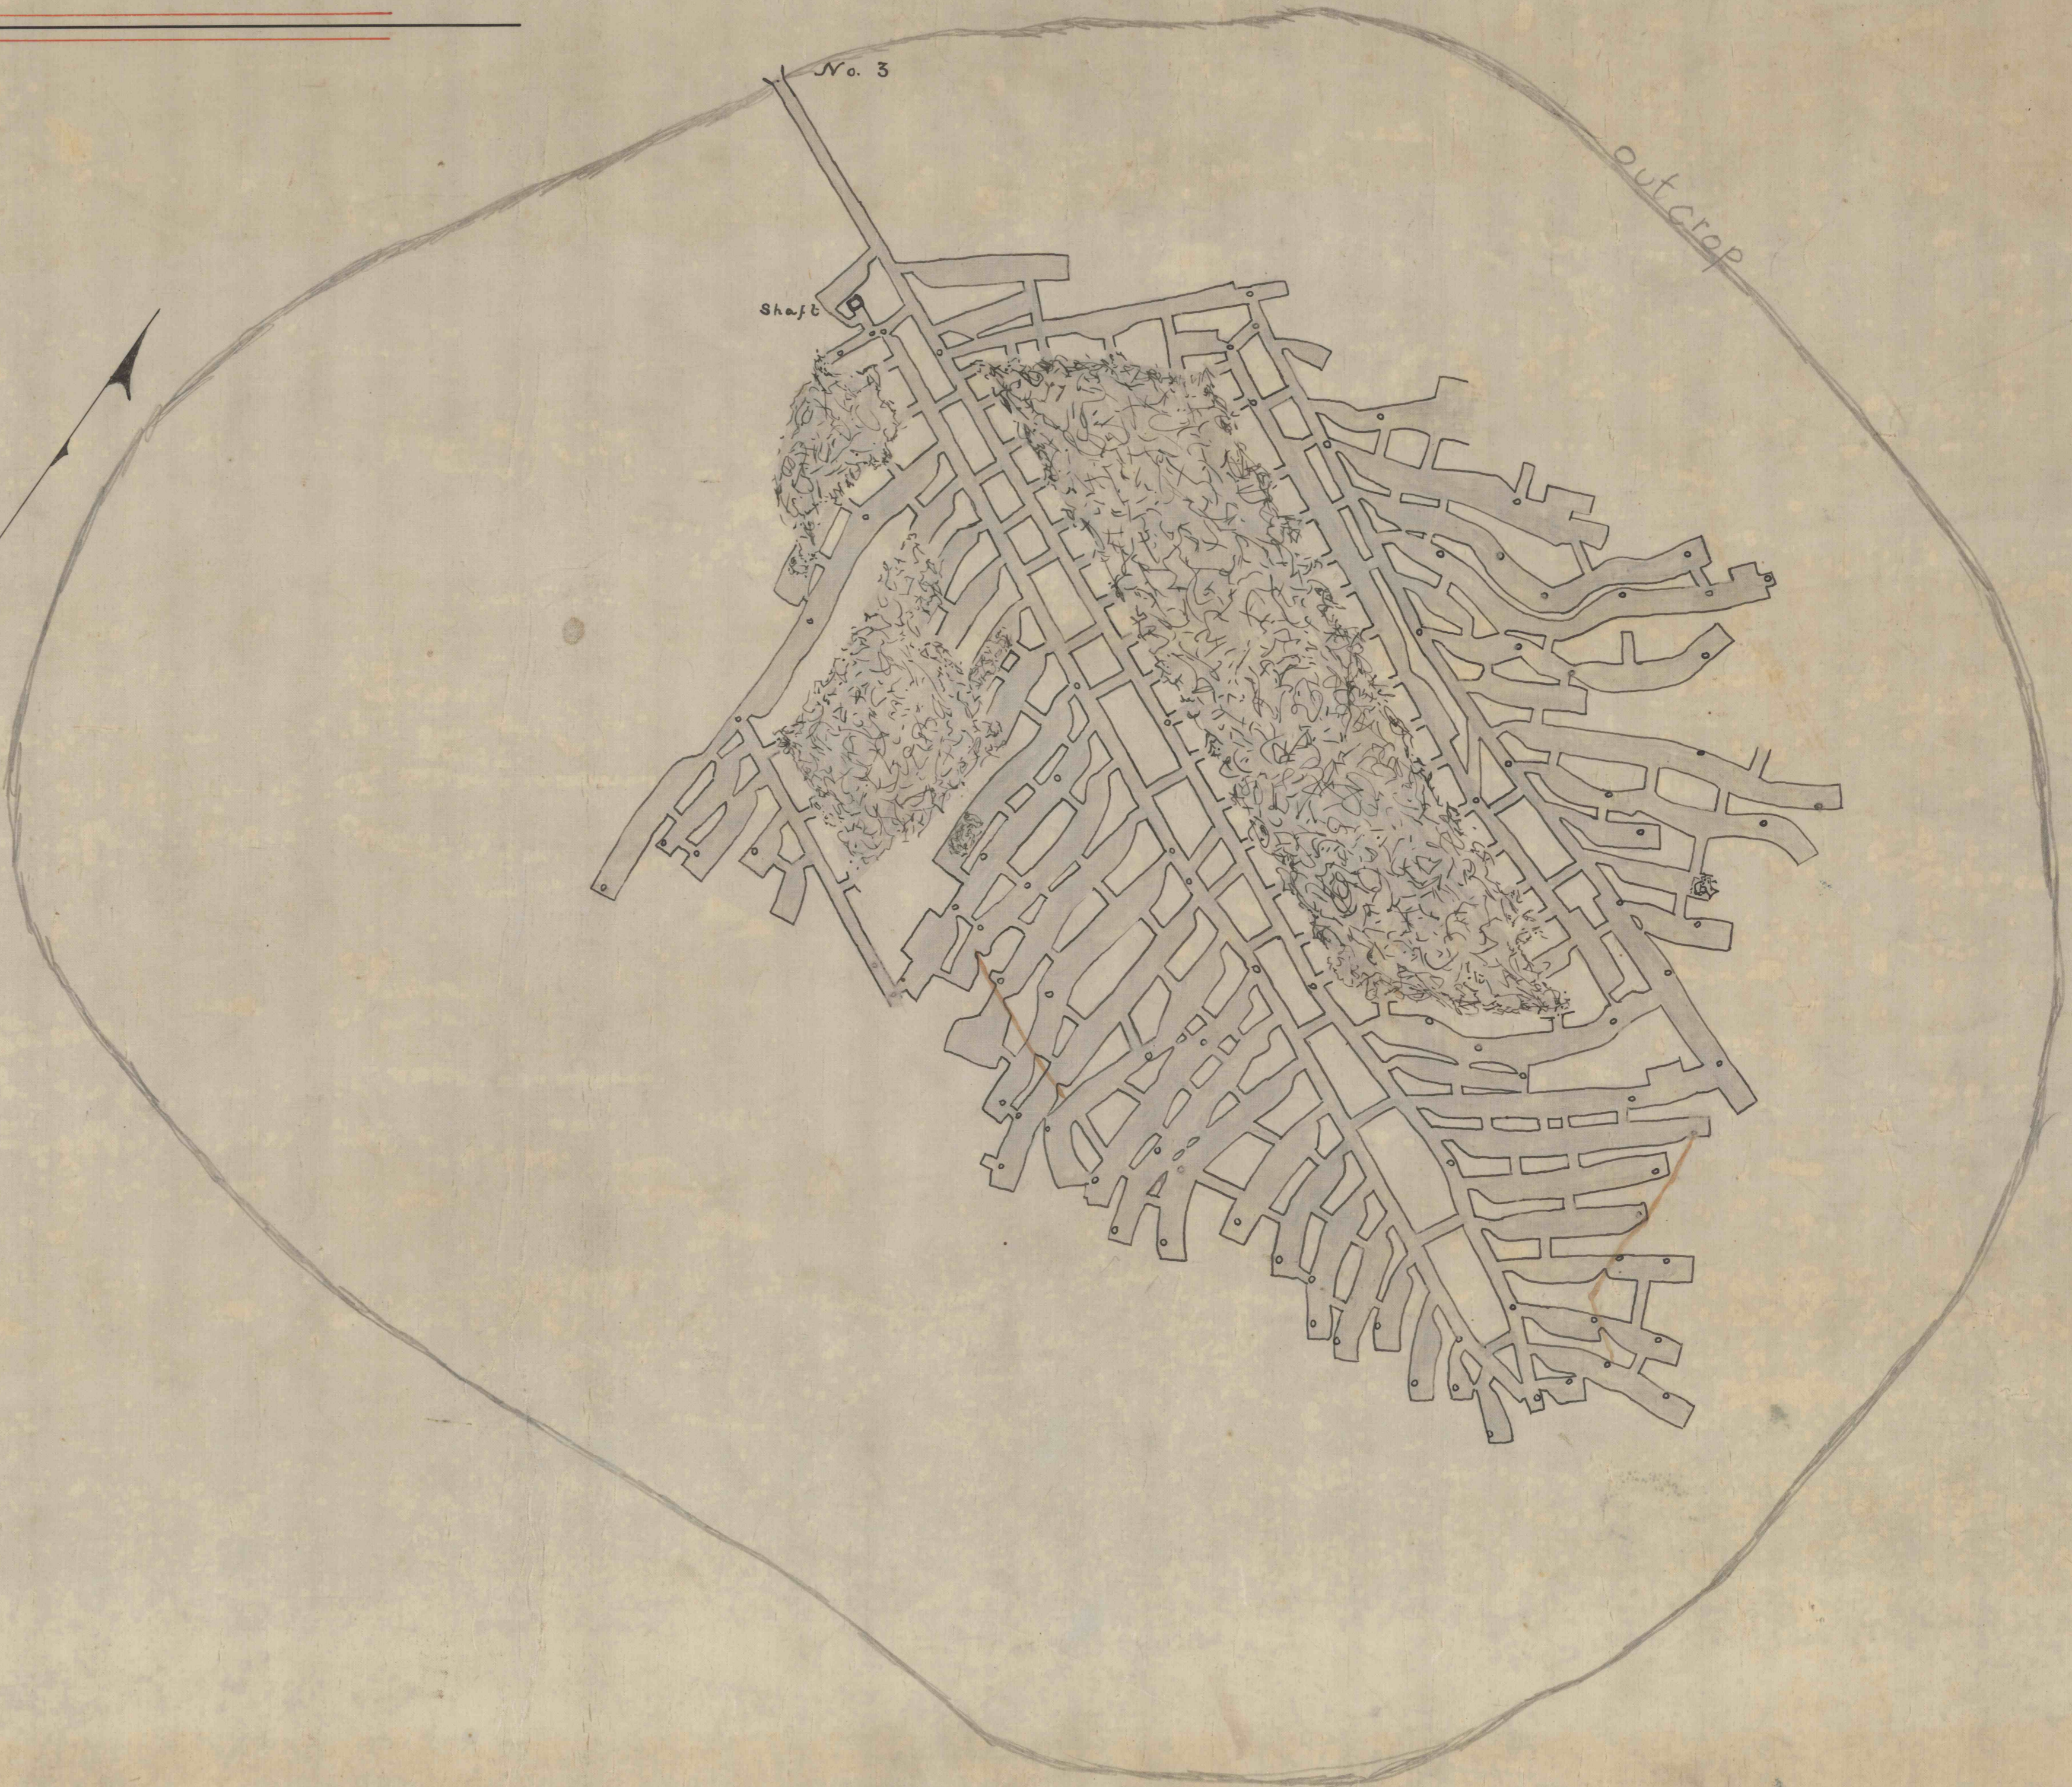

4137

Drawer Q2

R-2004

R-2052

11-25-35