

PATTERSON TRACT

Mined Out

Old Works

Leisenring Tract
Now Jack Smith

570' W
250'-00' 224.8'

315'

N 64° 59' W
295° 02' 32.6'

552° 17' W
232° 17' 53.4'

532° 57' W
147° 03' 28.9'

N 67° 03' W
292° 57' 64.1'

HIGHWAY (APPROX)

347° 43' N 12° 17' W
57.1'

252° 06' 83.8' 572° 06' W

247° 29' 16.5' 567° 27' W

228° 00' 55.3' - 548° 00' W

236° 32' 76.4'


556° 32' W

230'

163'

120'

Old Works

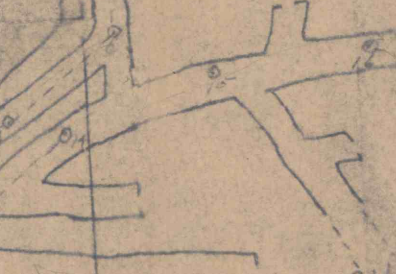

9-11-58
9-11-58

9-11-59