


COLUMBIA PLATE GLASS CO.
 LANDS IN
 DERRY TWP. WESTMORELAND CO. PA.

SCALE
 1" = 100'

WILSON & SMITH
 CIVIL ENGINEERS

APR. 13 1901

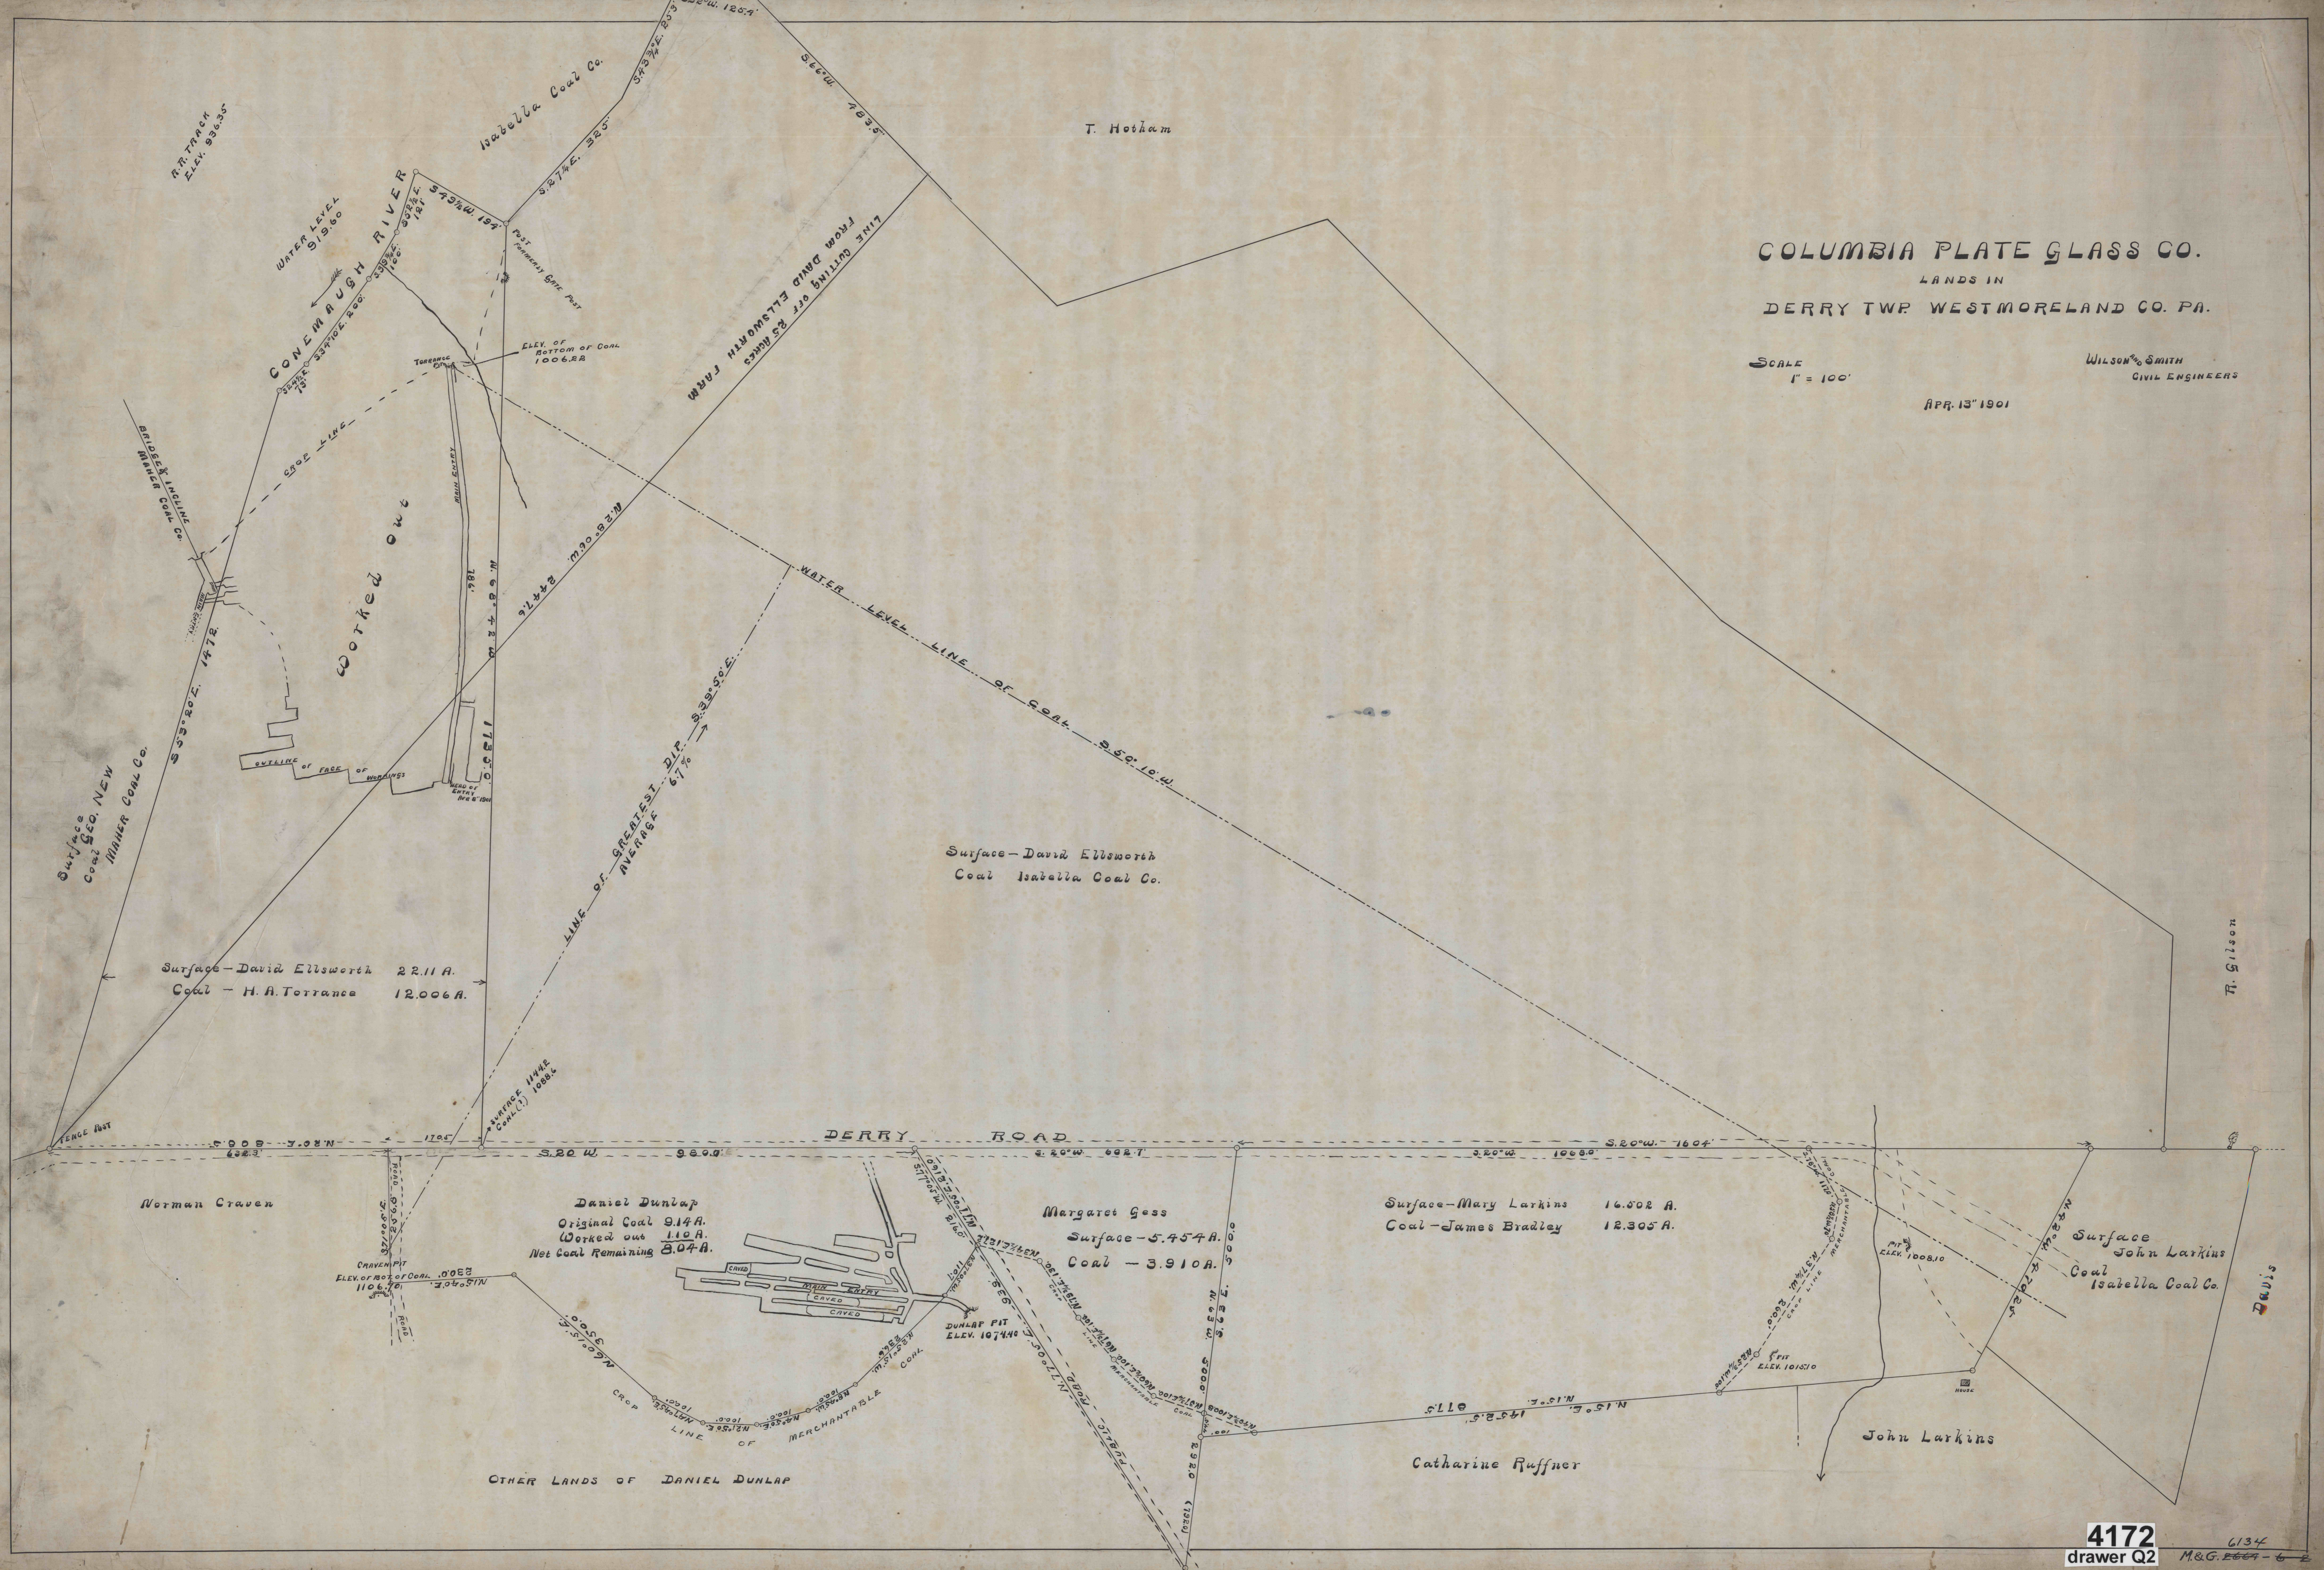

Surface - David Ellsworth
 Coal - Isabella Coal Co.

Surface - David Ellsworth 22.11 A.
 Coal - H. A. Torrance 12,006 A.

Daniel Dunlap
 Original Coal 914 A.
 Worked out 110 A.
 Net Coal Remaining 804 A.

Margaret Gess
 Surface - 5.454 A.
 Coal - 3.910 A.

Surface - Mary Larkins 16.502 A.
 Coal - James Bradley 12.305 A.

Surface - John Larkins
 Coal - Isabella Coal Co.

Catharine Ruffner

OTHER LANDS OF DANIEL DUNLAP