


Neal Kirkland

Arthur McEwen

10 Acres of Coal to be Mined

James Blair

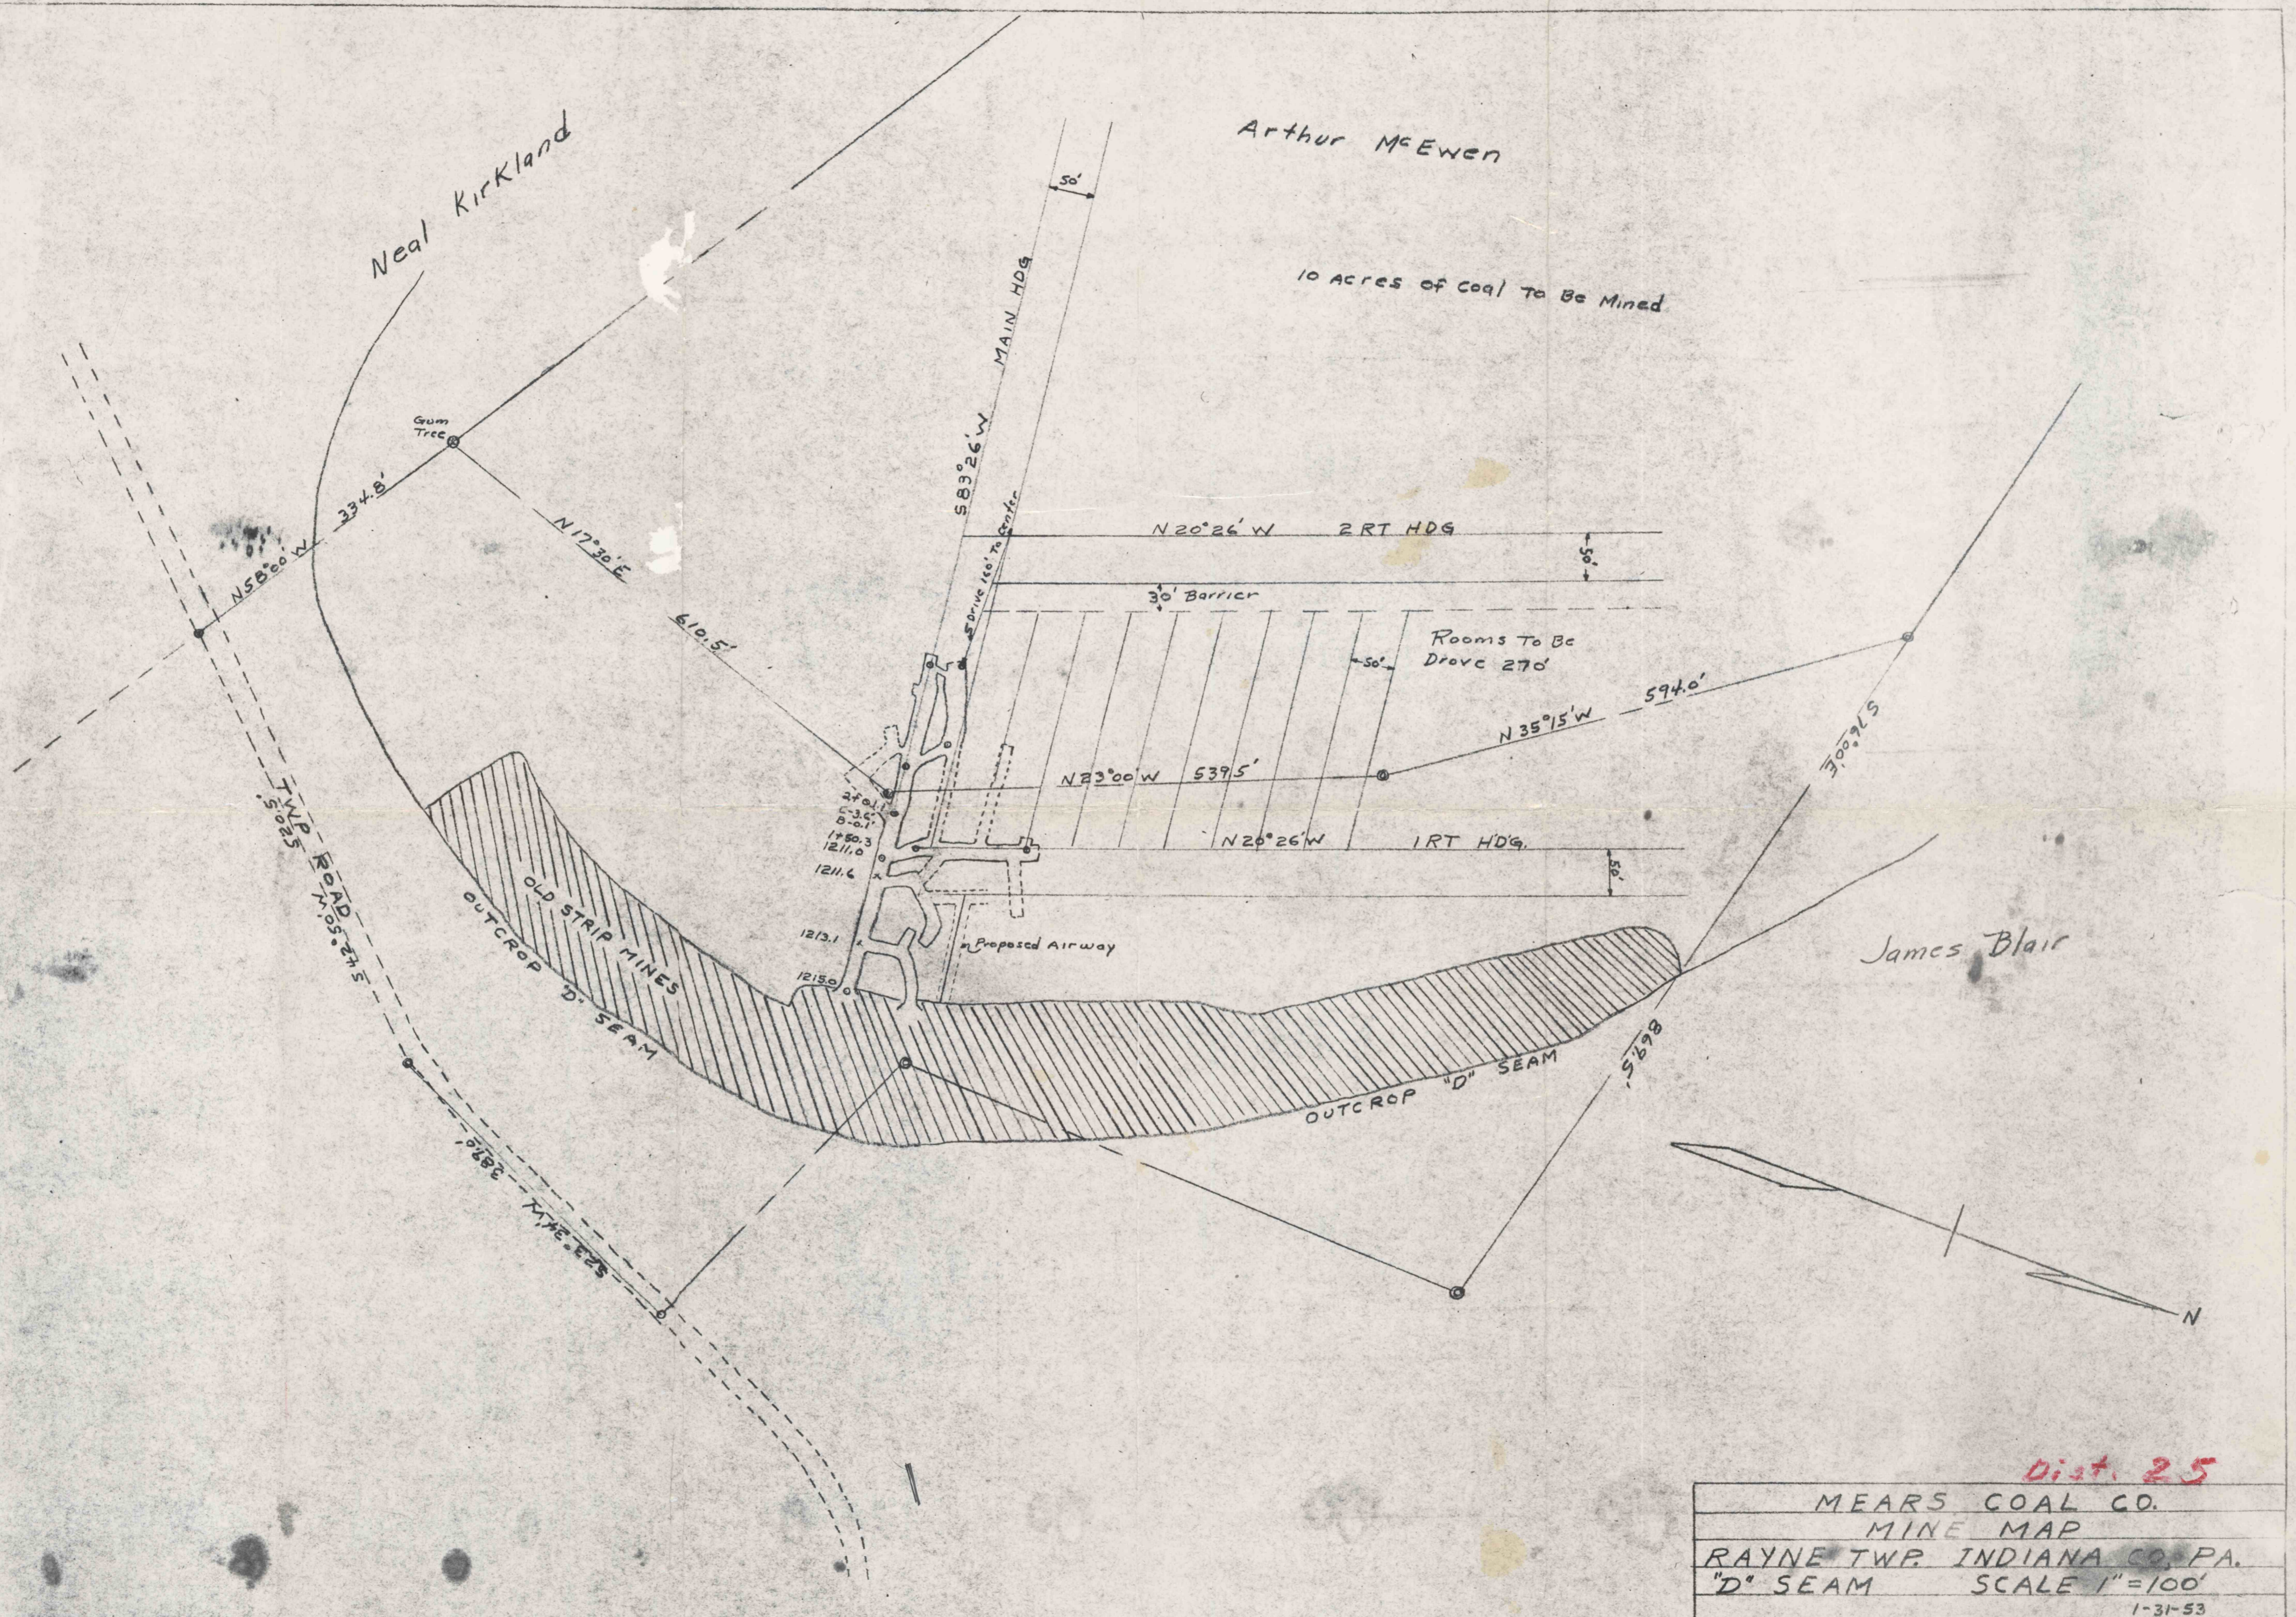

Dist. 25

MEARS COAL CO.
MINE MAP
RAYNE TWP. INDIANA CO. PA.
"D" SEAM SCALE 1" = 100'
1-31-53

#4194
MS
7-11-02