


N  
1" = 100'

1100  
1/25/54

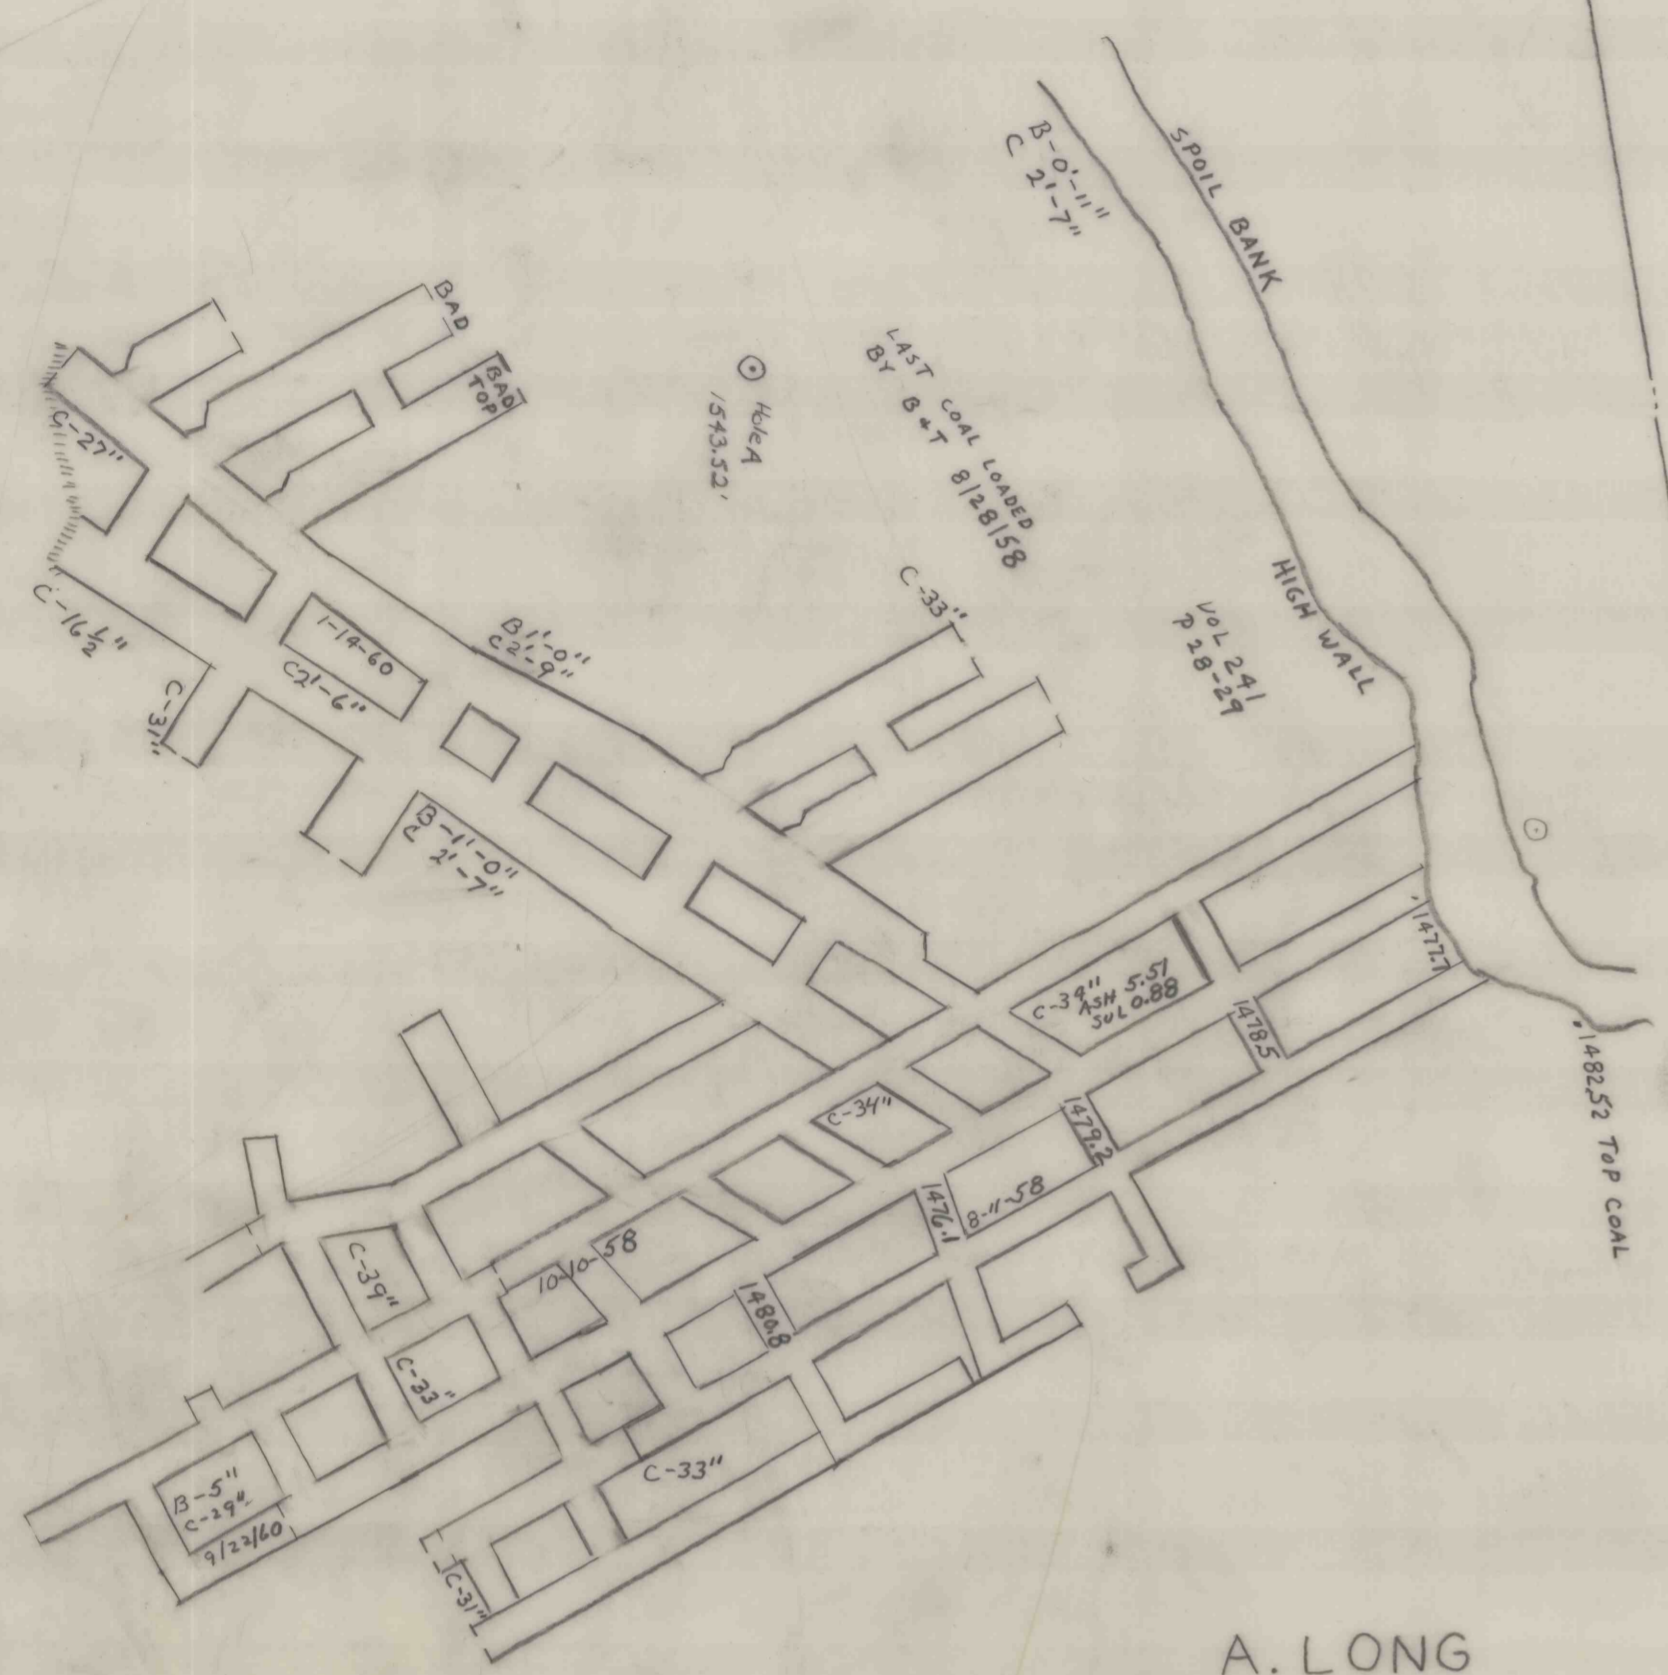

A. LONG

7.25 Ac



J. W. WHITED

SOURCE: HARD COPY OF BARNESDORF AREA

No. 21 MINE

4200  
Drawer Q5

R-2247