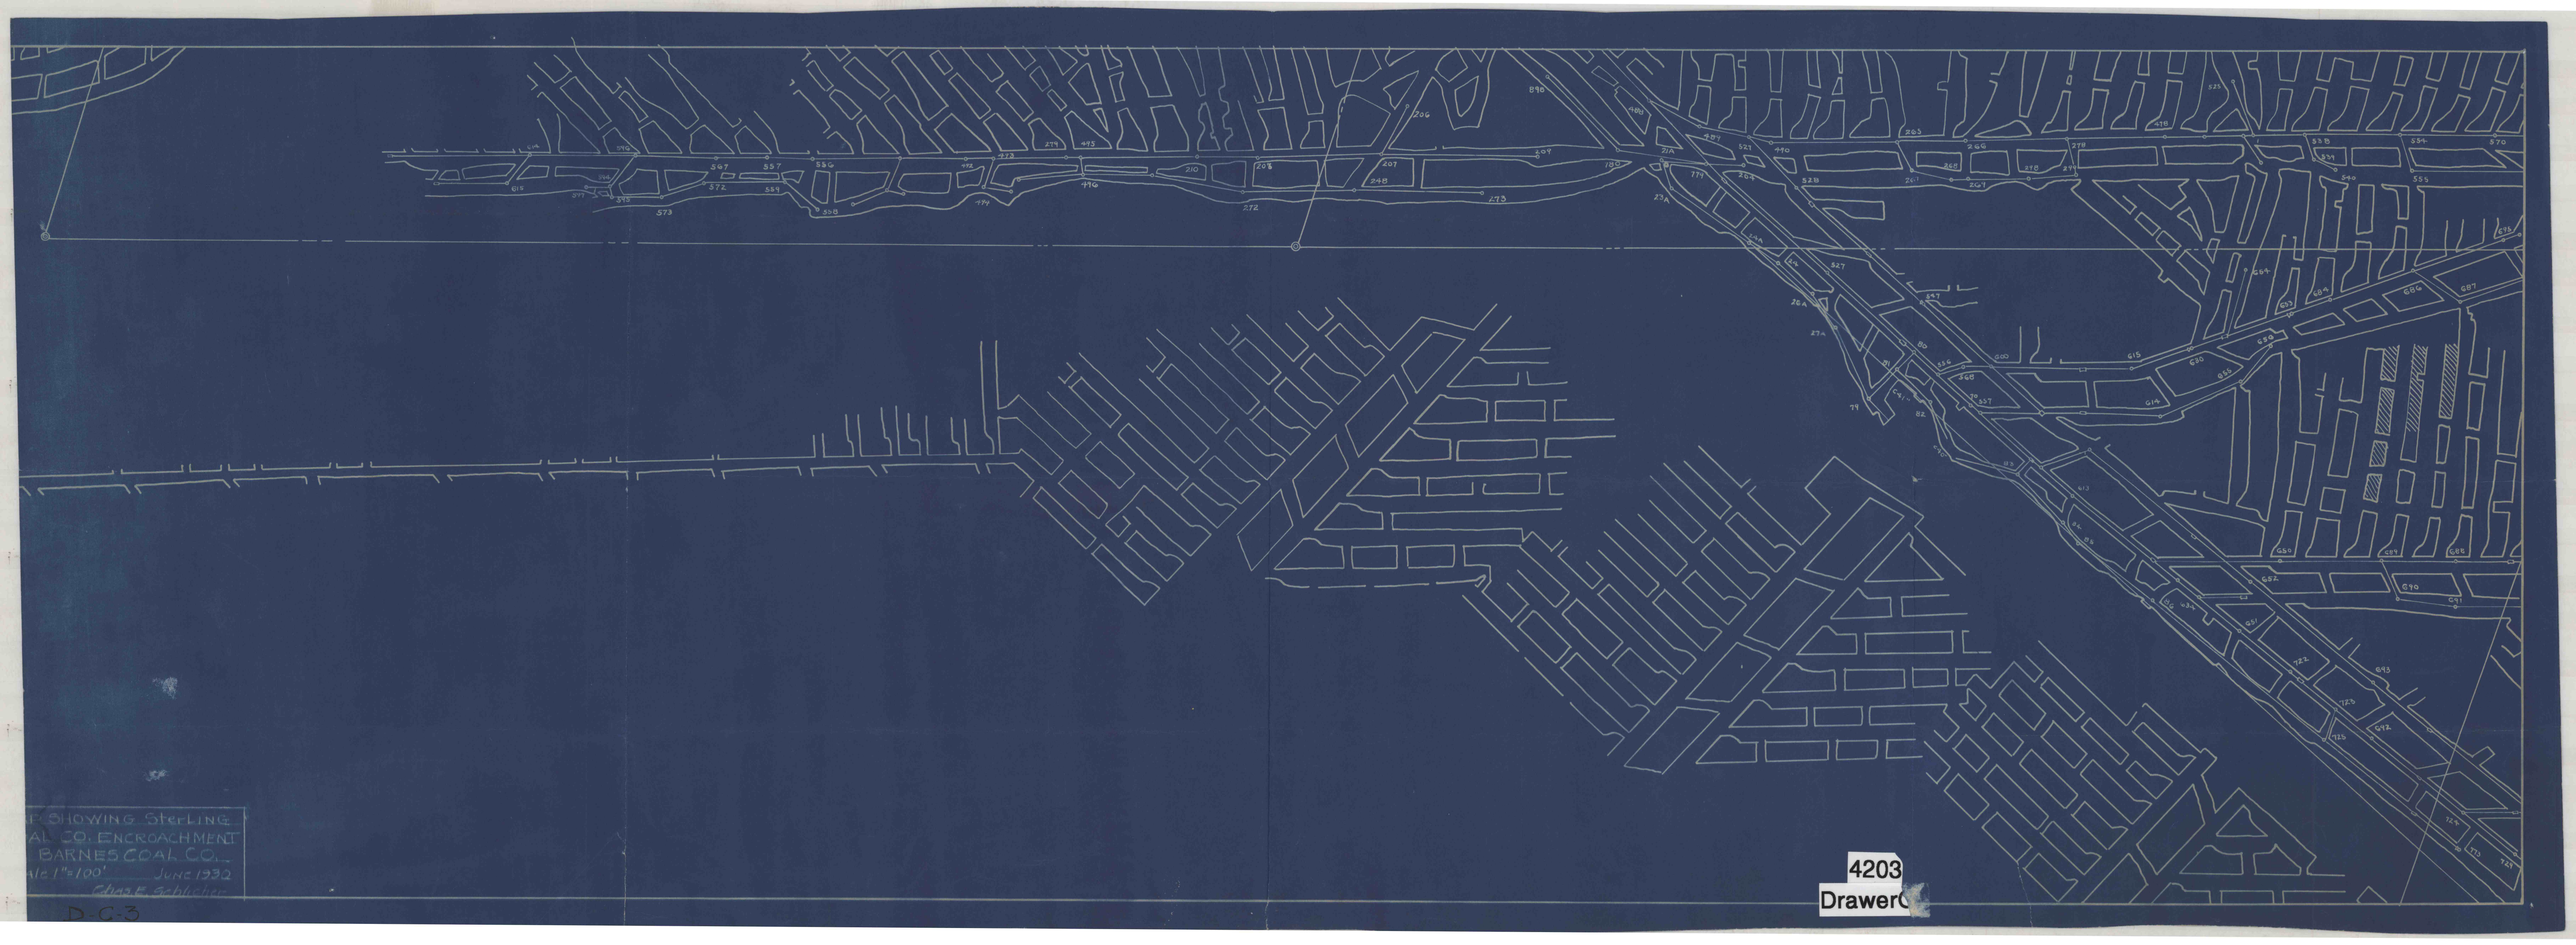

4203
Drawer C

D-C-3