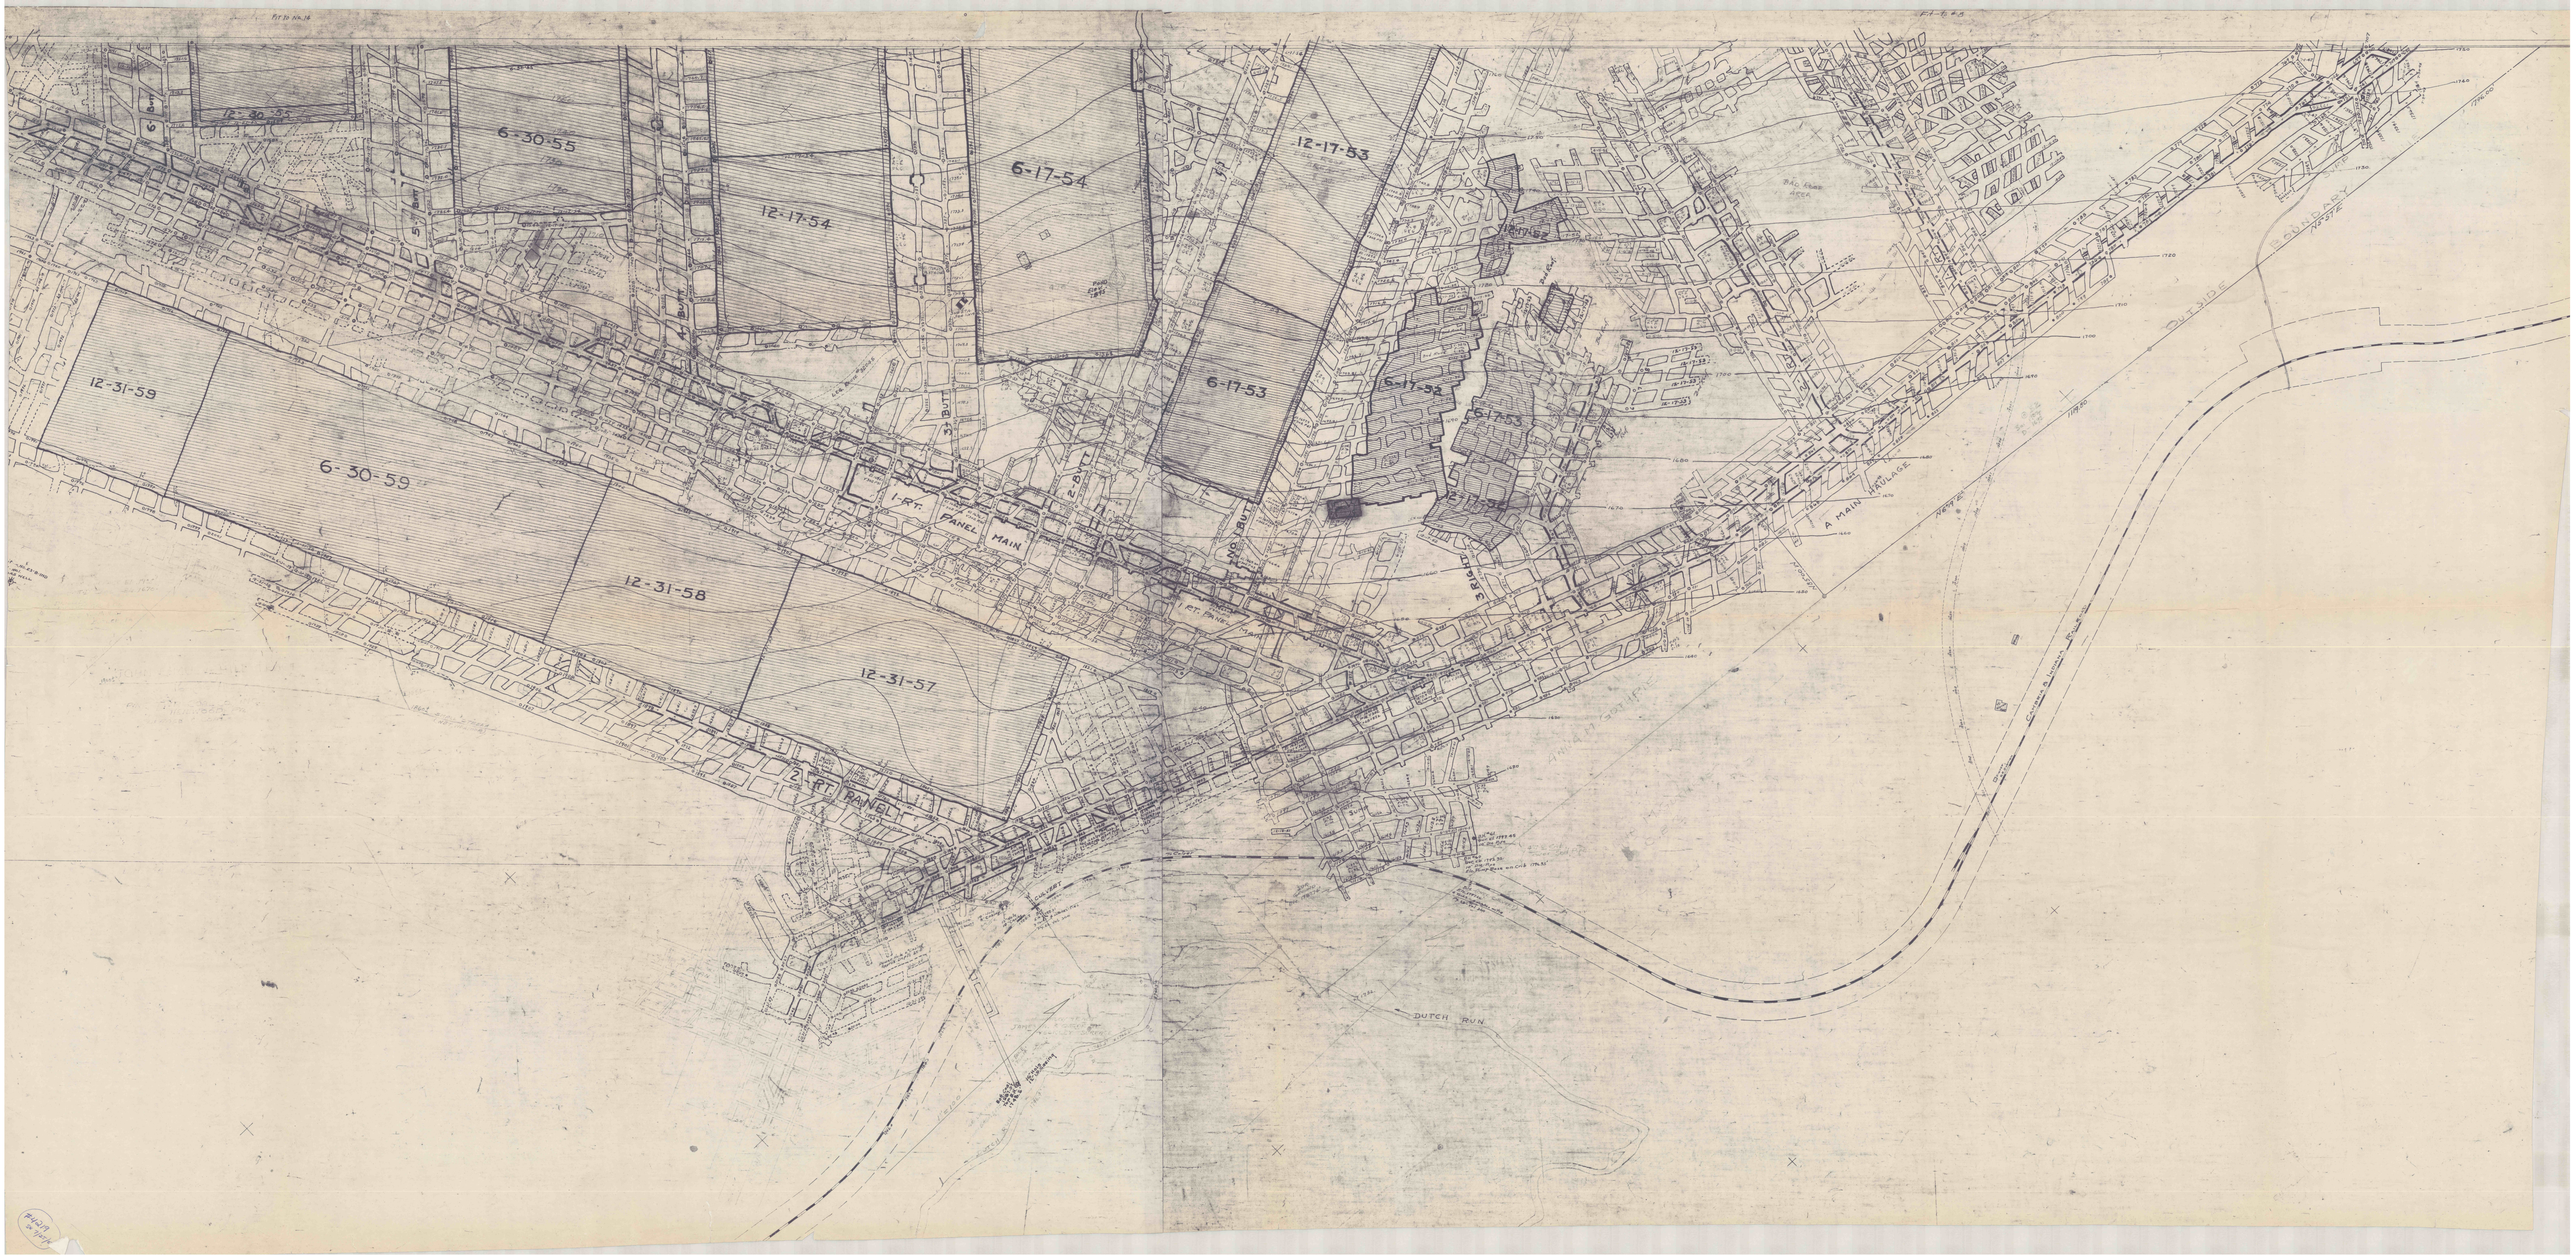
6-30-55
12-17-54
6-17-54
12-17-53
12-31-59
6-30-59
12-31-58
12-31-57
6-17-53
6-17-52
1 FT. PANEL MAIN
2 FT. PANEL
3 BELT
2 BELT
1 BELT
A MAIN HAULAGE
OUTSIDE BOUNDARY
DUTCH RUN