

Location of a Water Line Across the Track of the C & C Div. P.R.R.


at the Plant of the Bells Mill Coal Co. East of Josephine Pa

Scale 1 in. = 100 Ft.

Feb. 26 1908

Albert Smith, Eng.

PITMOUTH

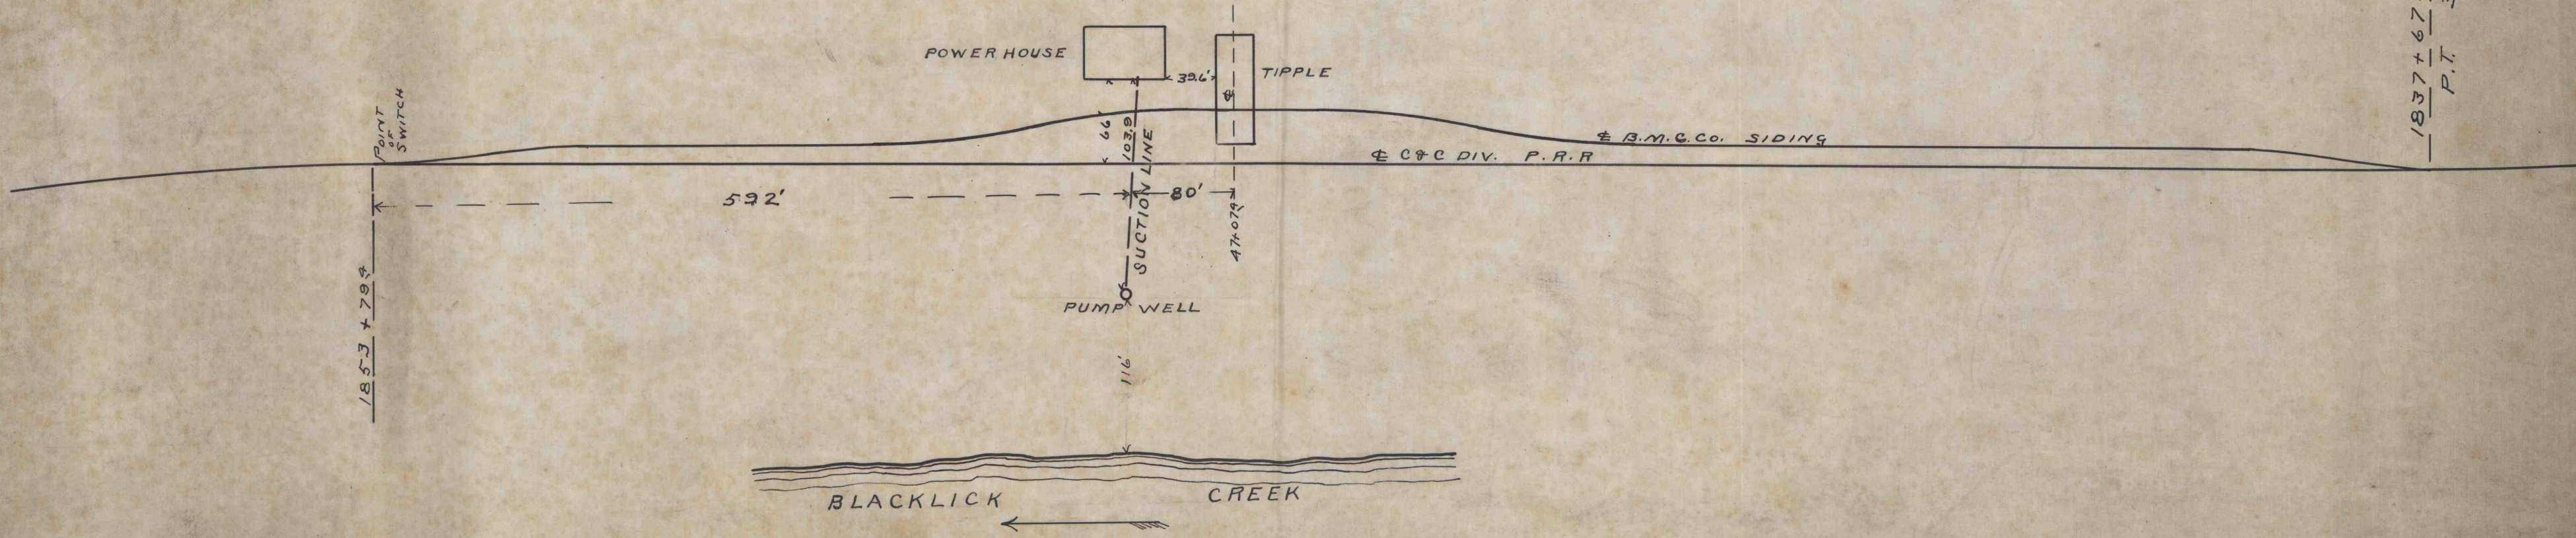

1837 + 67 8  
P.T. 30.

B.M. 2549-5-9  
5808