



CLINE & SNYDER

ALBERT E. SCHOTT'S

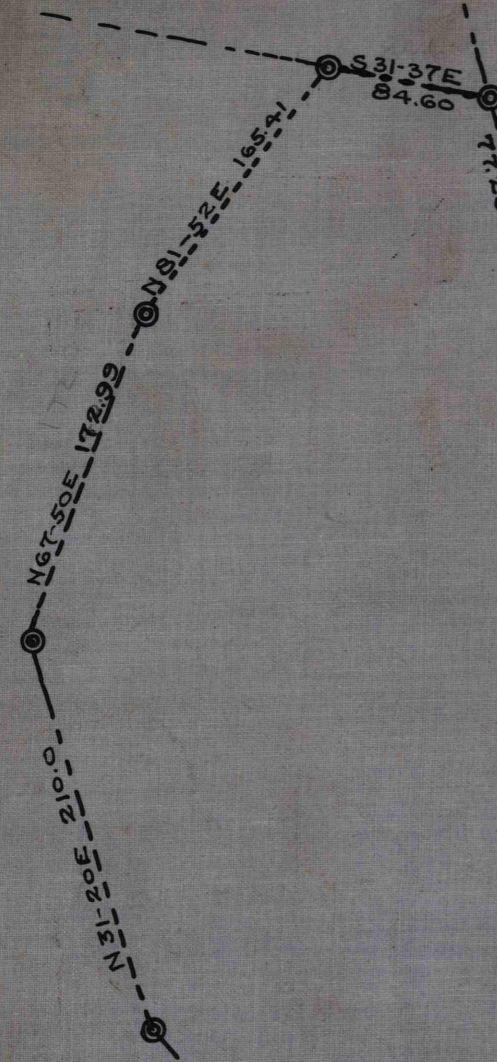


S34-41E 1011.48

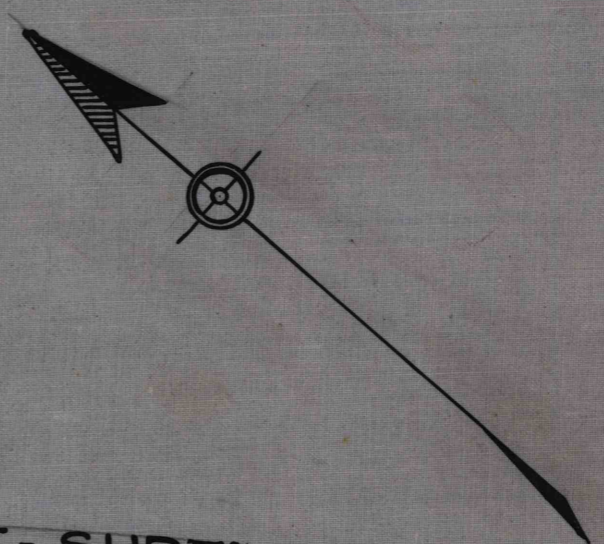

J.R. CLINE - SURFACE

COAL:-
 SEGER BROTHERS COAL CO. INC.
 TO
 WESTMORELAND MINING CO.
 NET COAL AREA 22.805A.

ALBERT E. SCHOTT'S
 S40-36W 952.47

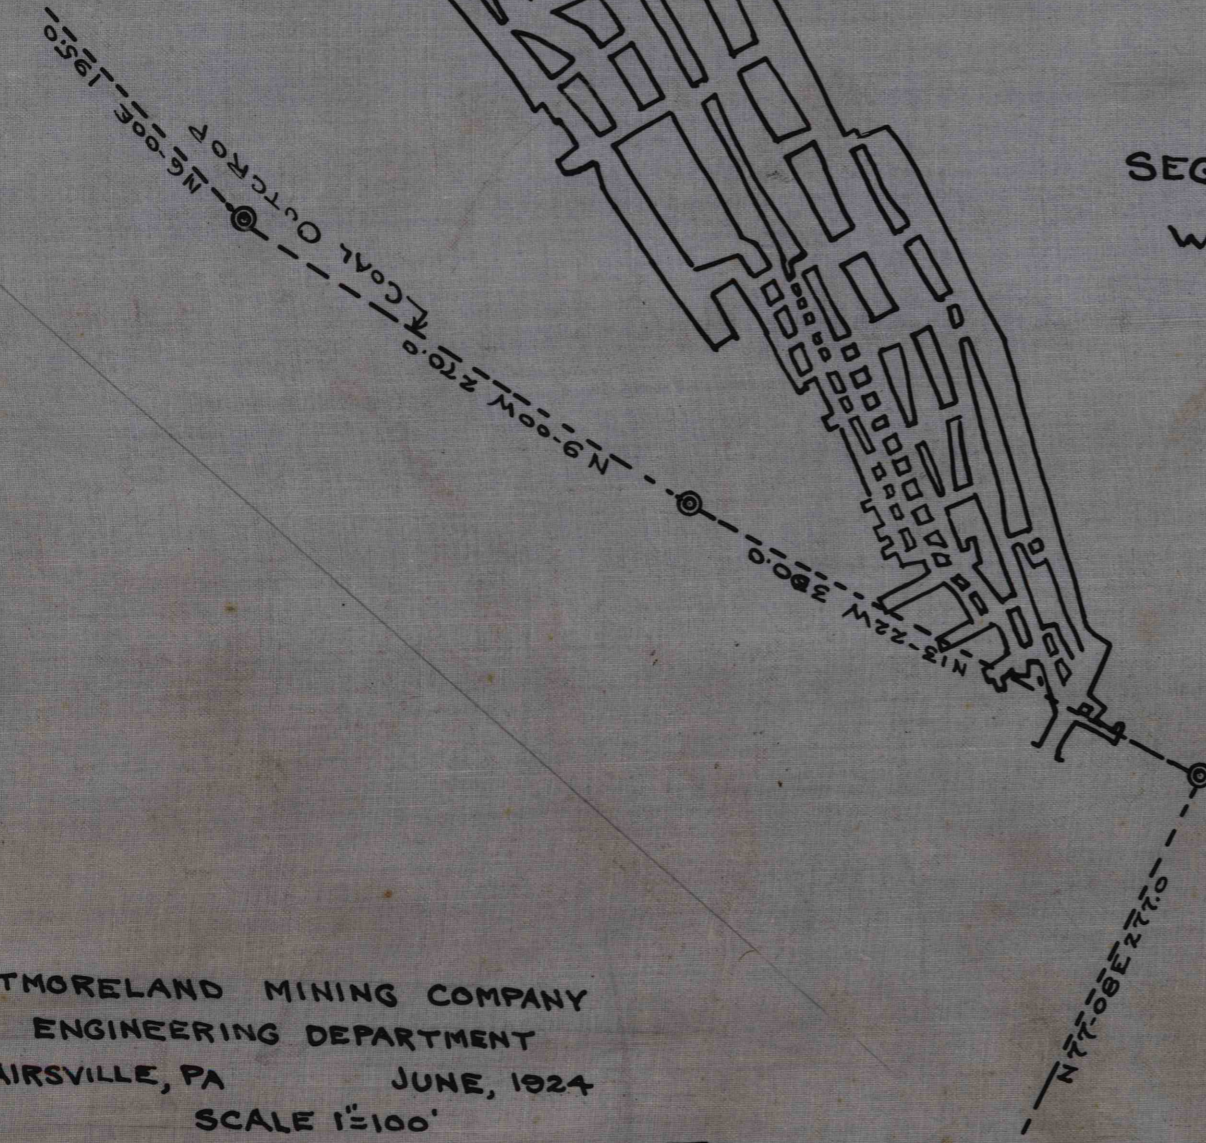

WESTMORELAND MINING COMPANY
 ENGINEERING DEPARTMENT
 BLAIRSVILLE, PA JUNE, 1924
 SCALE 1"=100'

LOCATION:-
 DERRY TWP., WESTMORELAND CO., PA.

JOHN HERMANN

4267

BARNETT COAL CO.

5319 West 3149