



WORKINGS
OF THE
GRAFF COAL CO.
UNDER LANDS OF
THOMPSON M^CCREA

SITUATED IN BLACKLICK TWP., INDIANA CO., PA.

SCALE 1" = 100 FT.

SURVEYS,
JUNE 21, 1911
OCT. 5, 1911

ALBERT SMITH C.E.
SALTSBURG PA.

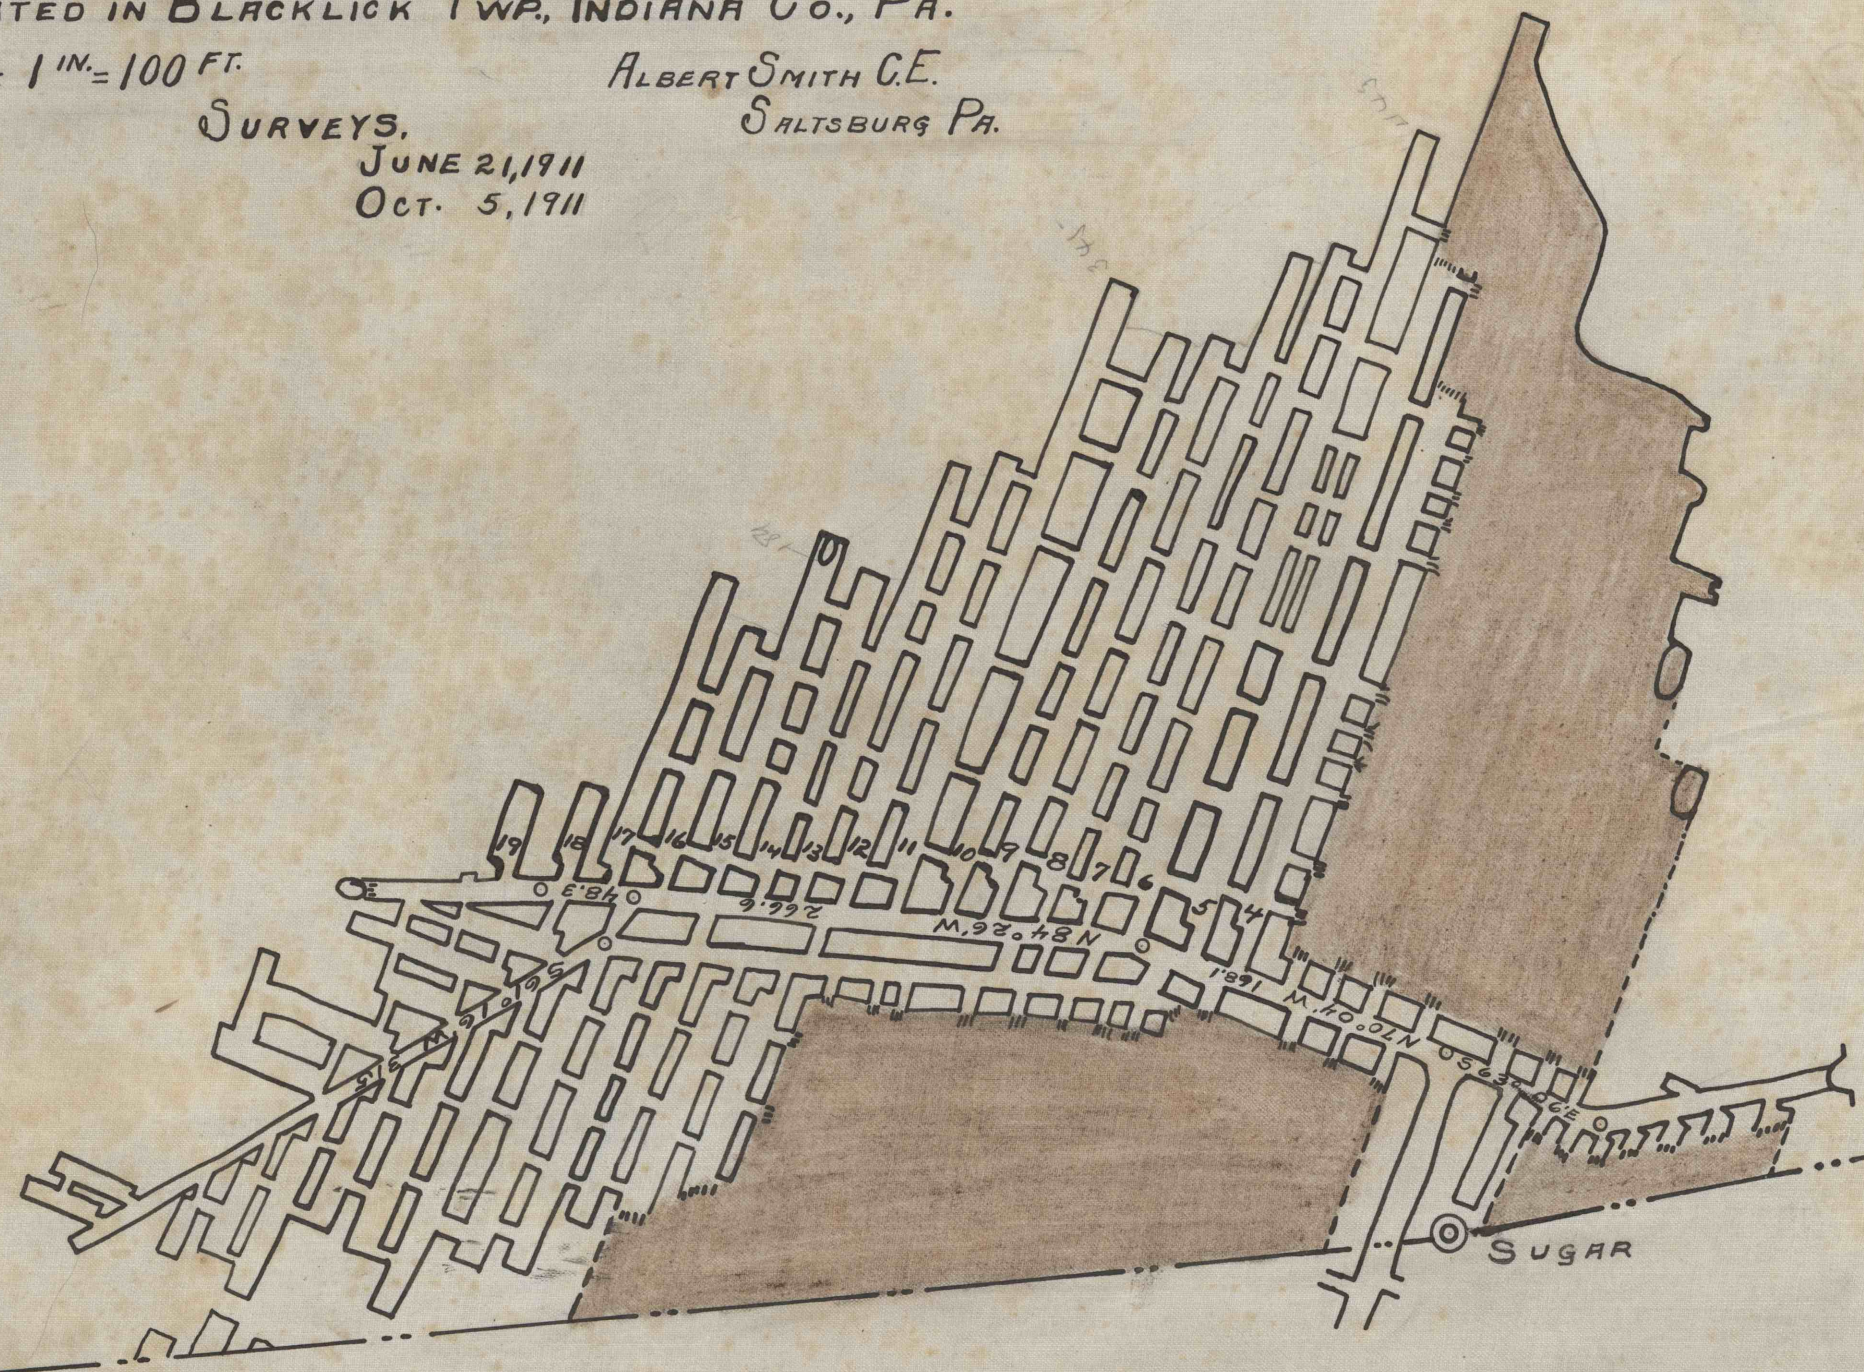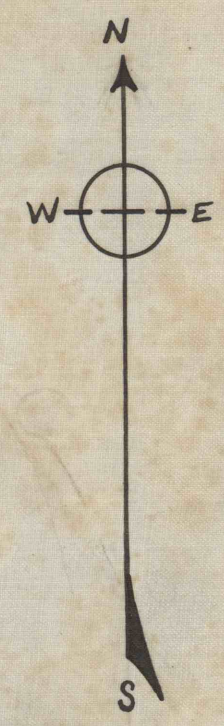

WALNUT

JAS

DIXON

4269

5330
G.C. ~~2688~~-54