



6" GAS LINE P.N.G.CO.

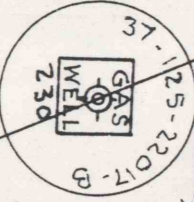

2-SOUTH

9-1-02

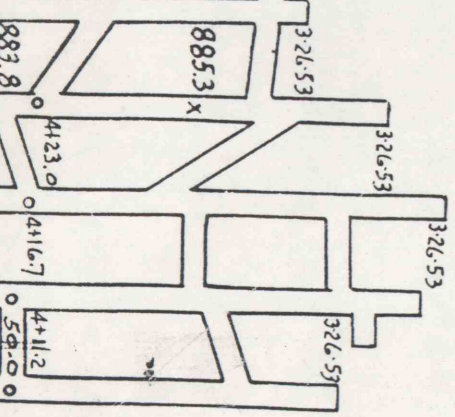

1075.1

92+6

92+3

7+20
STON
8137

8123
8127
8128

571+9

8167

3+84

8143

2+88

8136

1+92

8108

885.1

8+88

7939

884+8

8+88

8163

3+84

8142

2+88

1-1-02

8136

1+92

7929

884+8


















































































