

HENRY AGER

THOS. AGER

GEO. SHERRY

PETER STOLTZ


HENRY HOPPLE

ALEX. BRAWLEY

PETER STOLTZ

MAP OF
BLUBAKER NO. 13
BLUBAKER COAL CO.-LESSORS
"D" SEAM

1891, 1900 SCALE 1"=100'

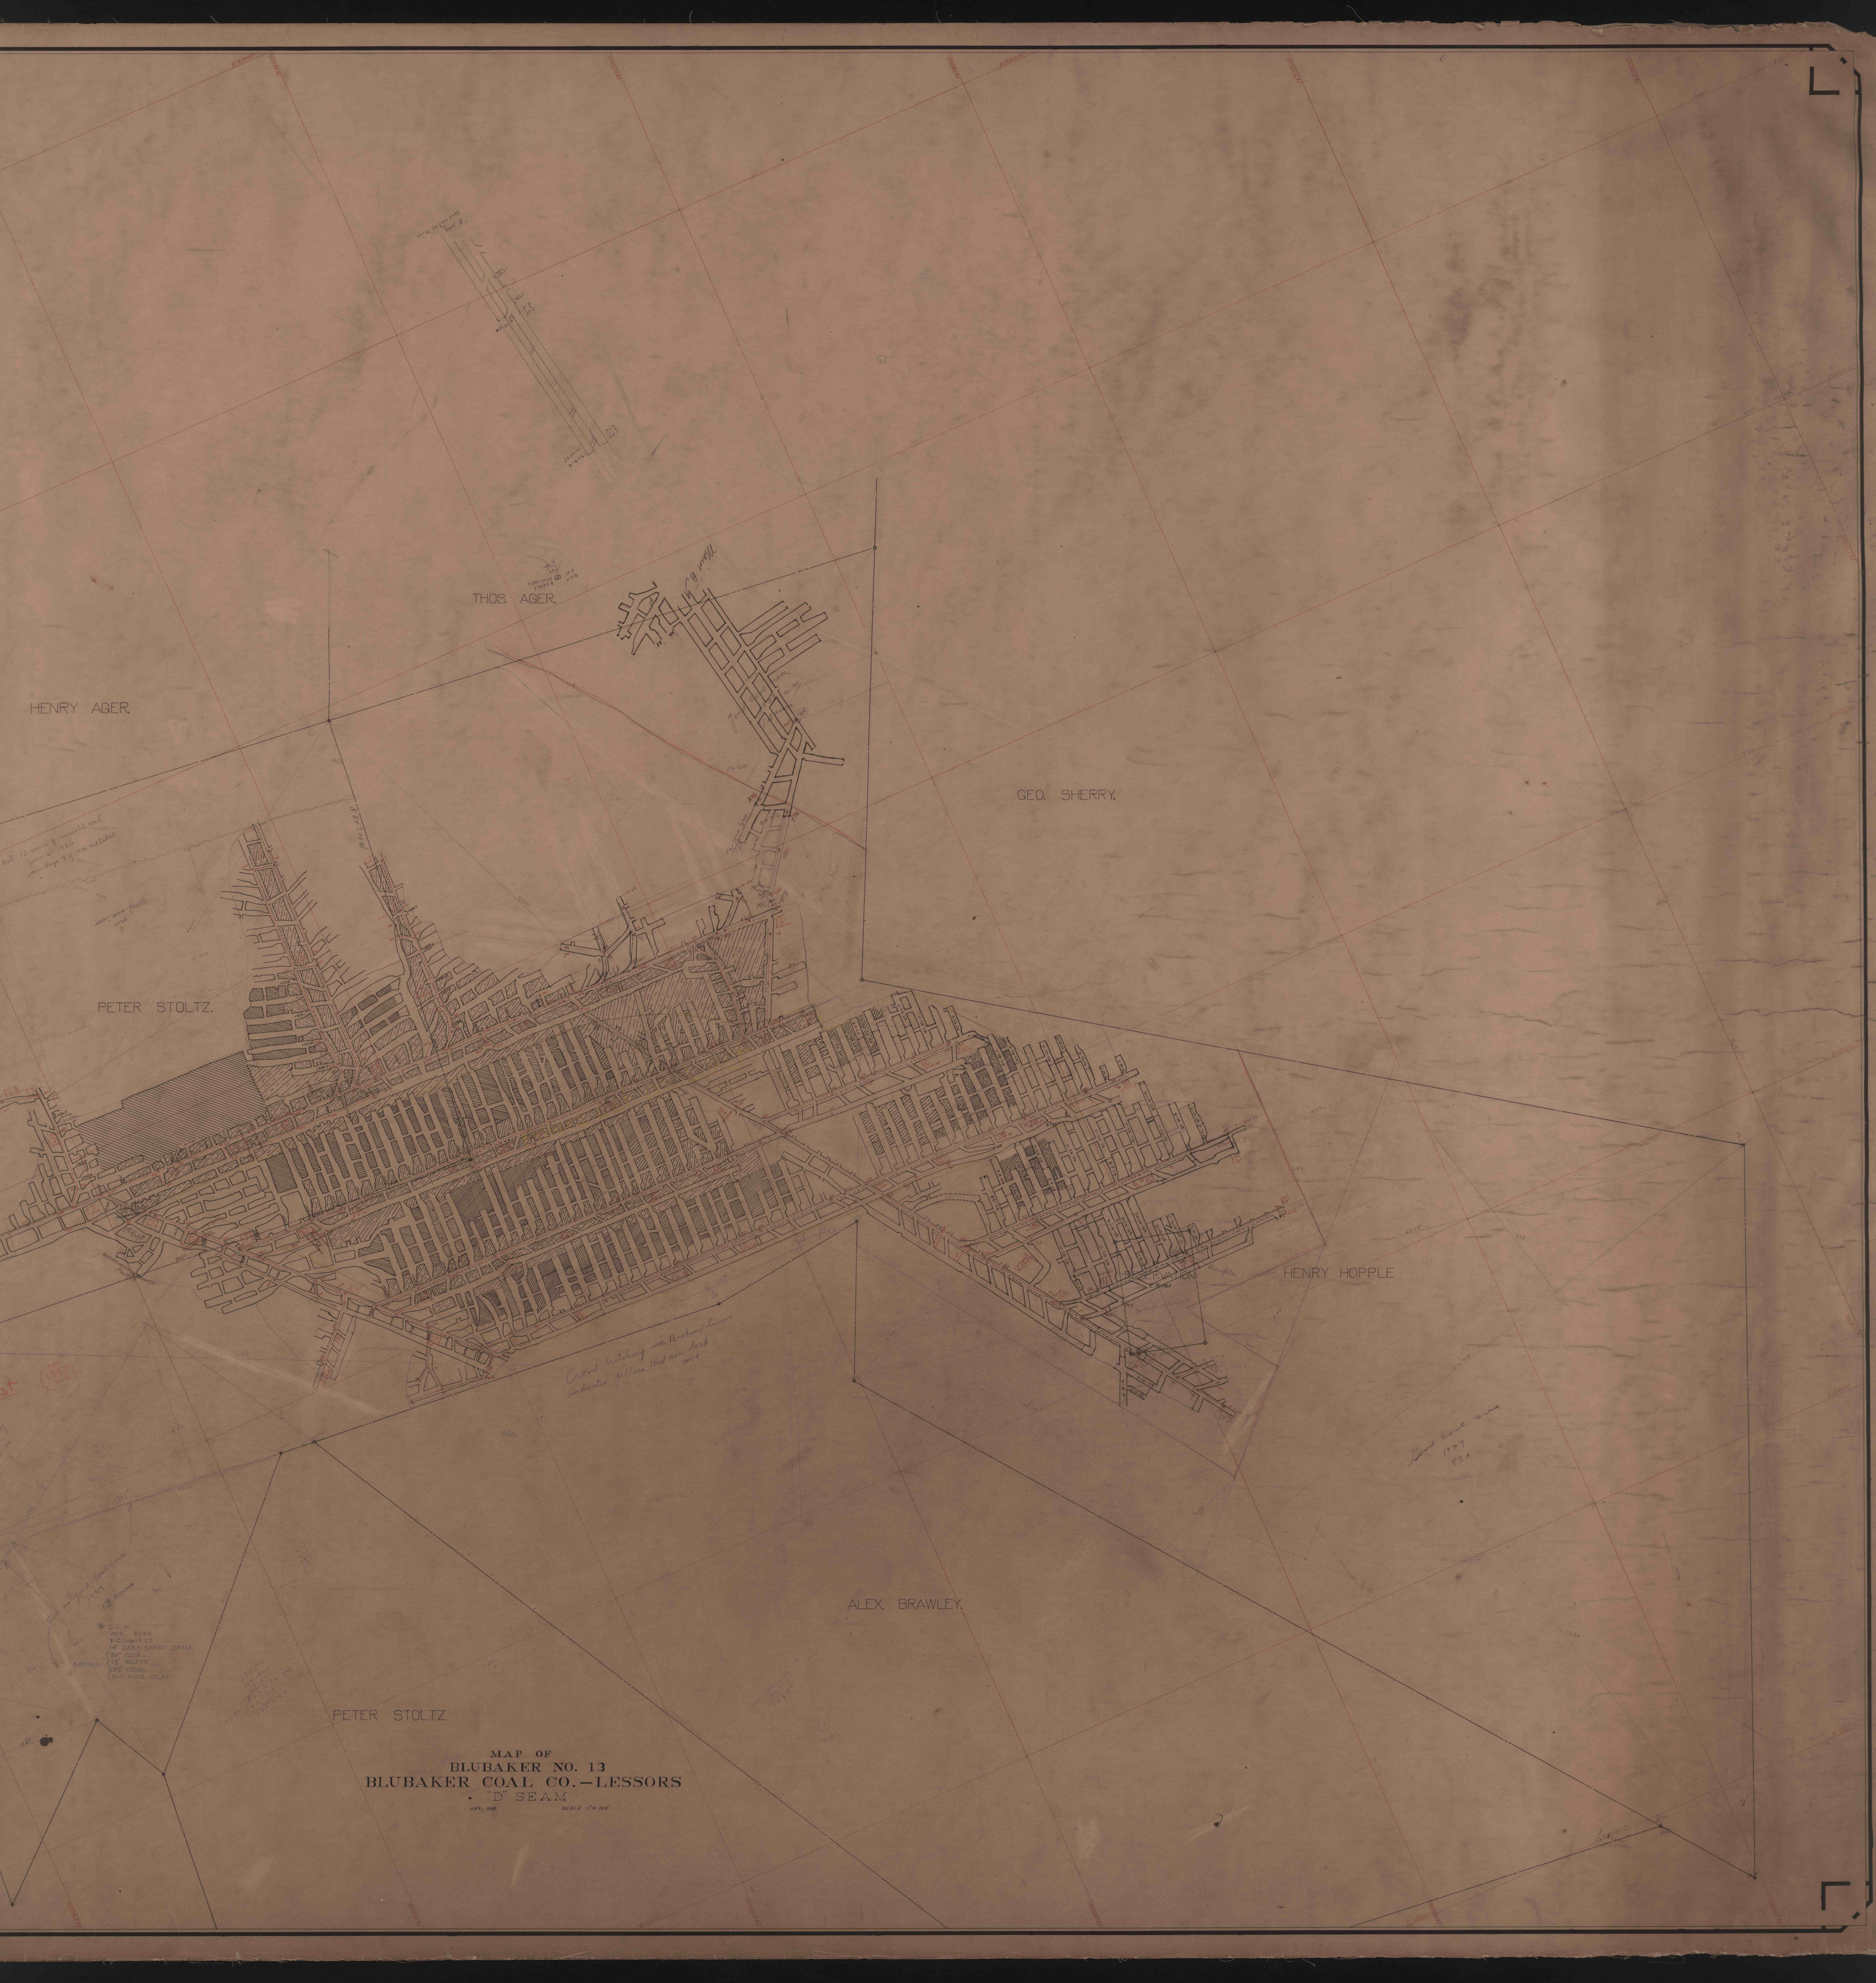

Not 10 acres of minerals and
more or less of the same
and more or less of the same

Good sectioning in the lower
indicates fullness that are lost


D.C.H.
1891, 1900
14" DARK SANDY SHALE
12" COAL
