


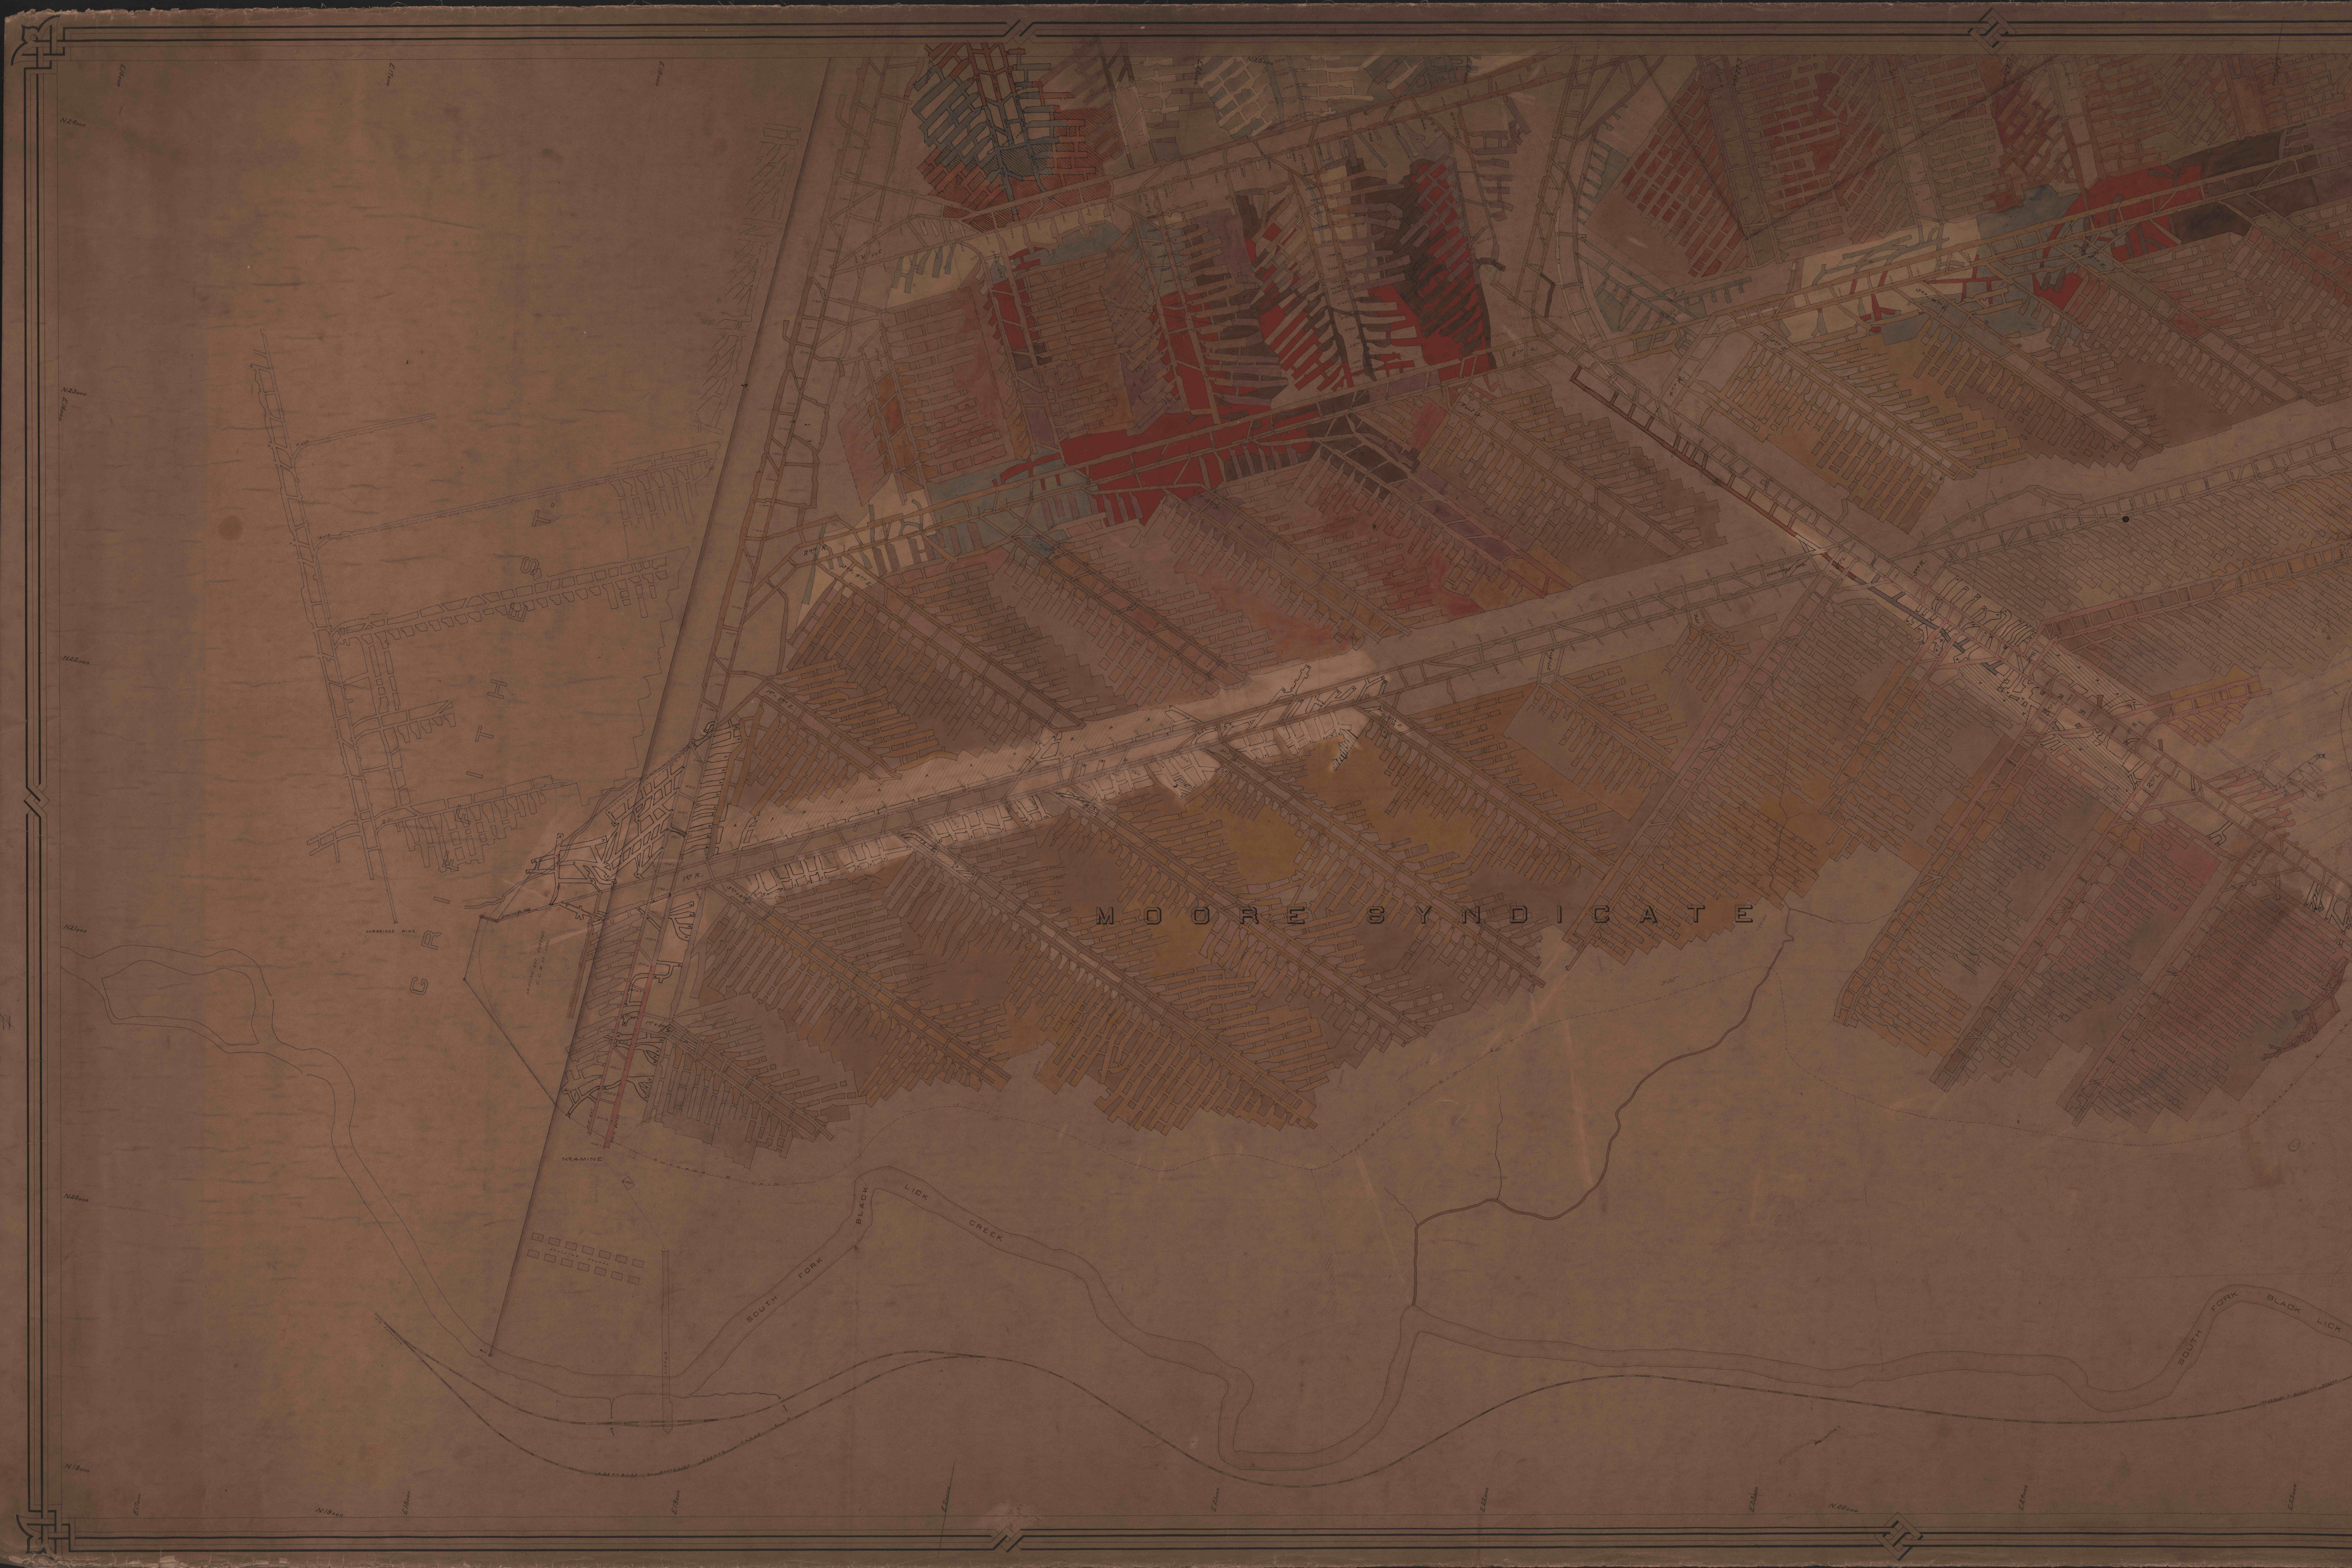

MOORE SYNDICATE

CRI

NEARBY

SOUTH FORK
BLACK LICK
CREEK

SOUTH FORK
BLACK LICK
CREEK