


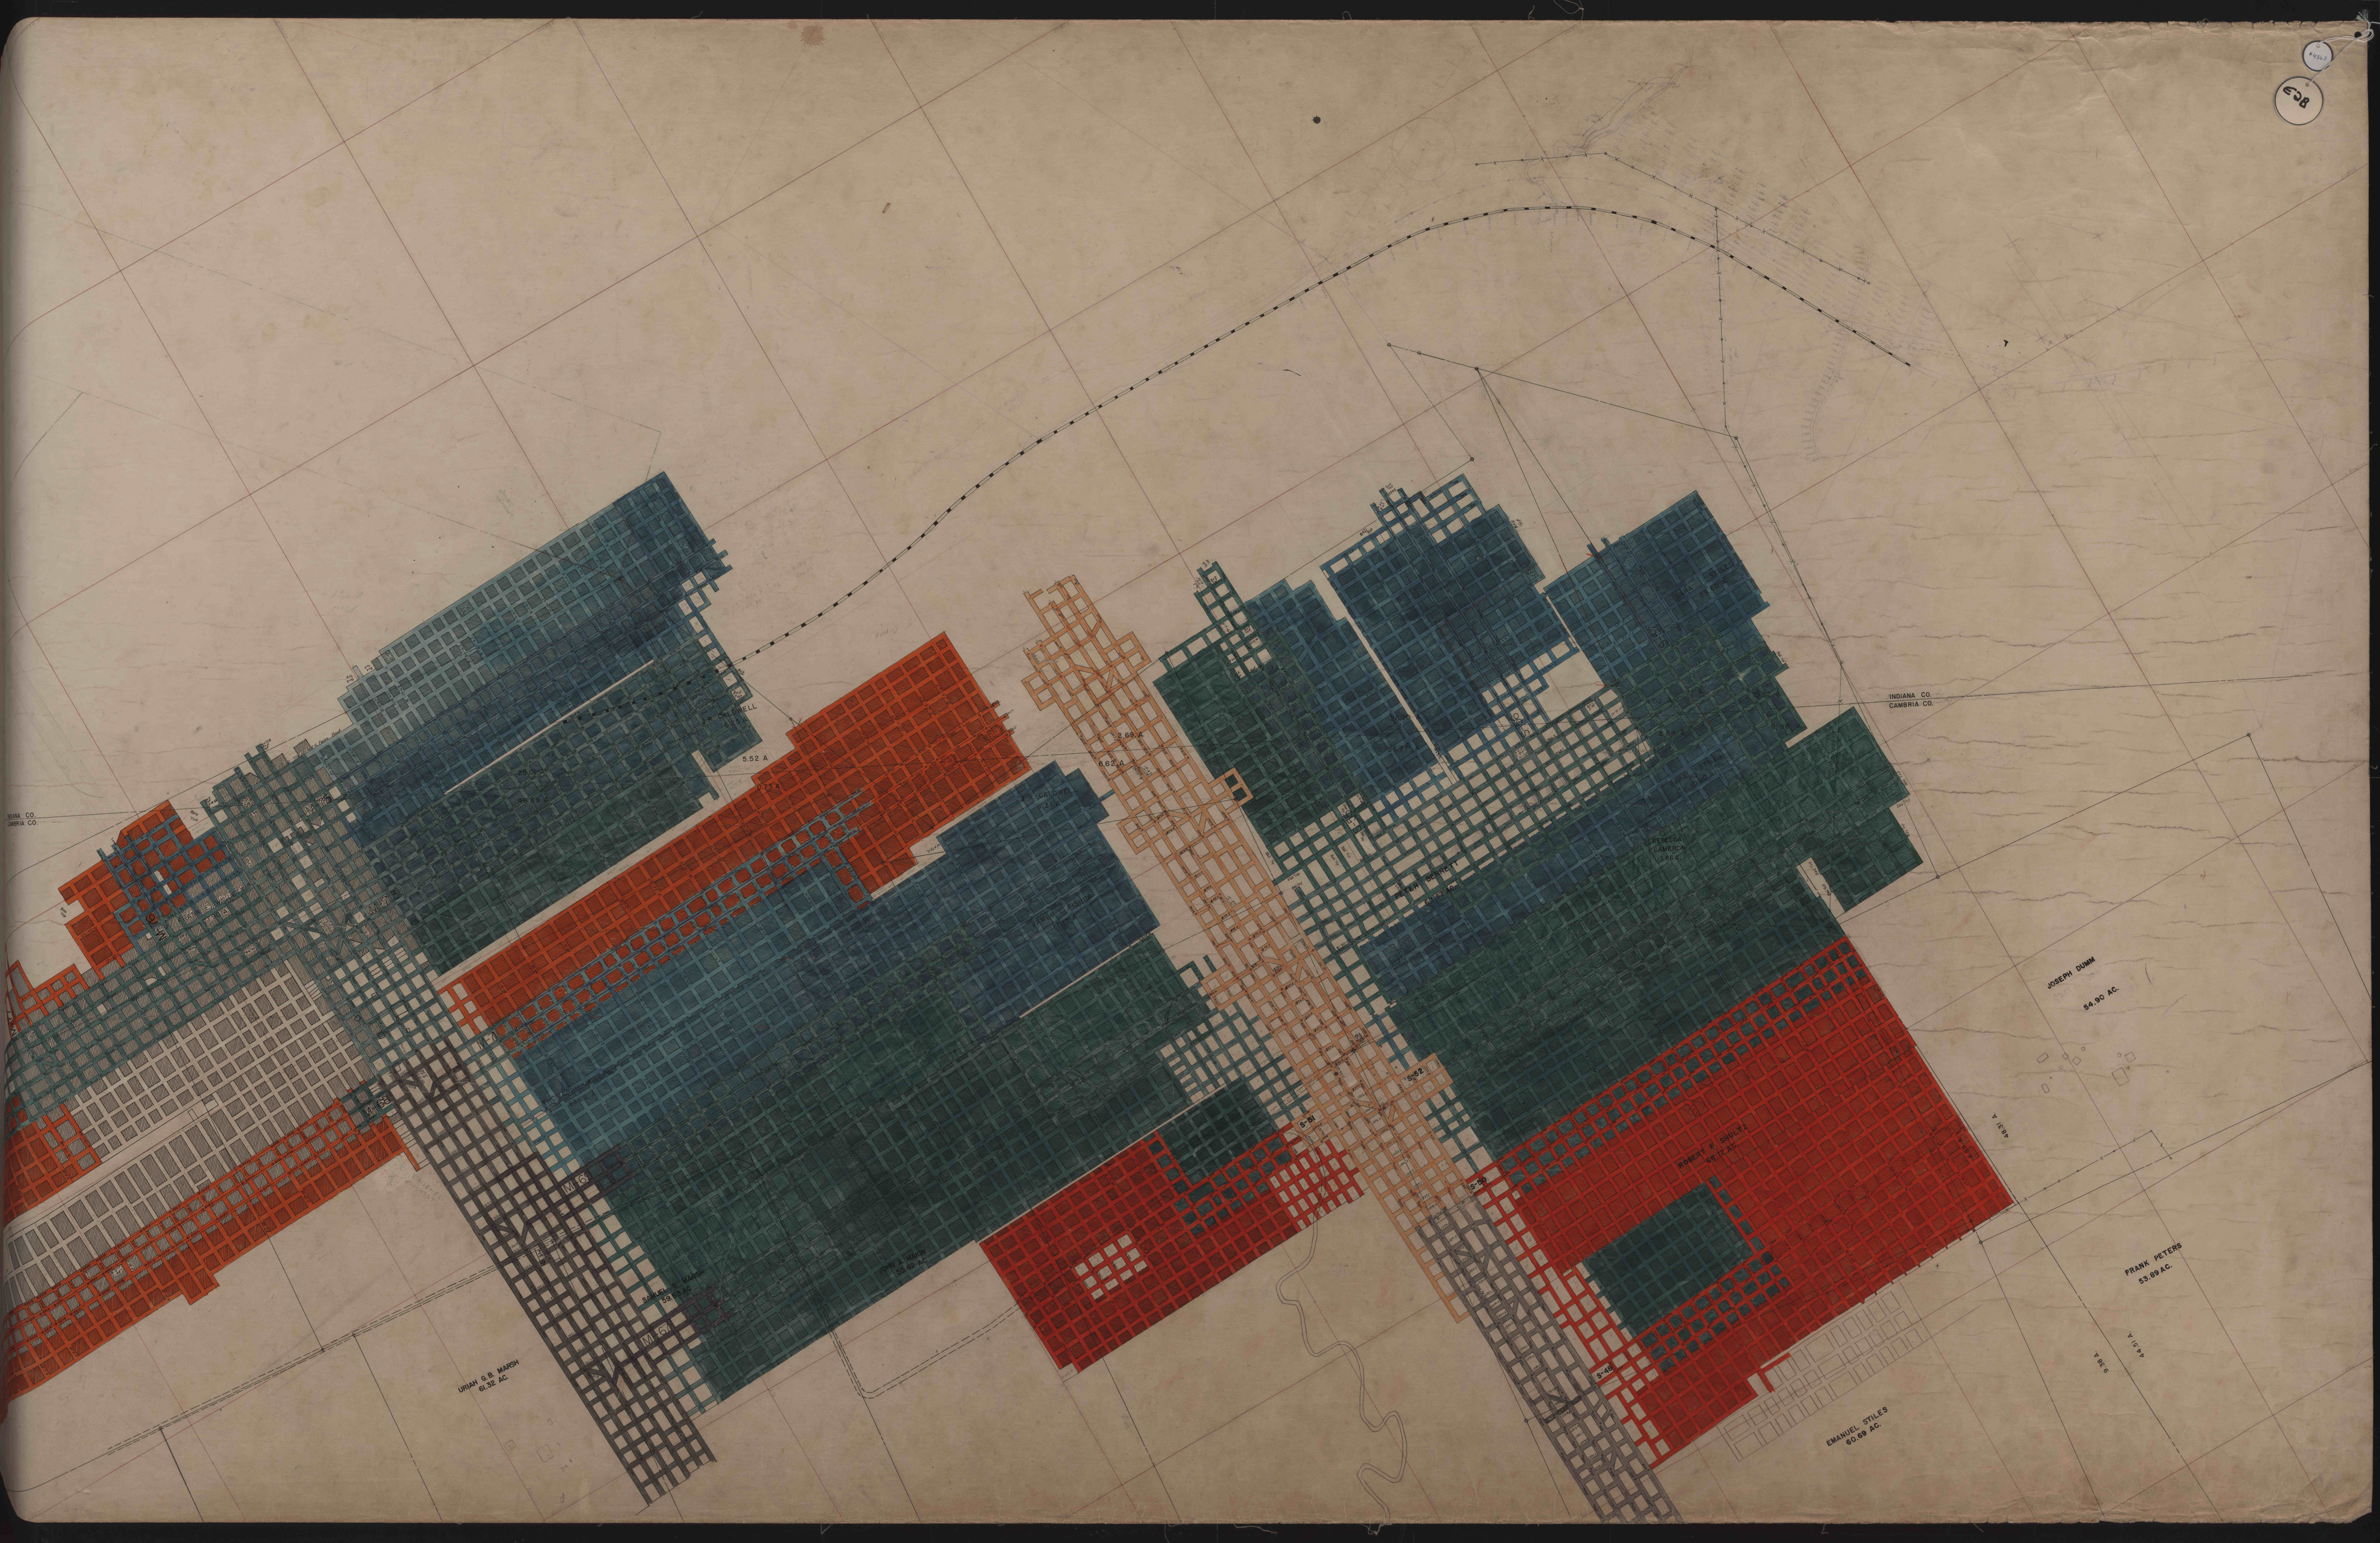

INDIANA CO.
CAMBRIA CO.

INDIANA CO.
CAMBRIA CO.

JOSEPH DUMM
54.90 AC.

FRANK PETERS
55.69 AC.

EMANUEL STILES
60.69 AC.

URVAH G. S. MARSH
61.32 AC.

SHULTZ MARSH
58.89 AC.

JOHN A. MARSH
53.42 AC.

PETER BENNETT
52.46 AC.

ROBERT R. SHULTZ
65.17 AC.

FREDERICK CAMERON
58.66 AC.

5.52 A

6.62 A

2.69

5.28

9.51

5.38

9.48

4.12 A

9.38 A