


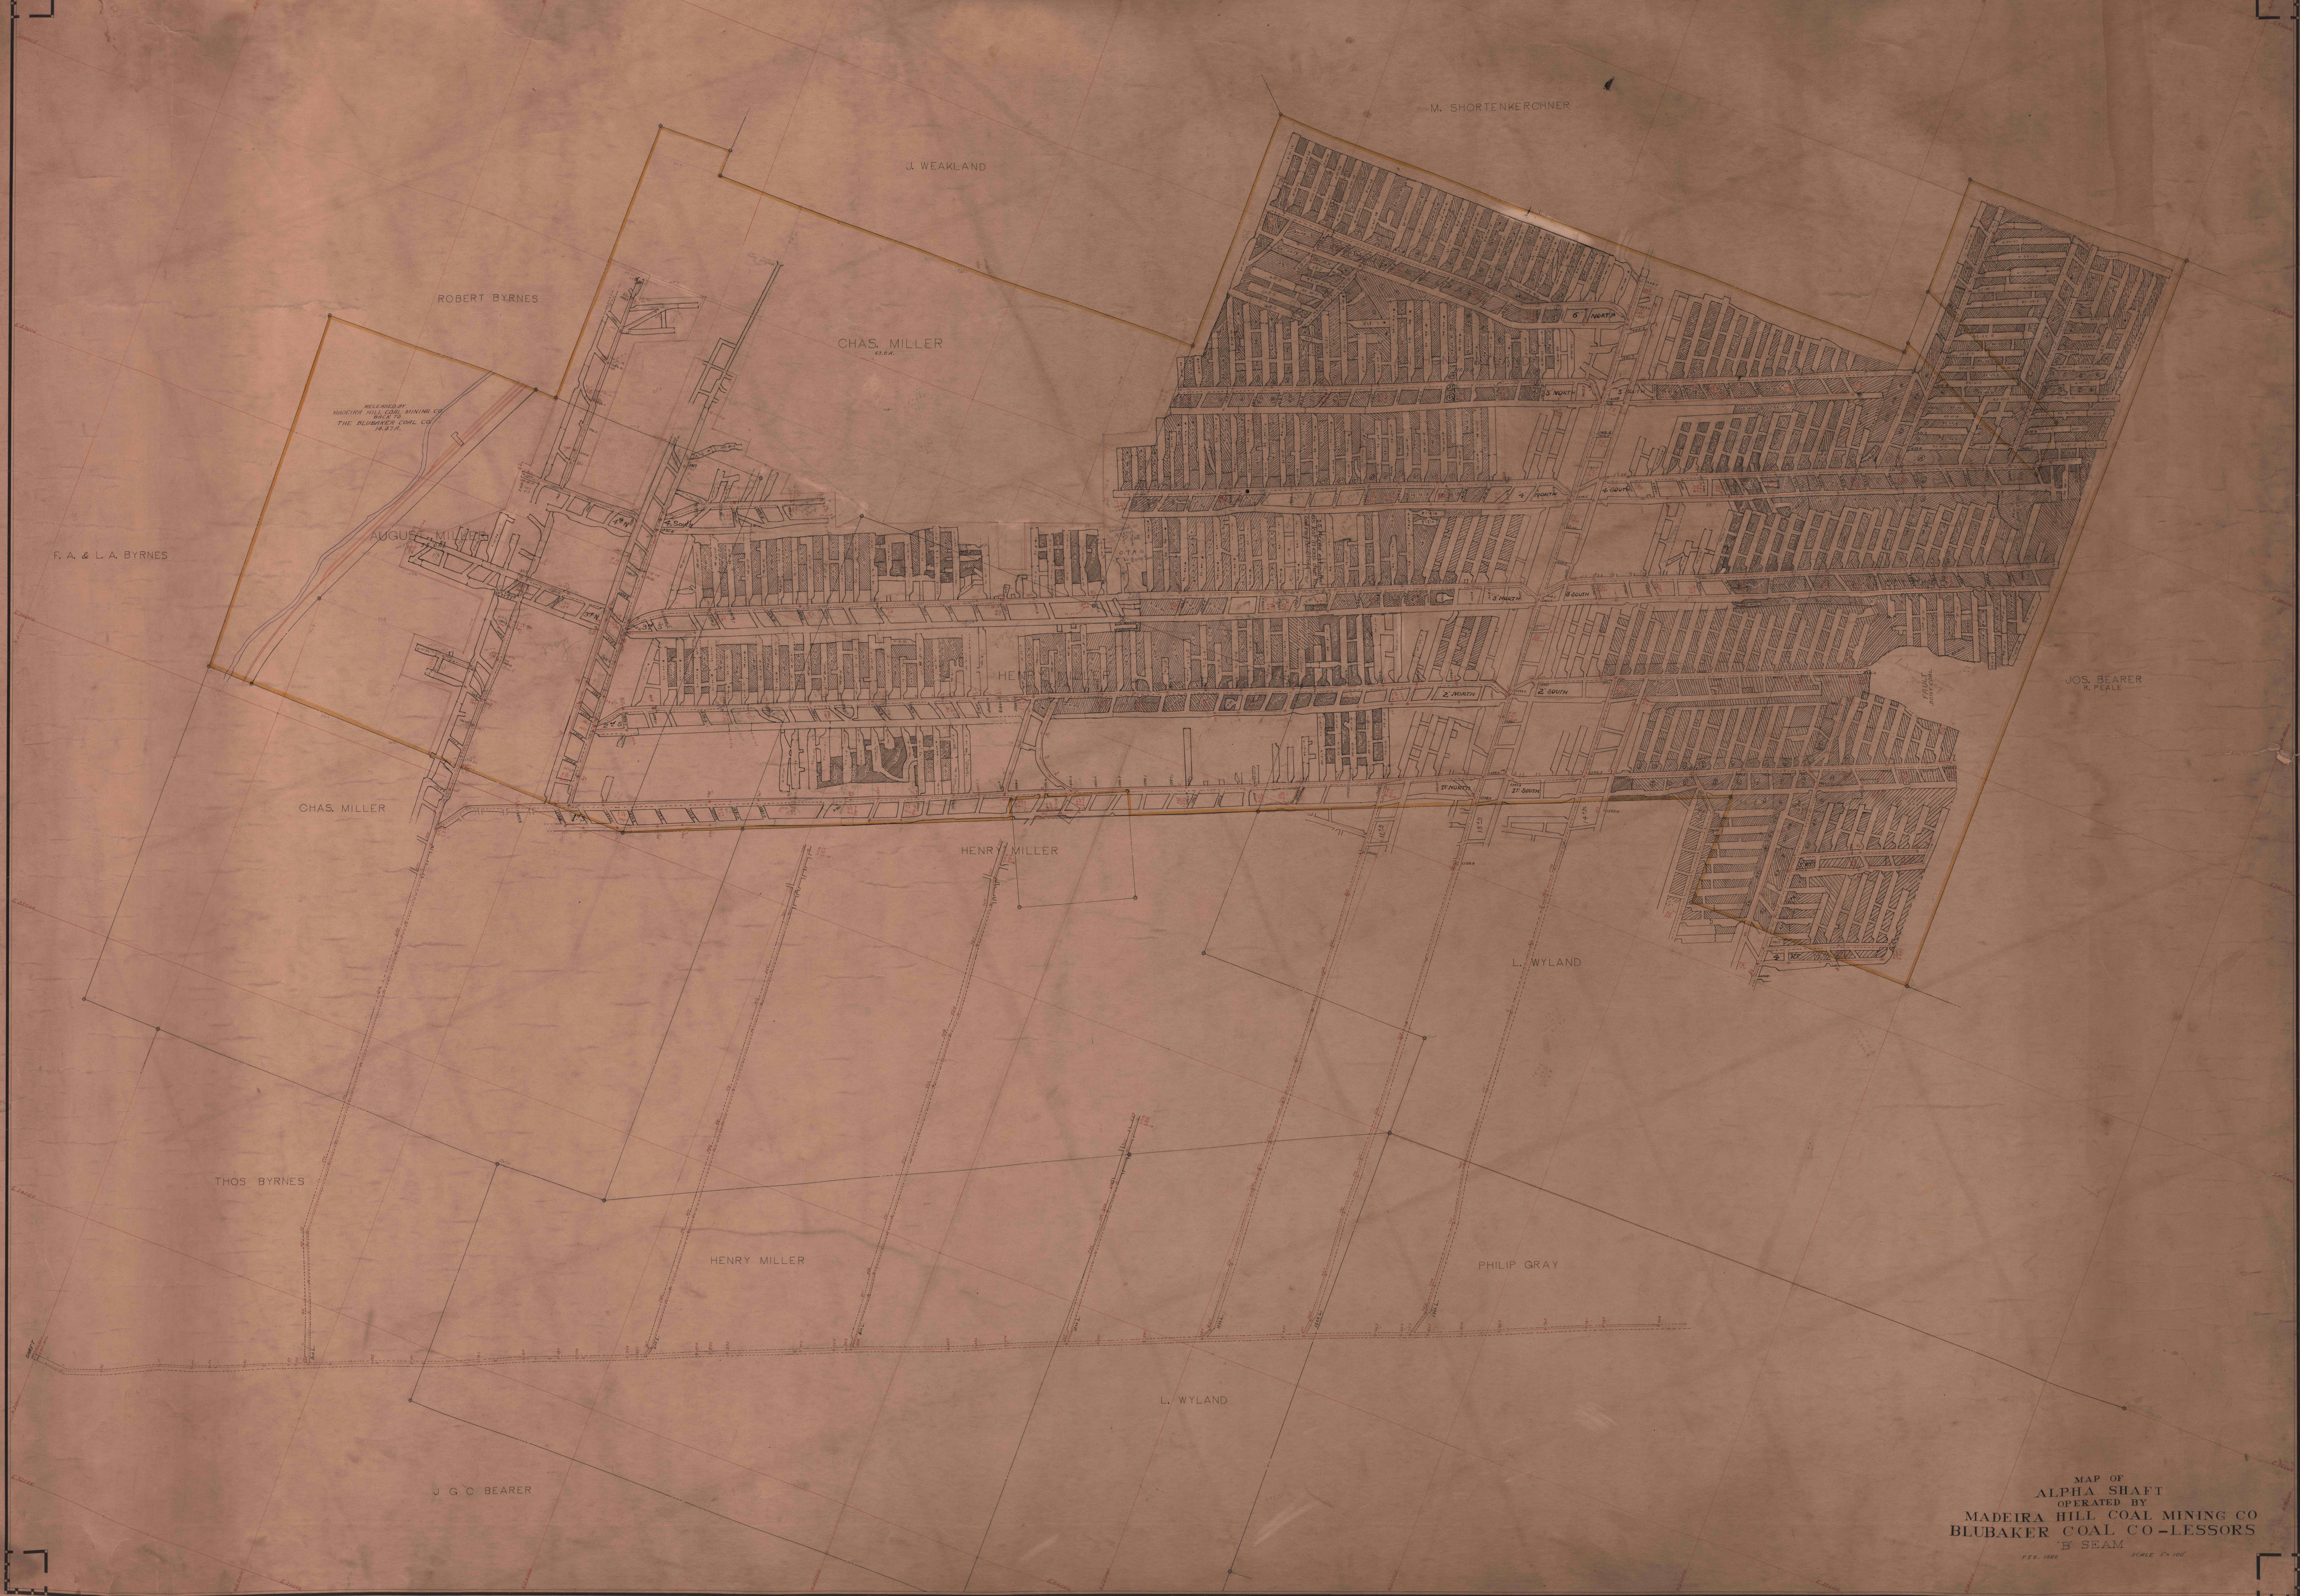

MAP OF
ALPHA SHAFT
OPERATED BY
MADEIRA HILL COAL MINING CO
BLUBAKER COAL CO-LESSORS
B SEAM
FEB. 1900 SCALE 1"=100'