


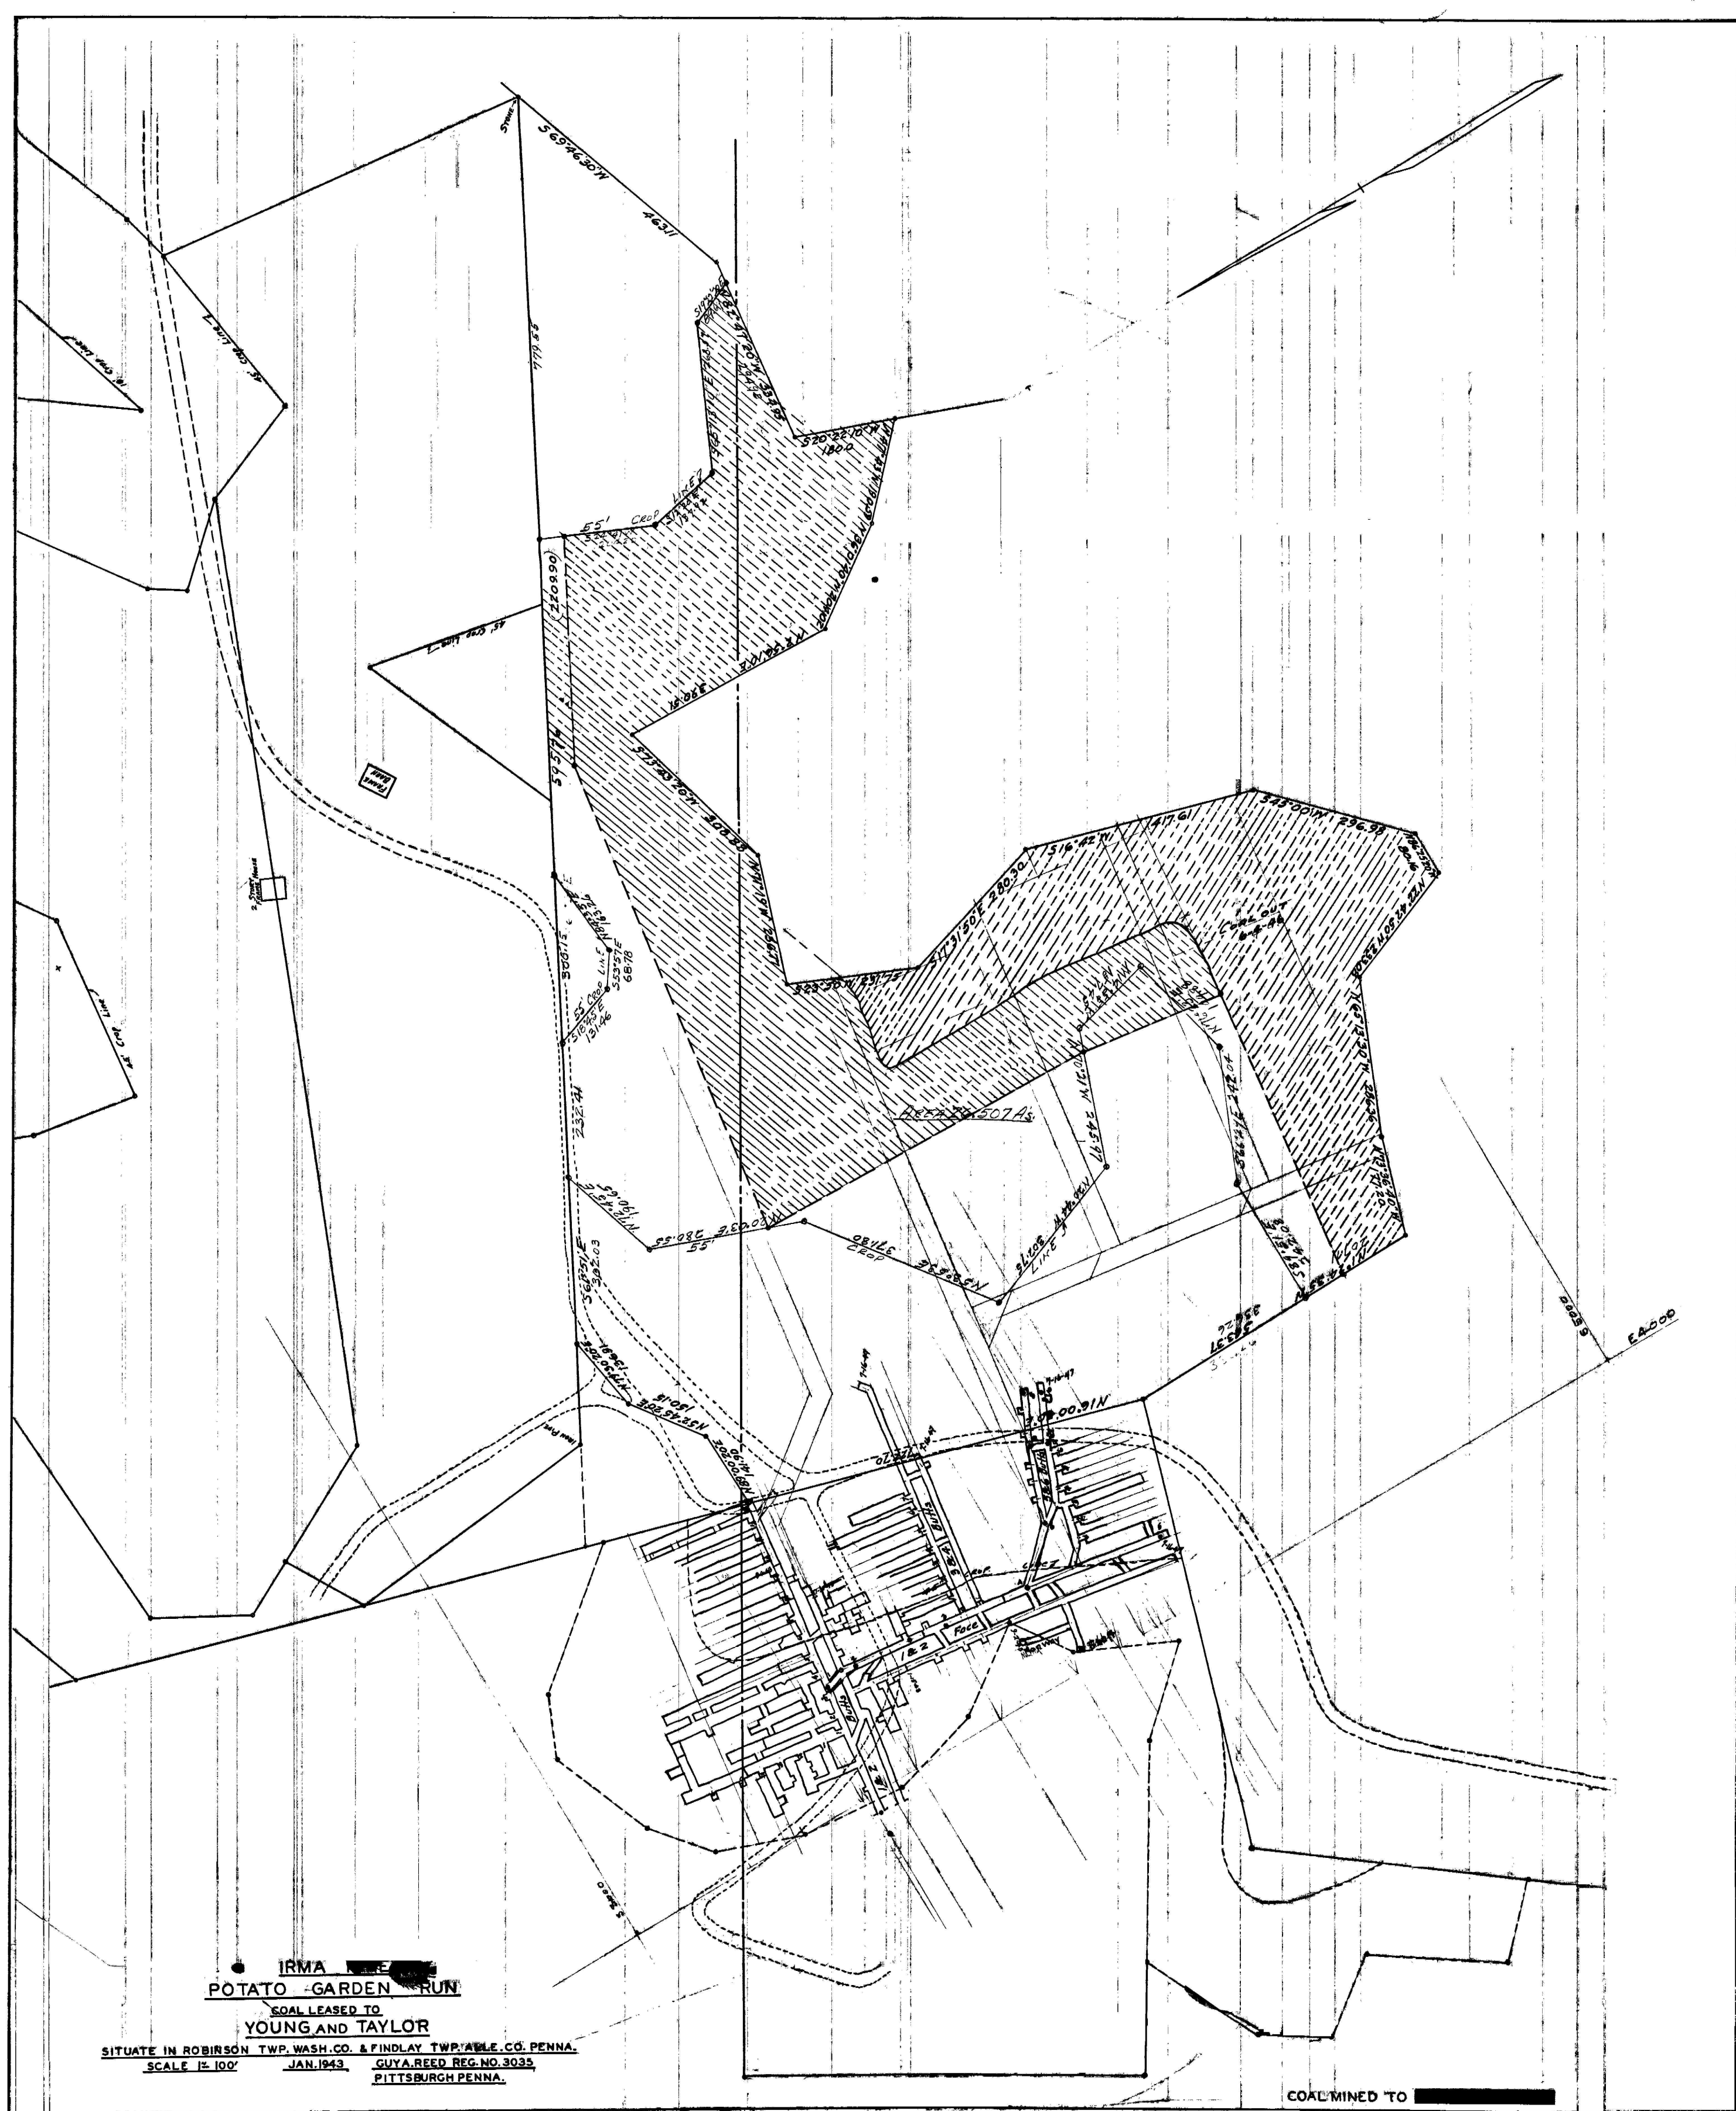

POTATO GARDEN RUN
COAL LEASED TO
YOUNG AND TAYLOR

SITUATE IN ROBINSON TWP., WASH. CO. & FINDLAY TWP., ALLE. CO., PENNA.
SCALE 1" = 100' JAN. 1943 GUYA REED REG. NO. 3035
PITTSBURGH PENNA.

COAL MINED TO