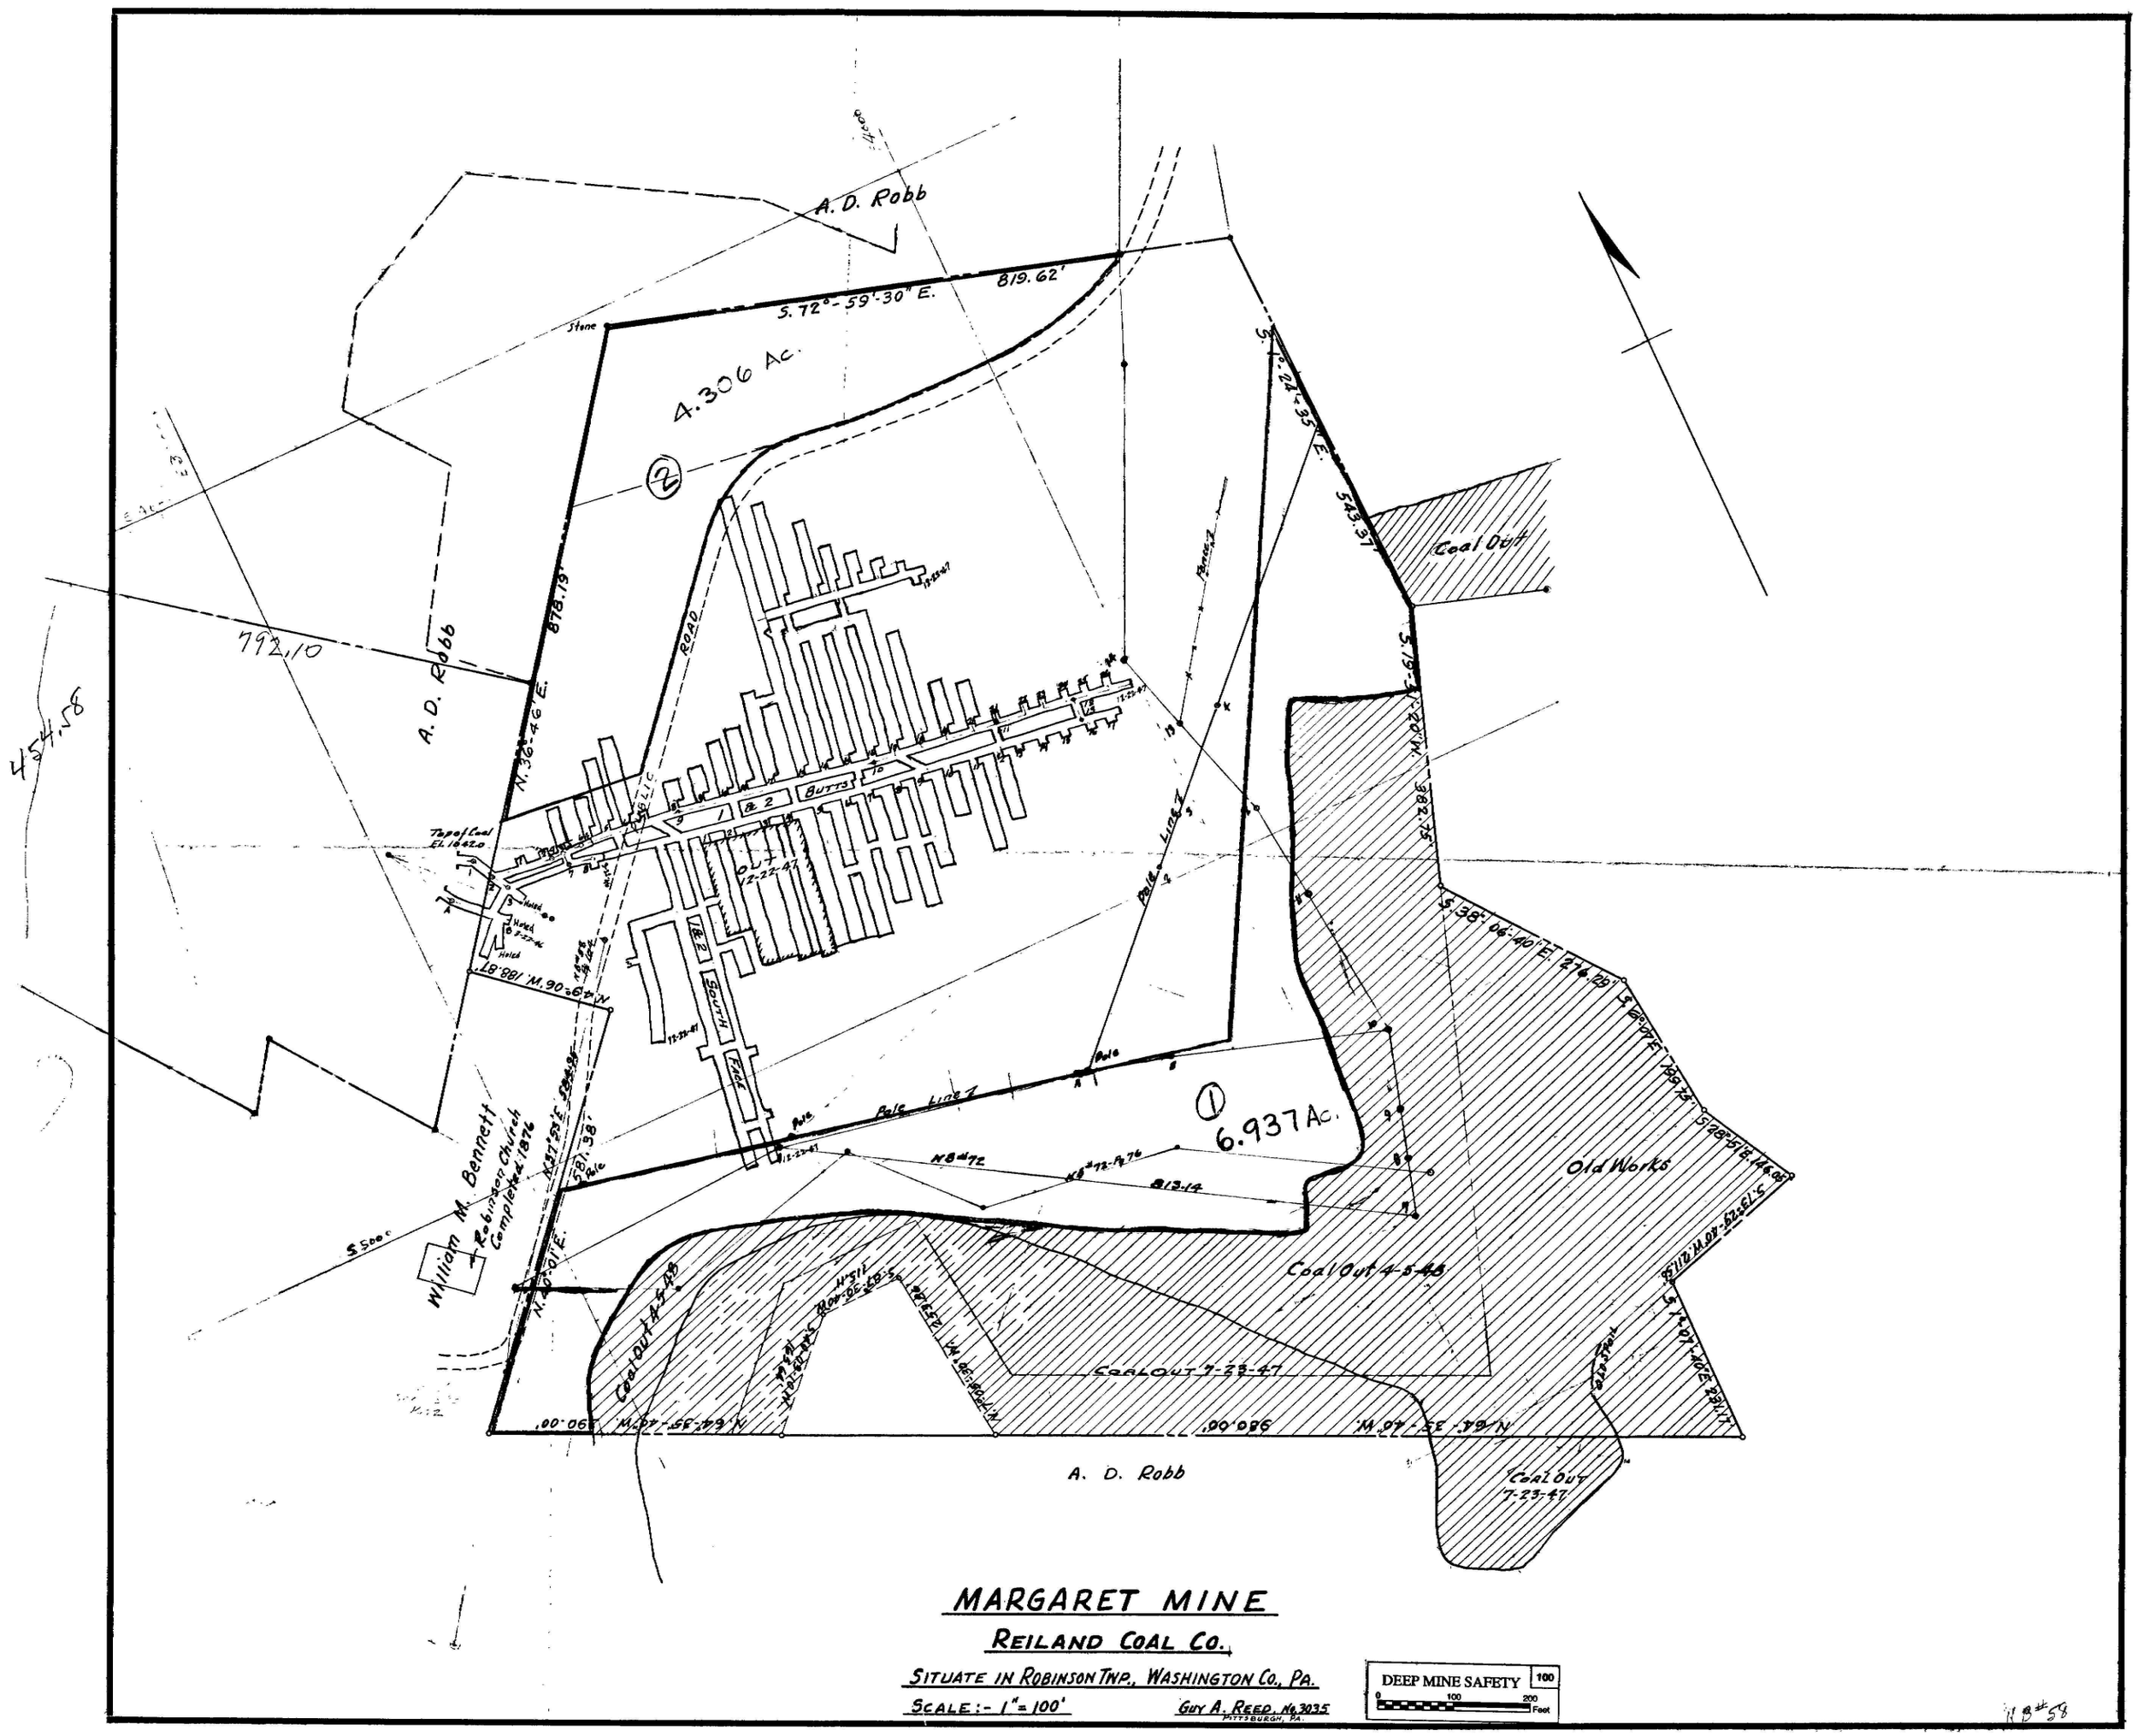

MARGARET MINE

REILAND COAL CO.

SITUATE IN ROBINSON TWP., WASHINGTON CO., PA.

SCALE:- 1" = 100'

GUY A. REED, No. 3035
PITTSBURGH, PA.

DEEP MINE SAFETY 100
0 100 200 Feet

#58