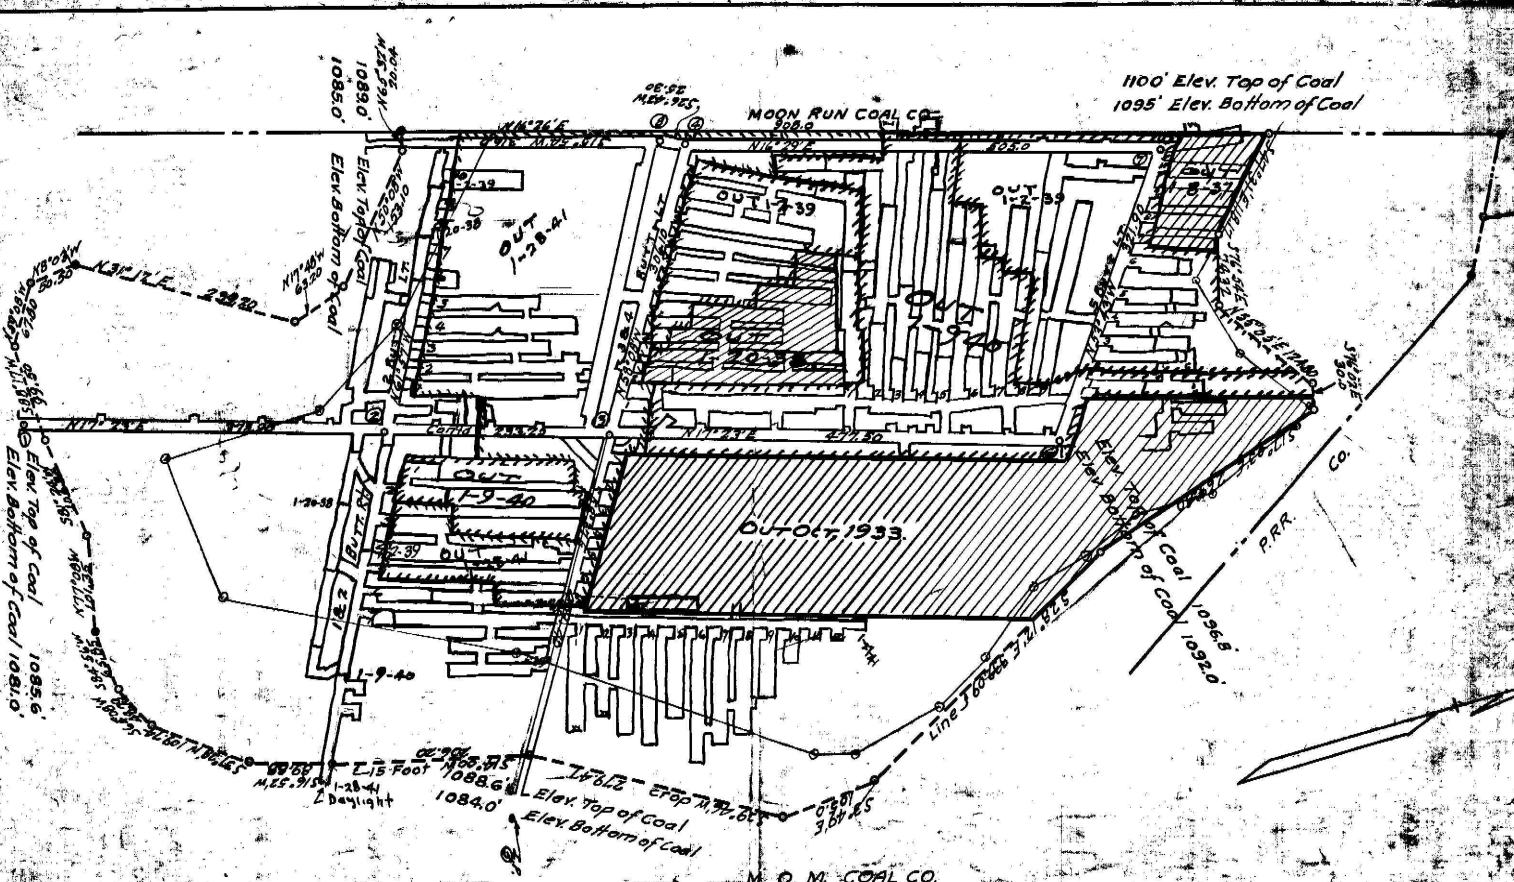
1100' Elev. Top of Coal
1095' Elev. Bottom of Coal
MOON RUN COAL CO.
OUT 1-2-39
OUT 1-2-39
OUT 1-28-41
OUT 1-9-40
OUT 1-9-40
OUT OCT. 1933
Elev. Top of Coal
Elev. Bottom of Coal
1085.0'
1080.0'
Elev. Top of Coal
Elev. Bottom of Coal
1085.6'
Elev. Top of Coal
Elev. Bottom of Coal 1081.0'
1088.6'
1084.0'
Elev. Top of Coal
Elev. Bottom of Coal
1096.8'
1092.0'
P.R.R. Co.
Line Jones
15 Foot
Daylight
M. O. M. COAL CO.
FORTWANGLER PROP.
Scale in Kennedy Twp. Allegh. Co. Pa.
Scale 1"=100' Jan. 1937 G.A. Reed - Pgh. Pa.