


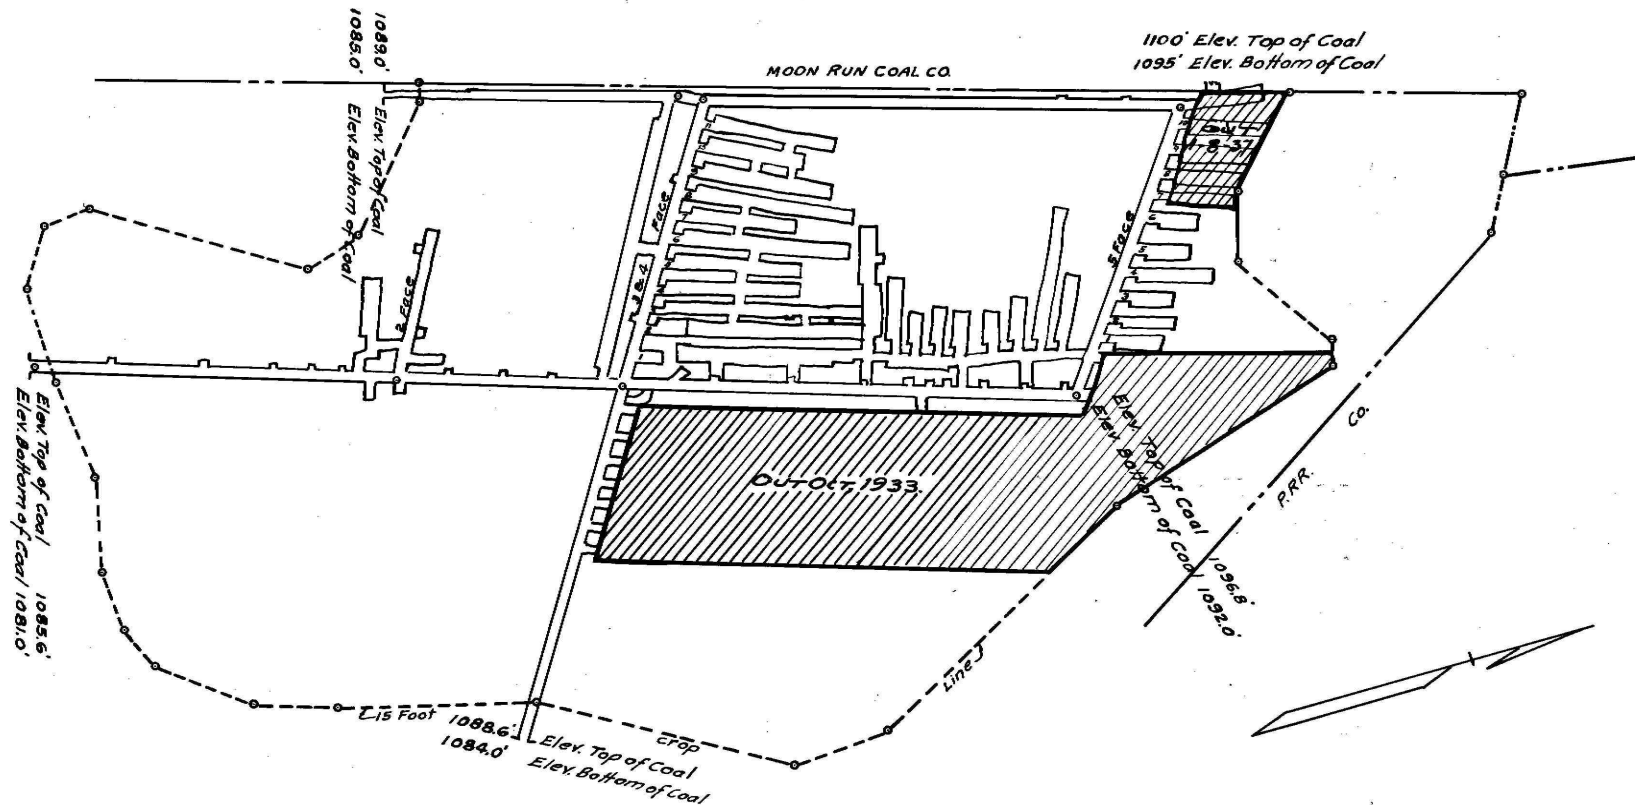

M. O. M. COAL CO.

FORT WANGLER PROP.

Situate in Kennedy Twp. Alle. Co. Pa.

Scale 1 1/2" = 100' Jan. 1937 G.A. Reed - Pgh., Pa.

Coal Mined