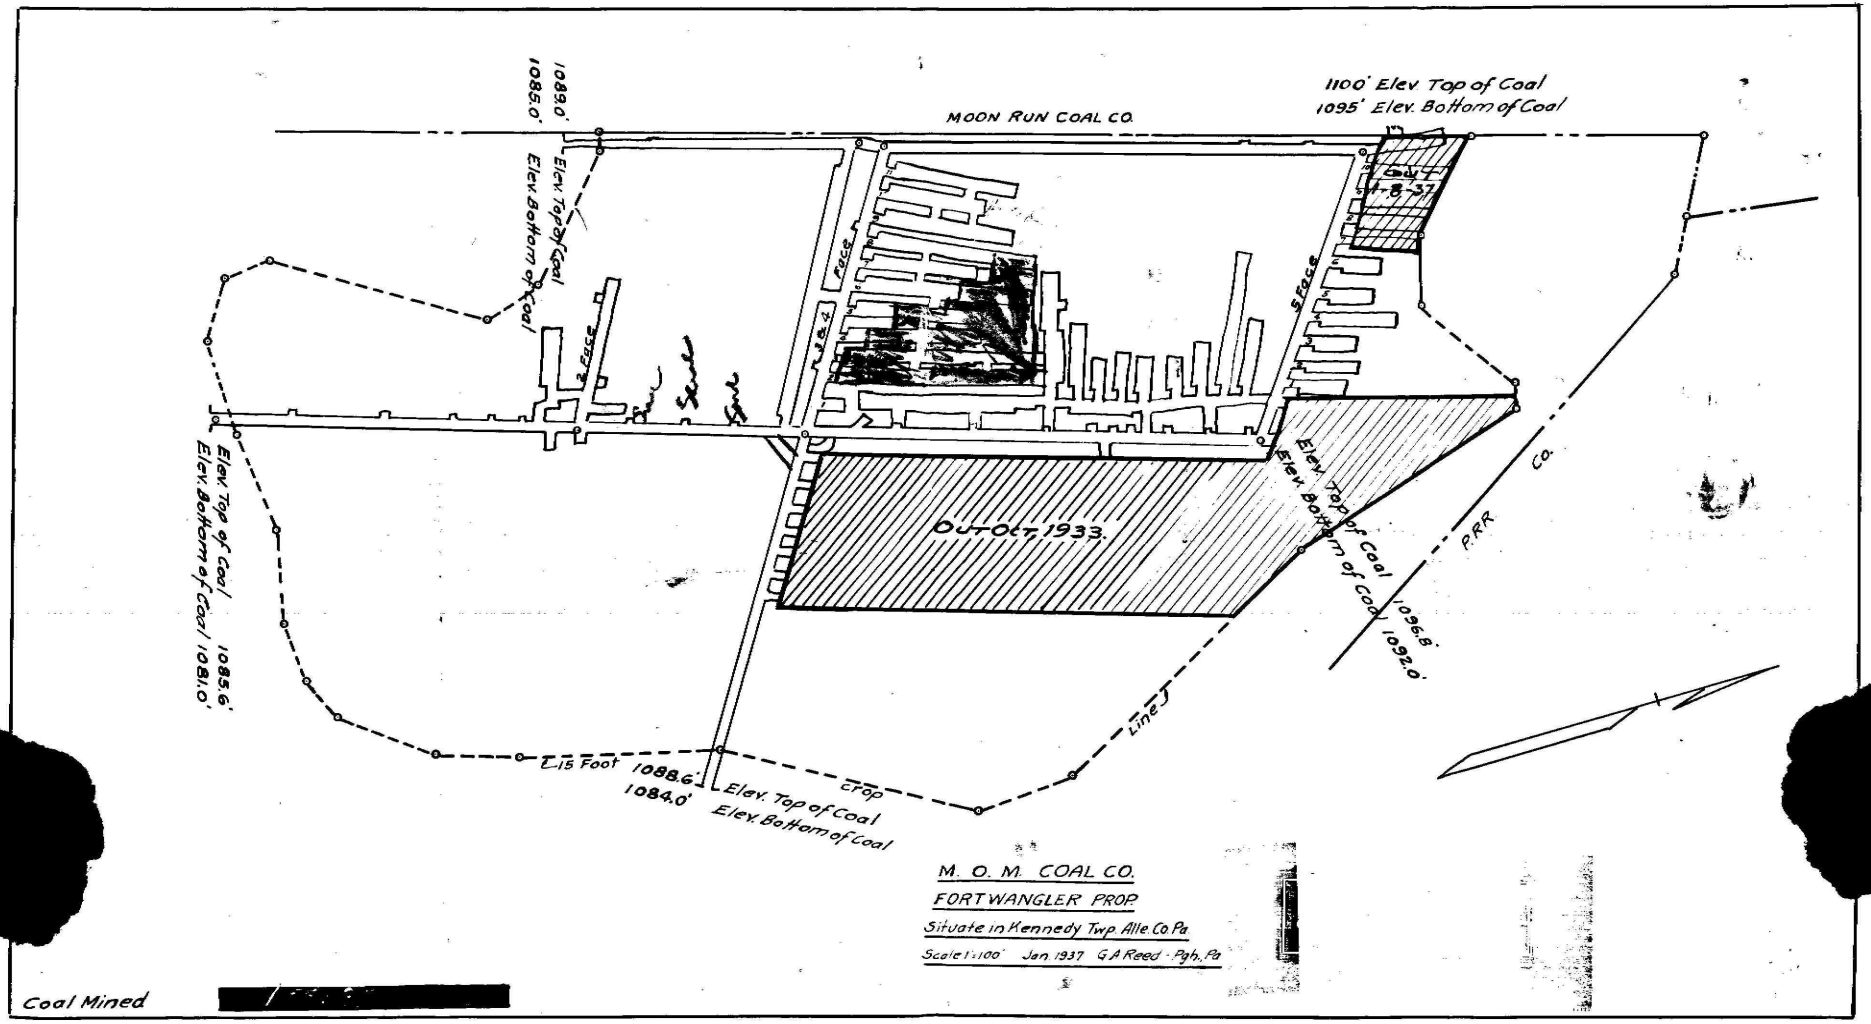
MOON RUN COAL CO.
1100' Elev Top of Coal
1095' Elev. Bottom of Coal
Out 1-8-37
1088.0'
Elev. Top of Coal
1085.0'
Elev. Bottom of Coal
S. FACE
N. FACE
S. FACE
Out-Oct, 1933.
Elev. Top of Coal
Elev. Bottom of Coal
1096.8'
1092.0'
P.R.R. Co.
Line J
Elev. Top of Coal
Elev. Bottom of Coal
1085.6'
1081.0'
Crop
15 Foot
1088.6'
1084.0'
Elev. Top of Coal
Elev. Bottom of Coal
M. O. M. COAL CO.
FORT WANGLER PROP.
Situate in Kennedy Twp. Alle. Co. Pa.
Scale 1"=100' Jan. 1937 G.A. Reed - Pgh., Pa.
Coal Mined