


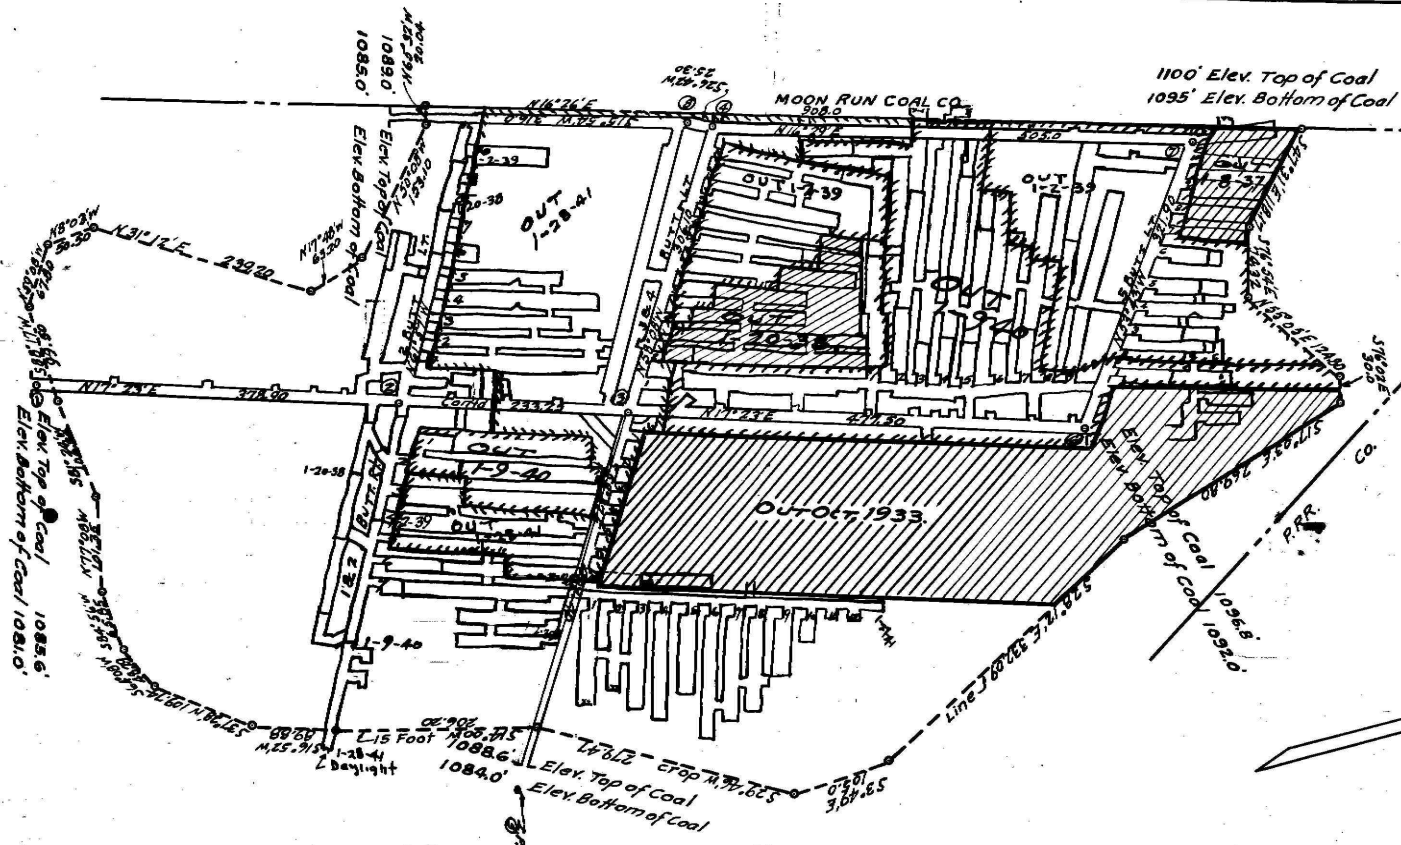

M. O. M. COAL CO.

FORT WANGLER PROP

Situate in Kennedy Twp. Alle. Co. Pa.

Scale 1"=100' Jan. 1937 G.A. Reed - Pgh. Pa.

Coal Mined

No. 84

N.B. 475, 3