
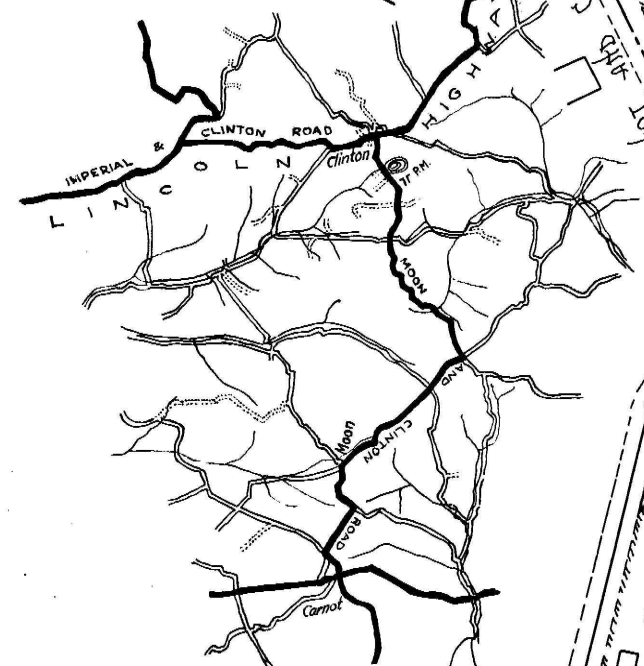



CLINTON BLOCK COAL CO.

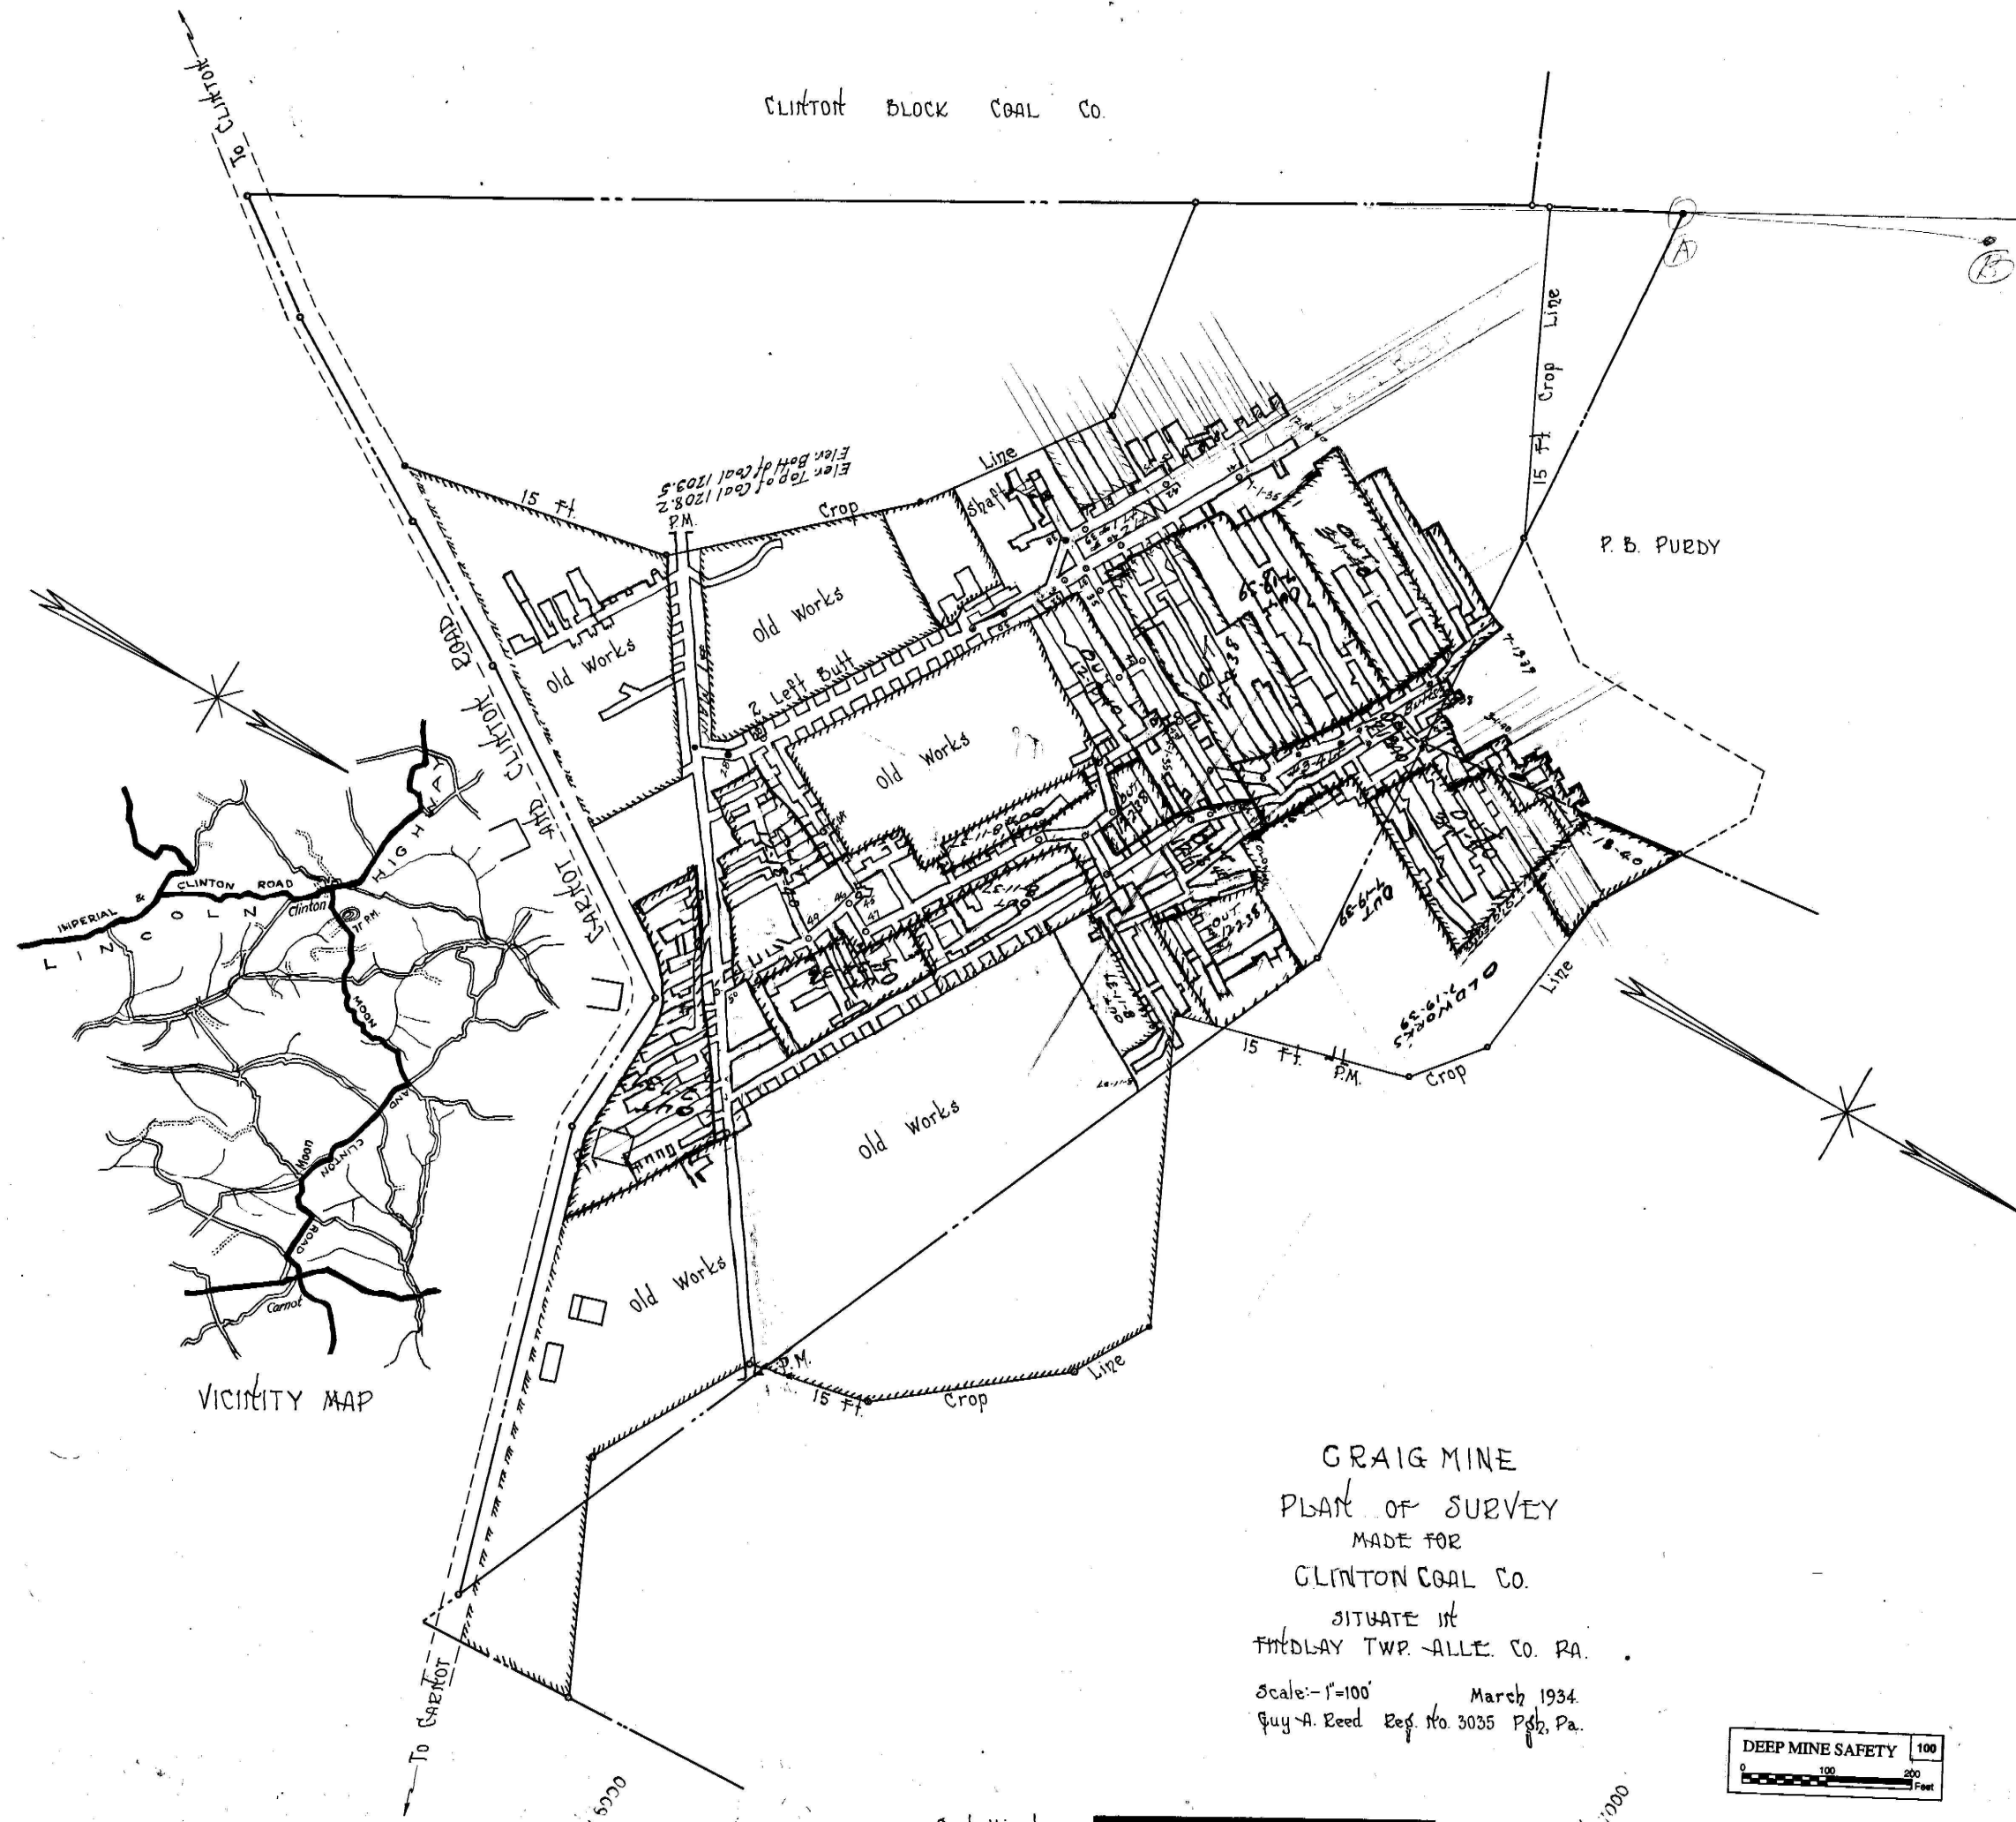

VICINITY MAP

GRAIG MINE
PLAN OF SURVEY
MADE FOR
CLINTON COAL CO.
SITUATE IN
FREDLAY TWP. ALLE. CO. PA.

Scale: 1"=100' March 1934
Guy A. Reed Reg. No. 3035 Pgs. Pa.

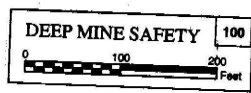

Coal Mined