


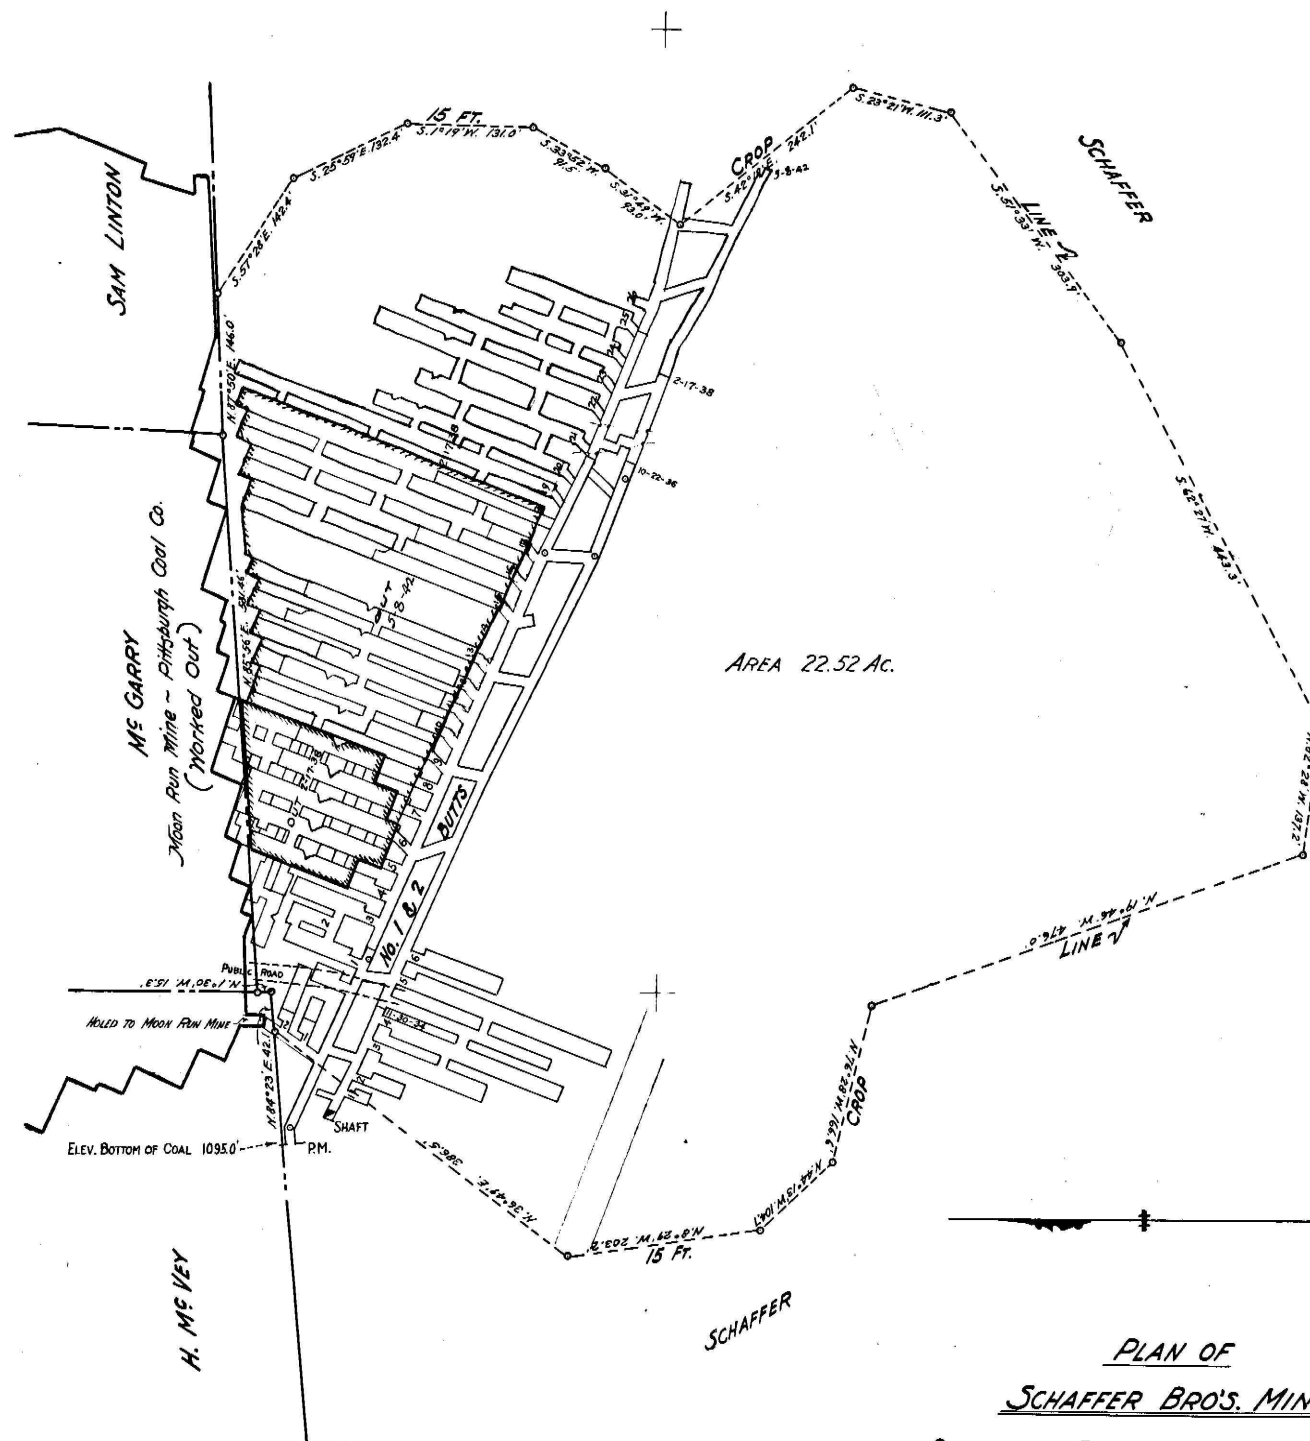

PLAN OF
SCHAFER BRO'S. MINE
SITUATE IN ROBINSON TWP.-ALTY. CO.-PA.
 SCALE 1"=100'
 OCT. 1936

GUY A. REED-REG. 3035
 PITTSBURGH - PENN.

GOAL MINED - 5-8-4-L