


N.B. 21-45

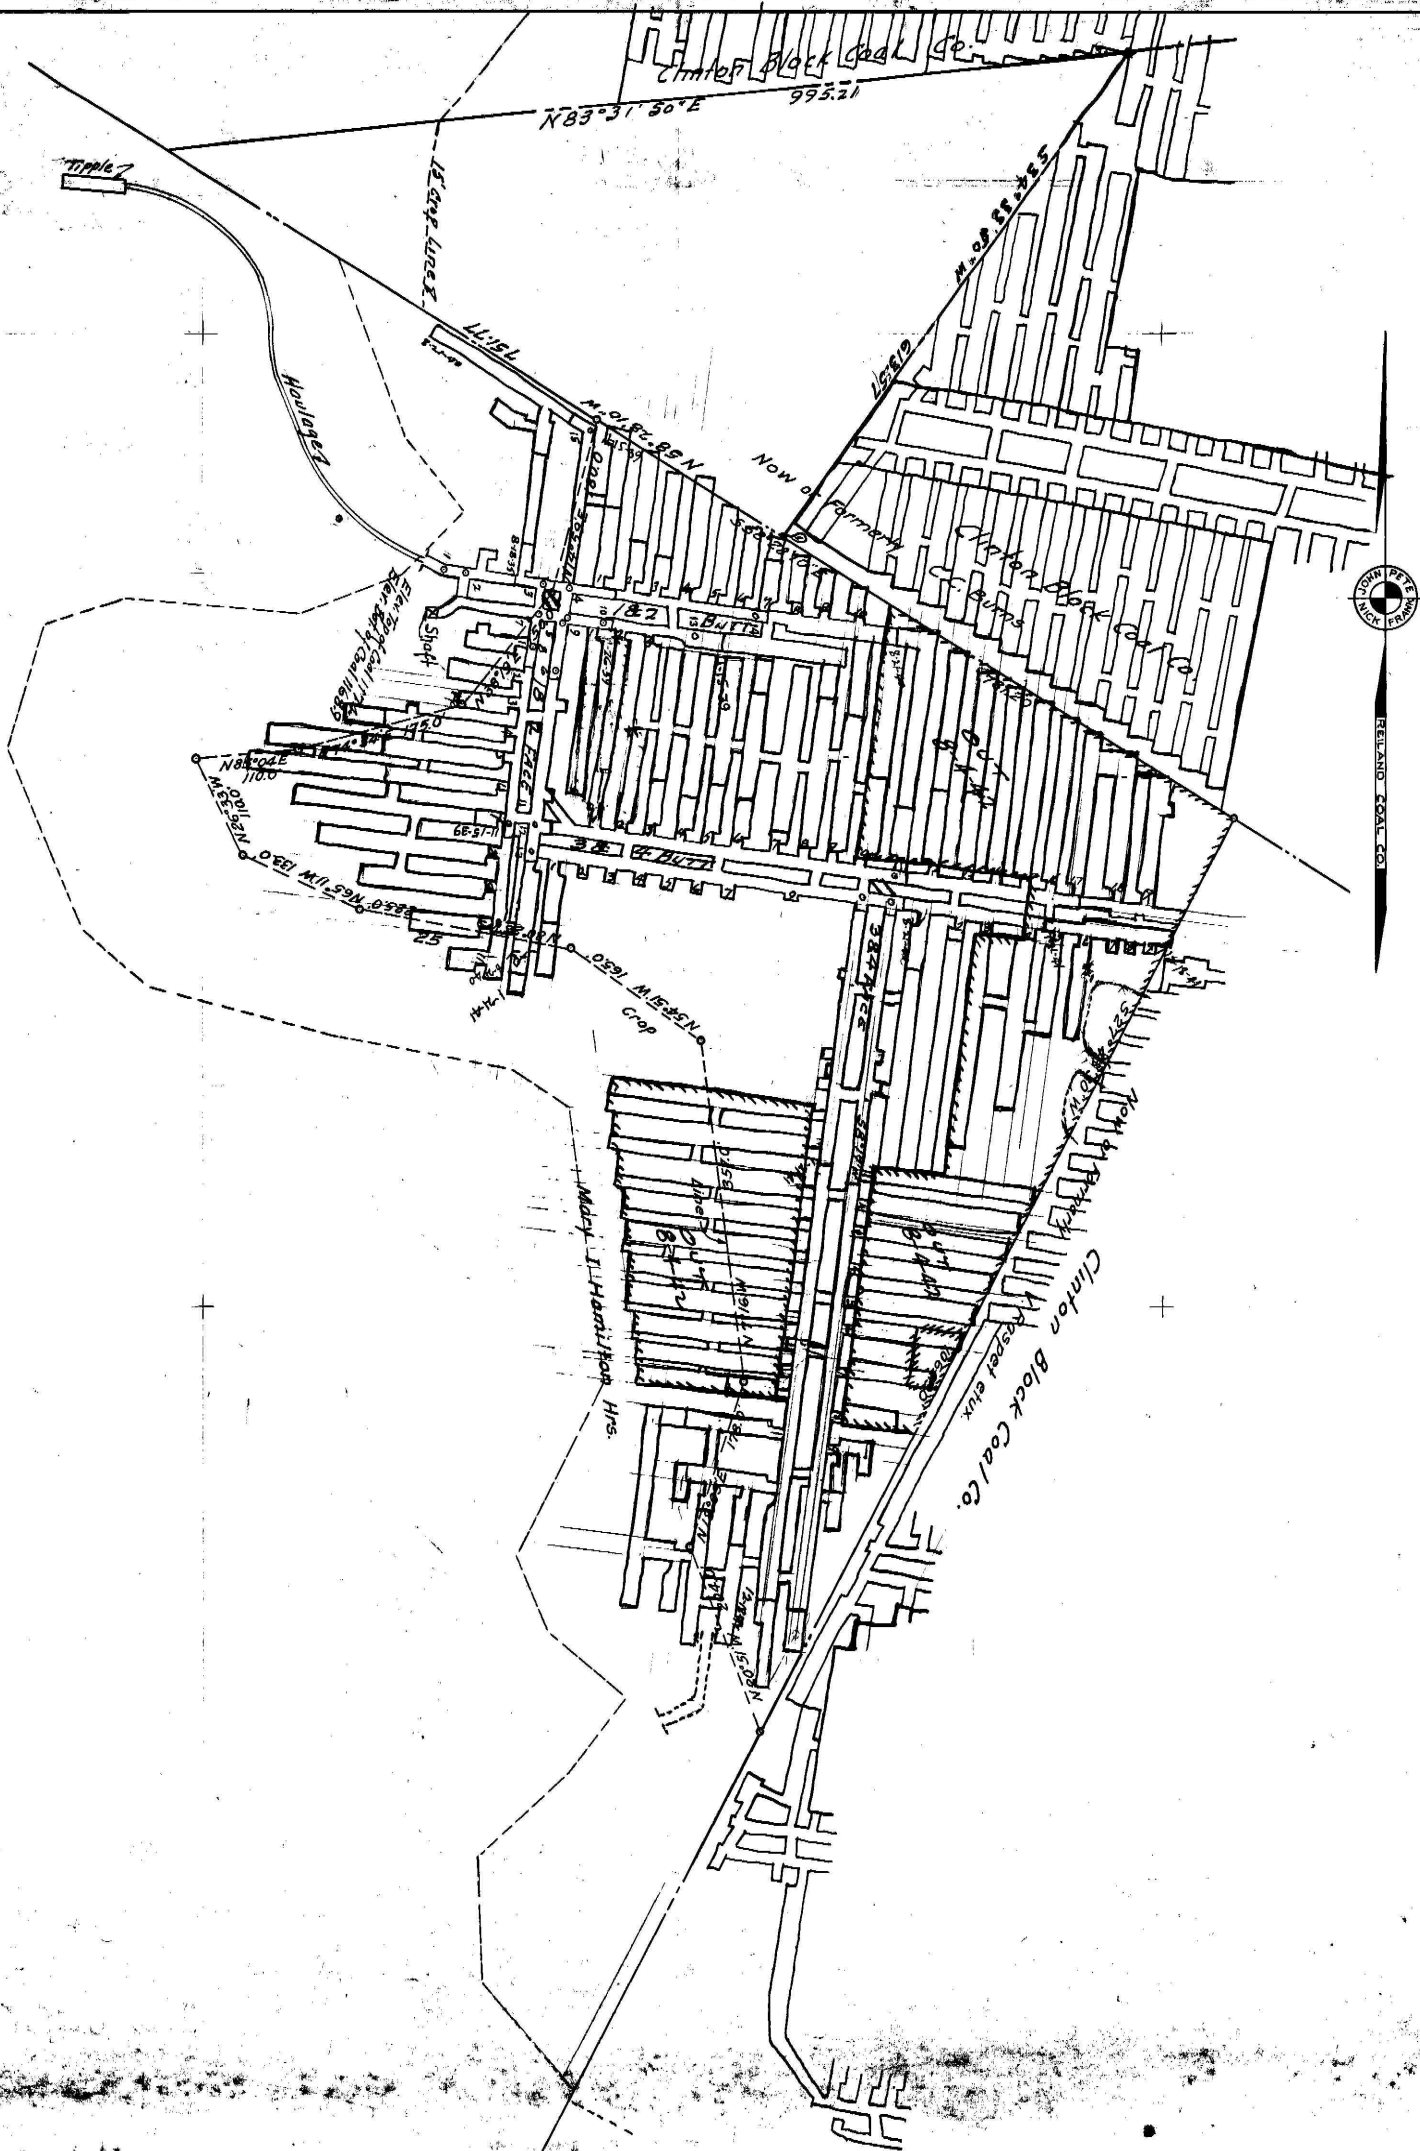

REILAND COAL CO.
MINE NO. 2
FINDLAY TWP. ALLE. CO. PA.
SCALE 1"-100' APRIL 1938 GUY A. REED