


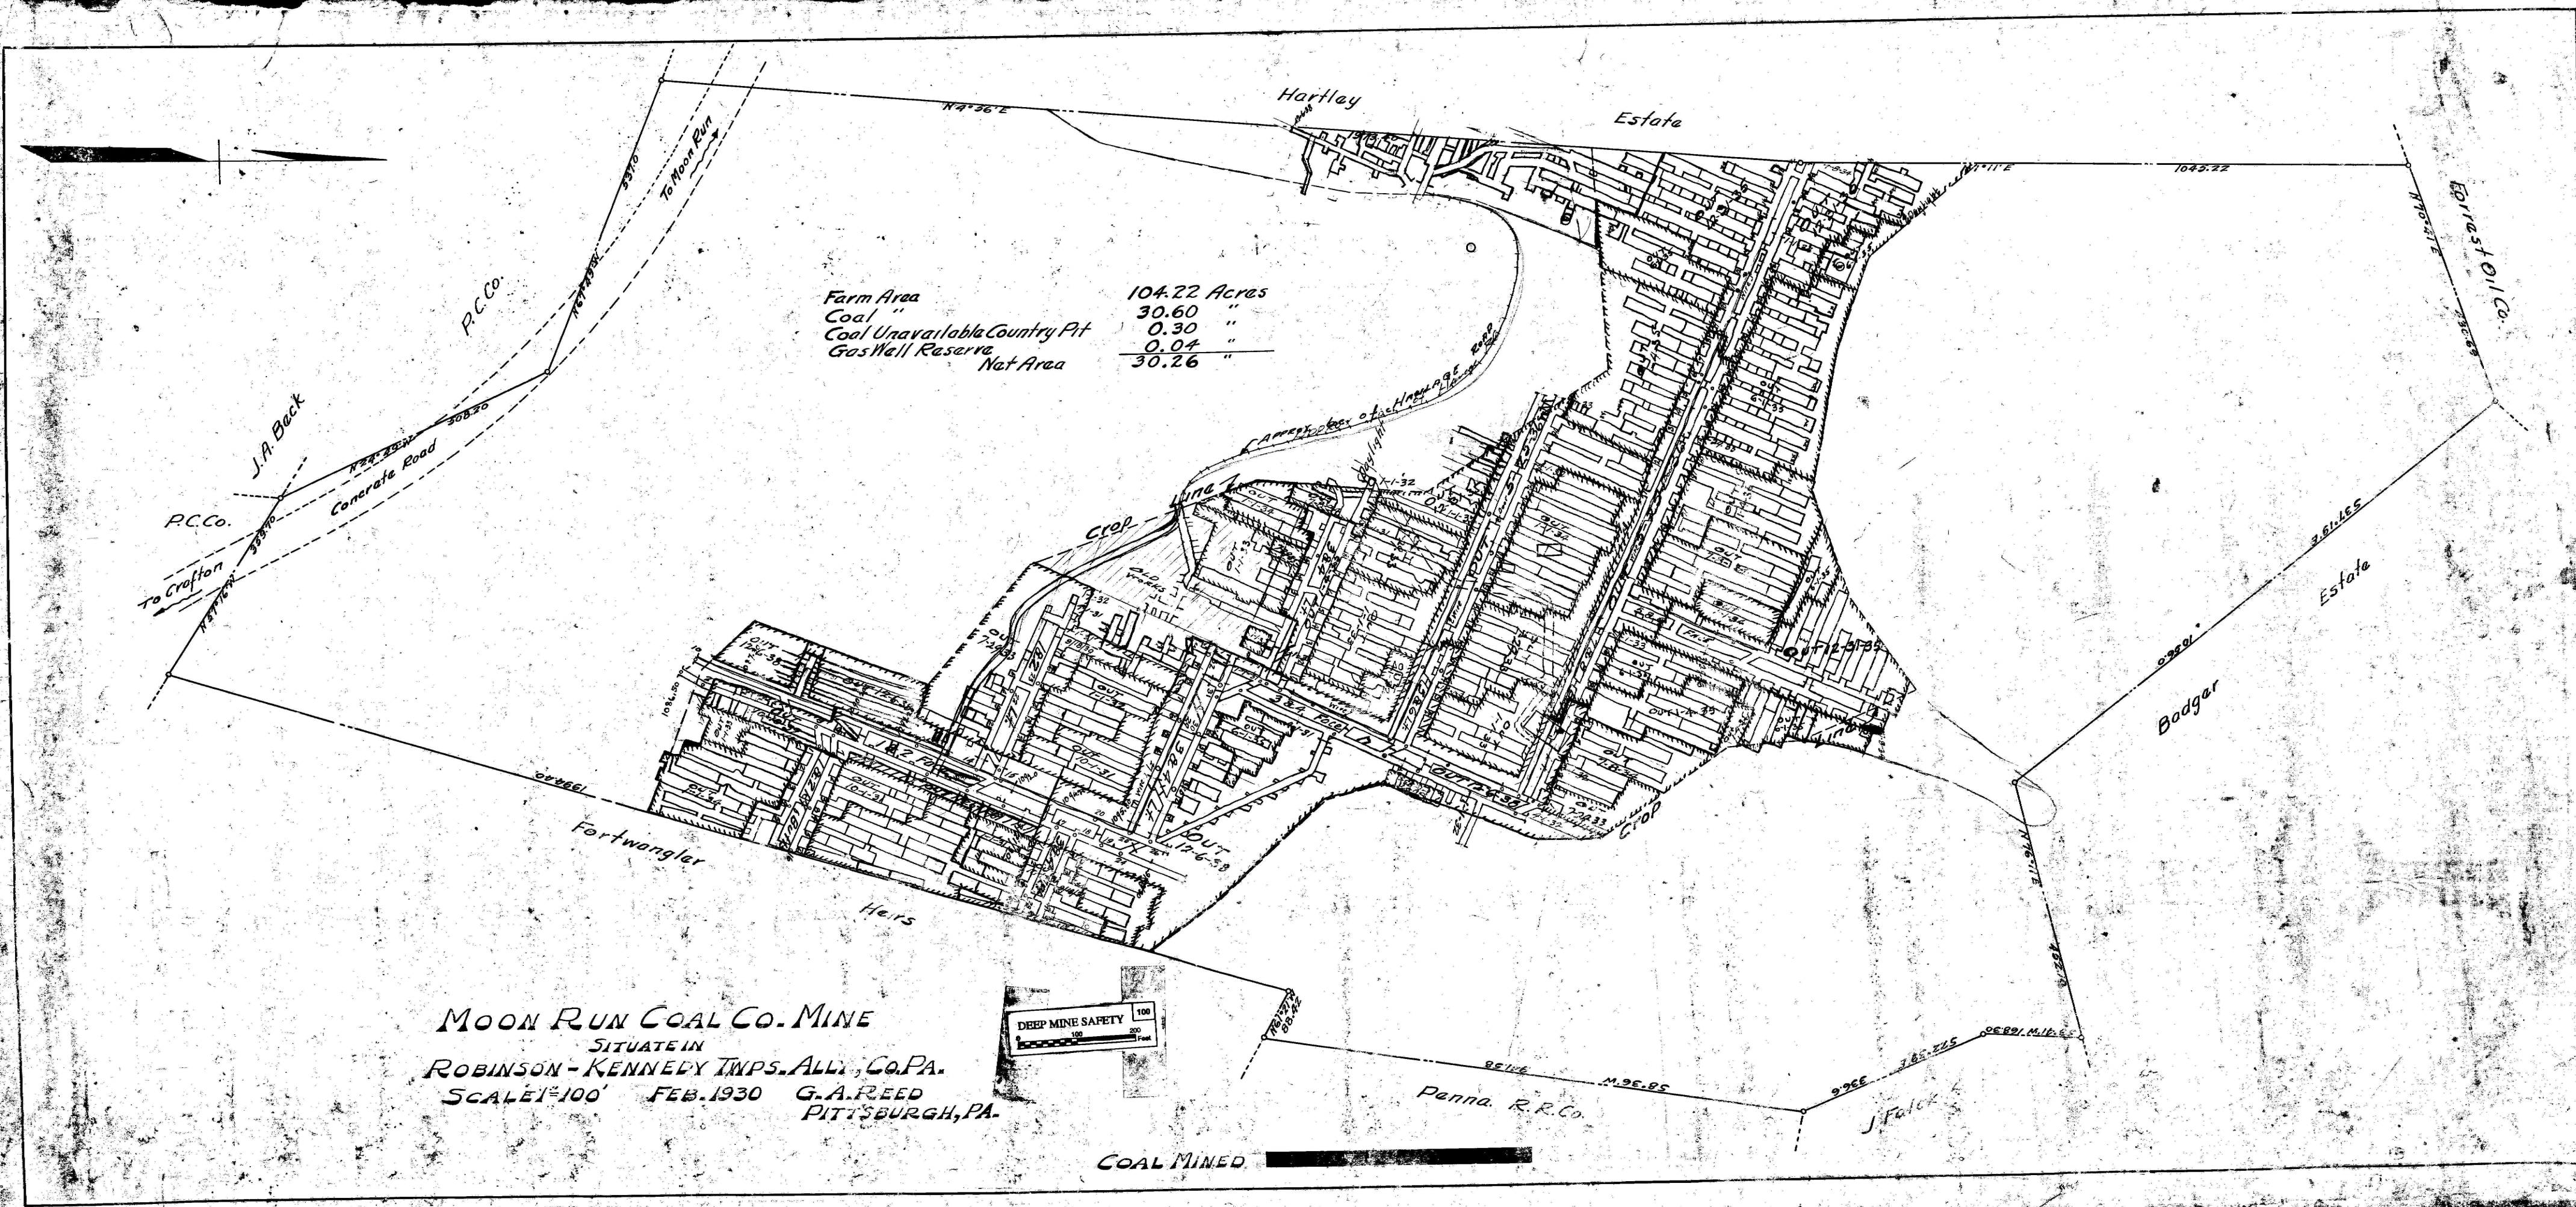

MOON RUN COAL CO. MINE
SITUATE IN
ROBINSON - KENNEDY TOWNSHIP, ALLEGANY CO., PA.
SCALE 1"=100' FEB. 1930 G.A. REED
PITTSBURGH, PA.

COAL MINED