


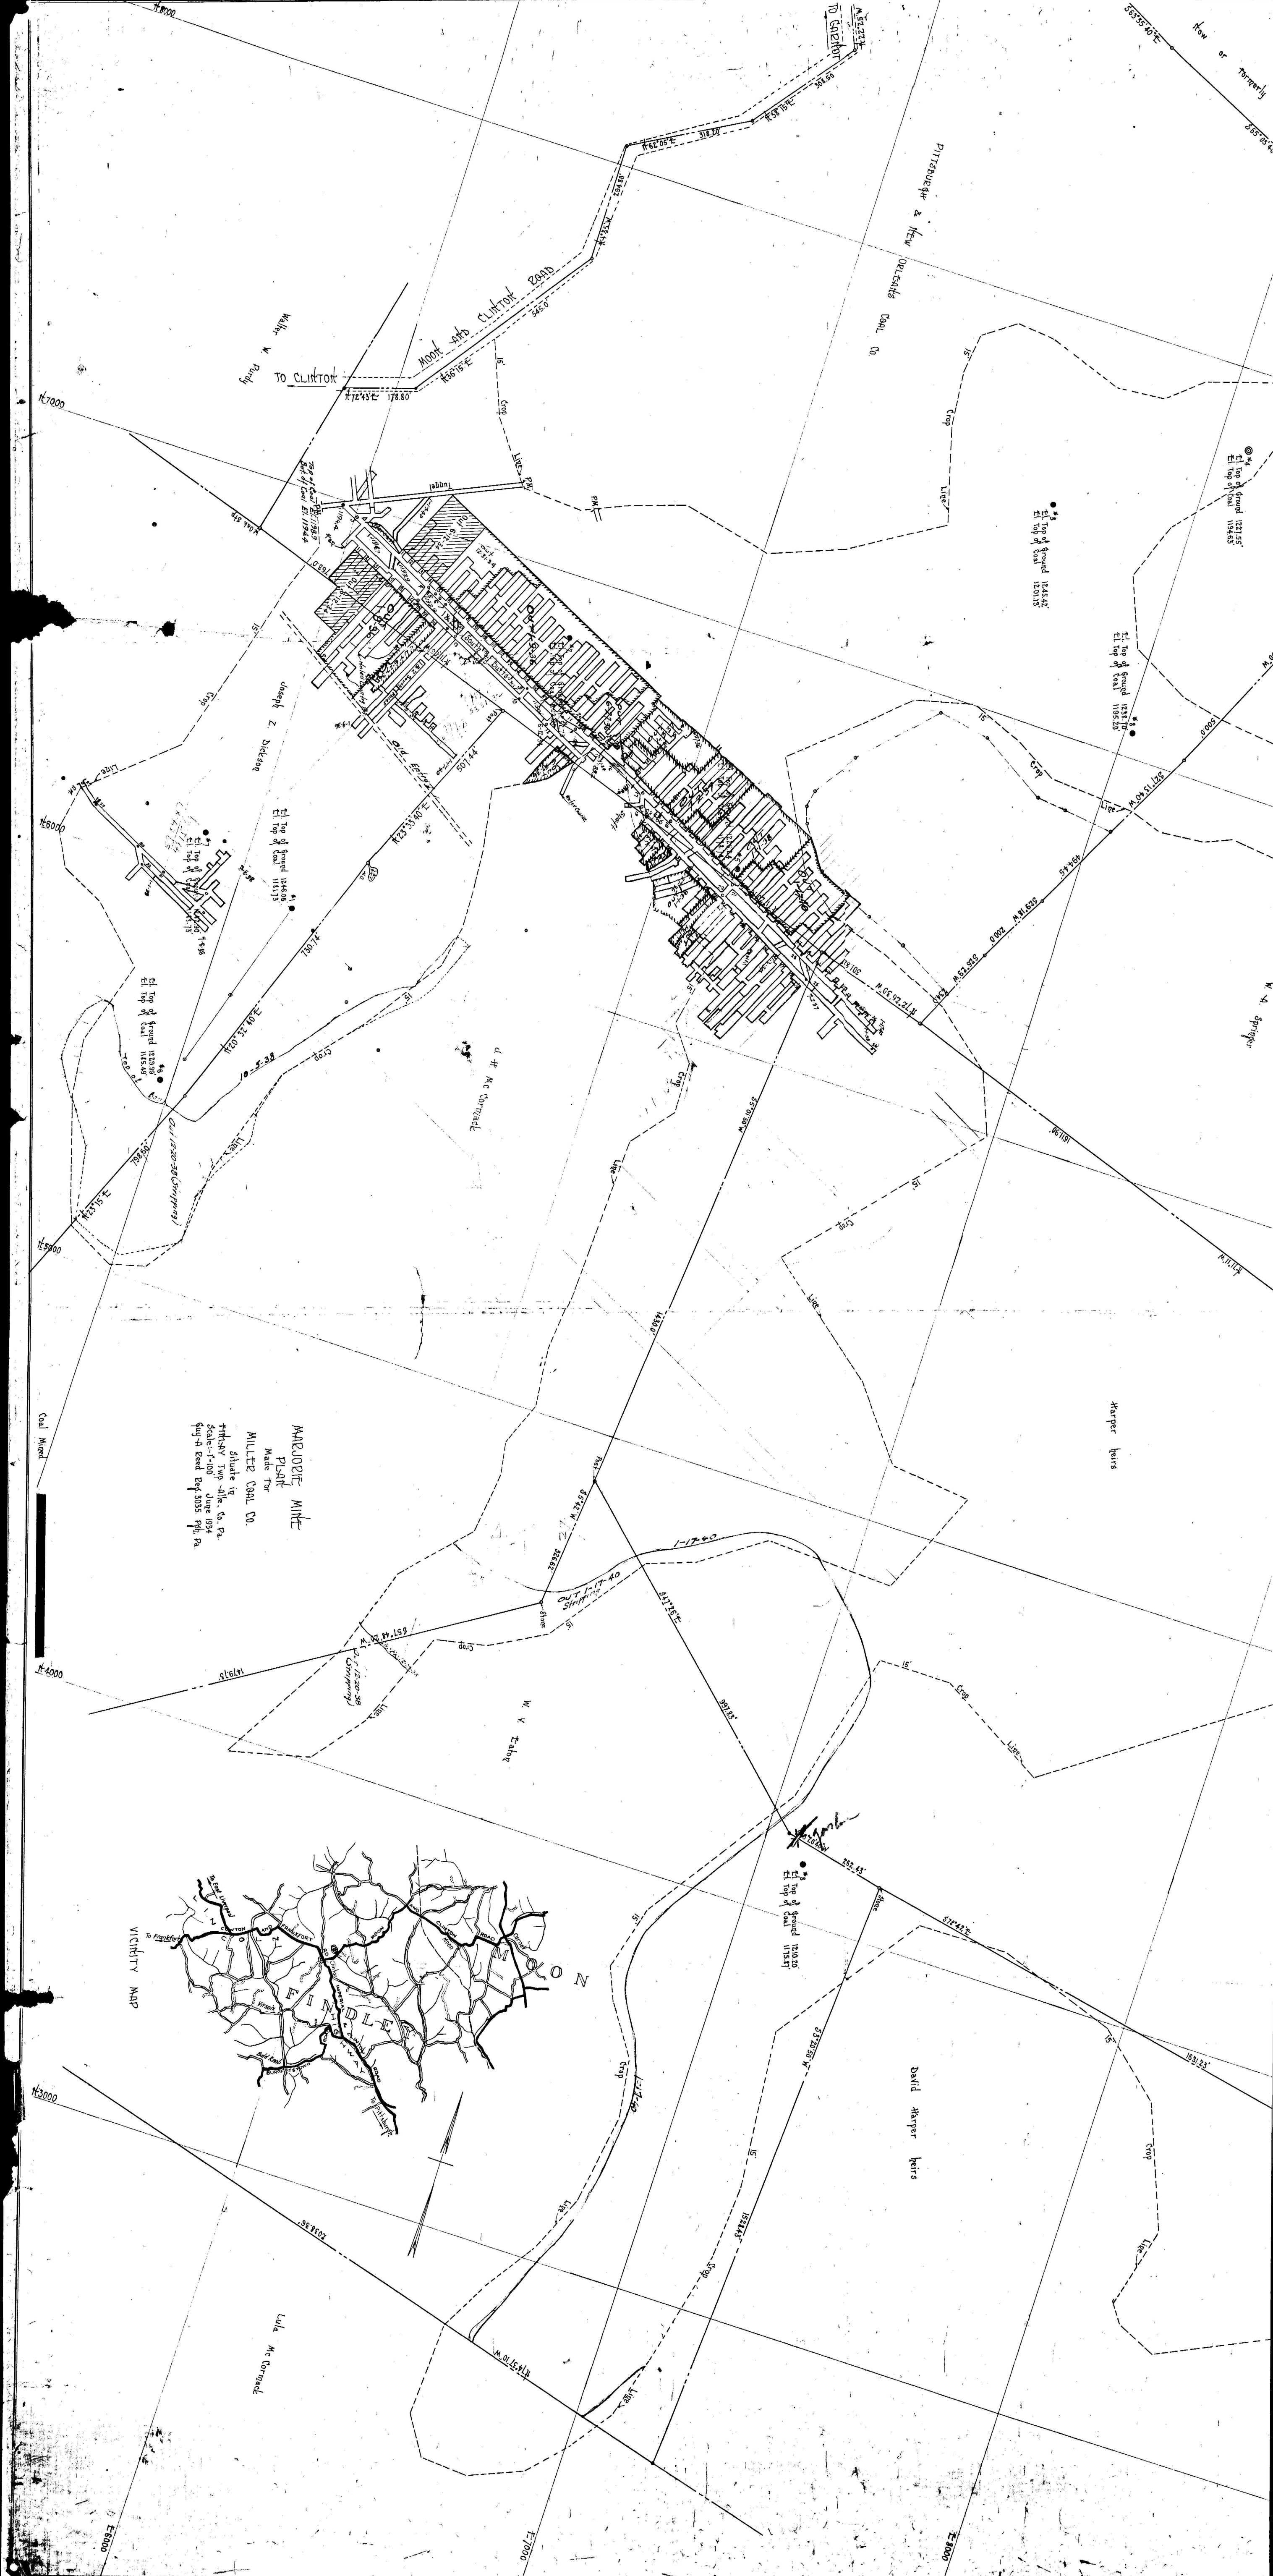

MARJORIE MINE
PLANT
Made for
MILLED COAL CO.

