


ABANDONED WELLS .....  
 PUMPS .....  
 GAS WELLS .....  
 D.D. HOLES .....

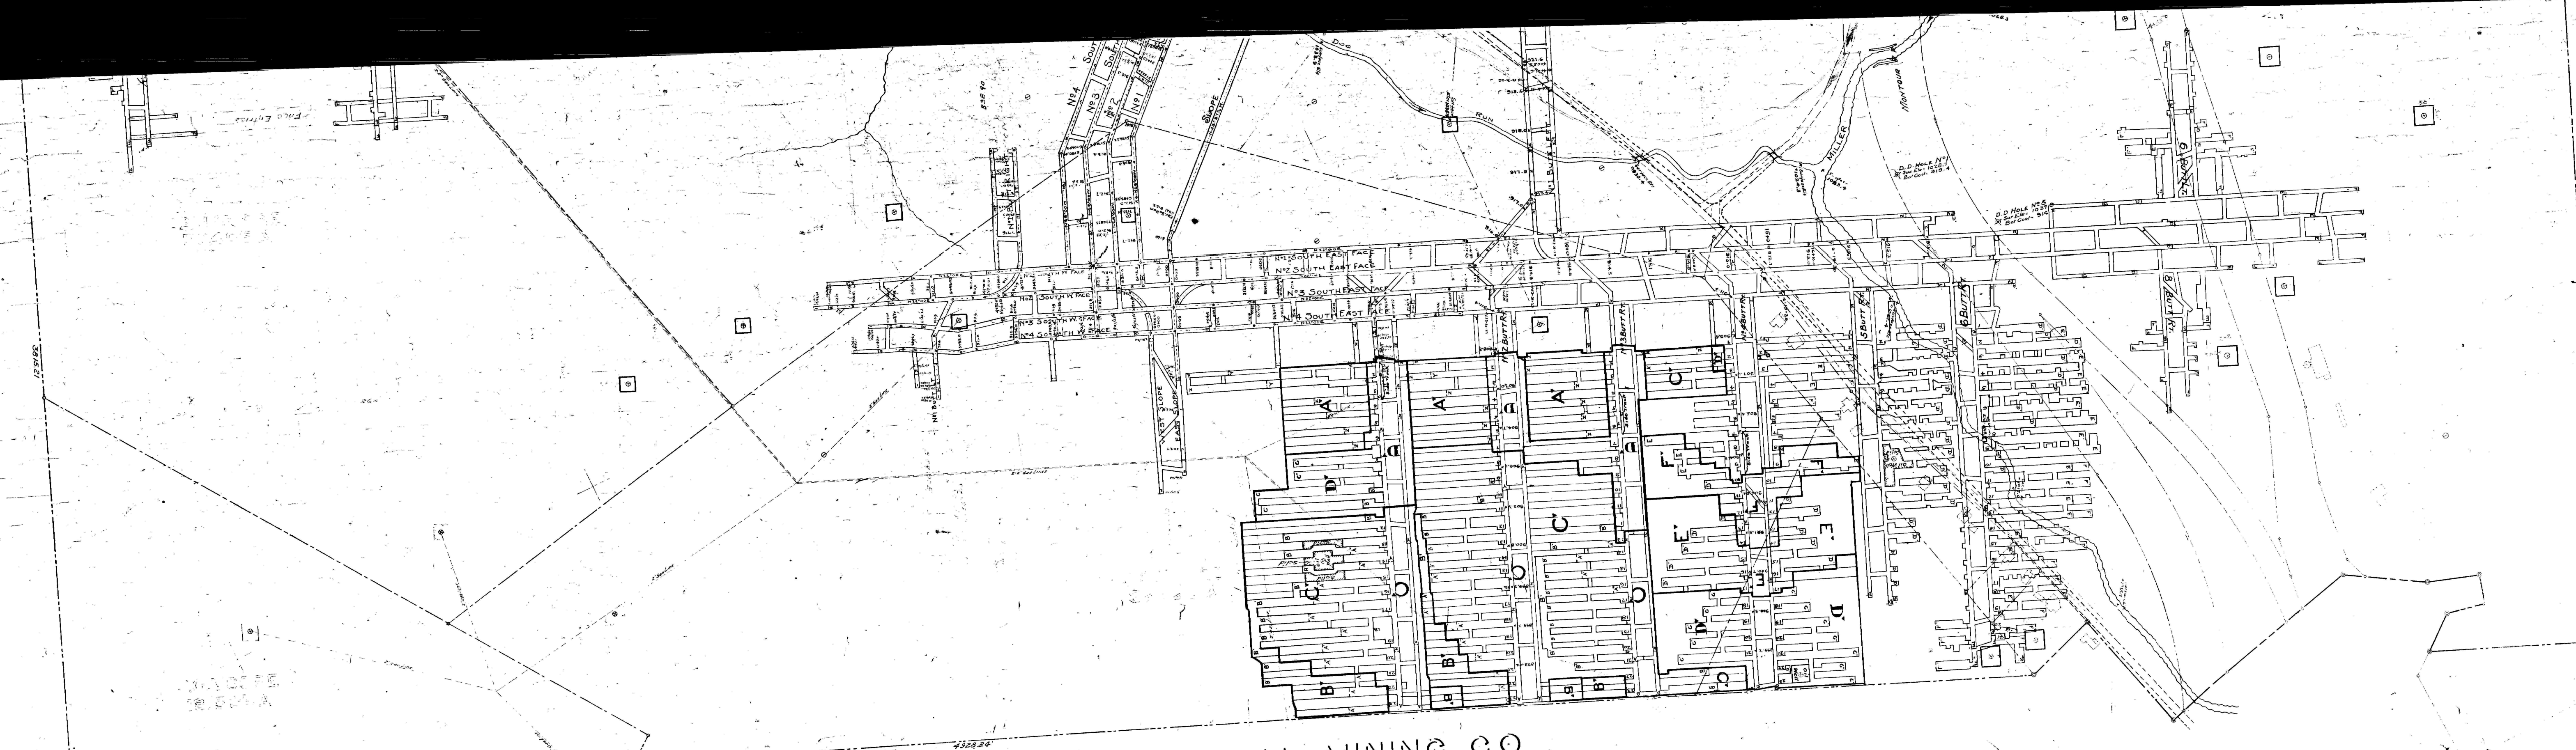

GILMORE COAL MINING CO  
 MORRIS MINE  
 SITUATE IN  
 CECIL & MT. PLEASANT TWPS.  
 WASHINGTON COUNTY, PA.  
 Scale 1 inch = 100 Feet Jan. 19, 1923